



**BLACK HAWK COUNTY
SOLID WASTE MANAGEMENT COMMISSION**

**REQUEST FOR DESIGN-BUILD PROPOSALS
FOR
THE BLACK HAWK COUNTY LANDFILL
SCALE HOUSE MODIFICATION AND SCALE REPLACEMENT
PROJECT**

Submittal Deadline:

10:00 AM – January 18, 2025

Table of Contents

Notice to Bidders.....	Page 3
Section 1. Project Introduction.....	Page 5
Section 2. Project Description.....	Page 5
Section 3. Project Schedule.....	Page 6
Section 4. Scope of Work.....	Page 6
Responsibilities of Contractor.....	Page 7
Progress Payments.....	Page 7
Scoping and Pre-Construction Meetings.....	Page 7
Design Requirements.....	Page 7
Construction Requirements.....	Page 8
Project Close Out.....	Page 8
Section 5. Pre-Proposal Meeting.....	Page 9
Section 6. Addendum.....	Page 9
Section 7. Proposal Response Requirements.....	Page 10
Section 8. Selection Process.....	Page 11

Attachment A. As-Built Conditions

1. Scale Improvement Construction Drawings, May 2008, AECOM
2. Scale and Access Road Improvements Construction Drawings, June 2006, AECOM
3. Sale and Small Loads Facility Construction Drawings, April 1995, AECOM

Attachment B. Specifications for Vehicle Scales

Attachment C. Schedule B - Contractor Insurance Specification

Attachment D. Proposal Forms

Attachment E. Draft Performance, Payment, and Maintenance Bond

Electronic Copies of this RFP are available at Wastetrac.org/

**NOTICE TO BIDDERS
BLACK HAWK COUNTY SOLID WASTE MANAGEMENT COMMISSION
PUBLIC IMPROVEMENT PROJECT**

**DESIGN-BUILD SERVICES FOR THE
LANDFILL SCALE HOUSE MODIFICATION AND SCALE REPLACEMENT**

Time and Place for Filing Sealed Proposals. Sealed bids for the work comprising each improvement, as stated below, must be filed before 10:00 a.m. January 21, 2025, at the reception desk of the Iowa Northern Region Council of Governments (INRCOG), 229 East Park Ave., Waterloo, Iowa, 50703

Time and Place Sealed Proposals Will be Opened and Considered. Sealed proposals will be opened, and bids tabulated at 10:00 a.m. on January 21, 2025, in the INRCOG Board Room, Third Floor, 229 East Park Avenue, Waterloo, Iowa, 50703.

A Public Hearing will be held on the Plans and Specifications and proposed Form of Contract at 10:00 a.m. on December 19, 2025, at the City Council Chambers at City Hall, 715 Mulberry Street, Waterloo, Iowa, 50703.

A Regular Meeting of the Commission will be held at 10:00 a.m. on January 23, 2025, where Bid Proposals will be acted upon at that time or at such time as may then be fixed.

Time for Commencement and Completion of Work. Work on each improvement shall be commenced within 10 days after the Notice to Proceed has been issued.

Bid Security. Each bidder shall accompany its bid with bid security as security that the successful bidder will enter into a contract for the work bid upon and will furnish after the award of the contract a corporate surety bond, acceptable to the governmental entity, for the faithful performance of the contract, in an amount equal to one hundred percent of the amount of the contract. The bid security shall be in the amount of ten percent (10%) of the amount of the contract. It shall be in the form of a cashier's check or certified check drawn on a state-chartered or federally chartered bank, or an accredited share draft drawn on a state-chartered or federally chartered credit union, or the governmental entity may provide for a bidder's bond with corporate surety satisfactory to the governmental entity. The bid bond shall contain no conditions except as provided in this section.

Construction Schedule. Each bidder shall accompany its bid with a Construction Schedule.

Contract Documents. Complete digital project bidding documents are available at www.wastetrac.org and at www.questcdn.com. You may download the digital plan documents by inputting Quest project #**9456491** on the website's Project Search page. Please contact Questcdn.com at 952-233-1632 or info@questcdn.com for assistance in free membership registration, downloading, and working with this digital project information.

The Bidding Documents are on file for inspection at the Reception Desk of the Iowa Northland Regional Council of Governments (INRCOG), 229 East Park Avenue, Waterloo, Iowa, 50703.

Preference for Iowa Products and Labor. By virtue of statutory authority, preference will be given to products and provisions grown and coal produced within the State of Iowa and to Iowa domestic labor to the extent lawfully required under Iowa statutes.

Sales Tax. The bidder should not include sales tax in its bid. A sales tax exemption certificate will be available for all materials purchased for incorporation into the Project.

General Nature of Public Improvement. This contract comprises design-build services for modifying the Black Hawk County Landfill's scale house and replacing the outbound truck scale.

The BASE BID shall include the design of a scale house remodel utilizing the existing footprint to meet project goals, the removal and disposal of the existing scale, the procurement and installation of a 70-ft long, 14-ft wide concrete platform, pit-less motor scale, and associated concrete foundation and approach work, and the configuration of the new scale with the existing WasteWORKS system.

ALTERNATE BID PACKAGE shall include the base bid, removing the remodel portion, substituting with the demolition, and constructing an addition to the scale house.

Prospective bidders are required to bid on ALL packages. After the bid opening, the OWNER will decide which package to pursue.

Pre-Proposal Meeting. Each prospective bidder is encouraged to attend the Pre-Bid Construction Conference, held at 10:00 on January 06, 2025, at the Landfill Shop, Black Hawk County Sanitary Landfill, 1509 East Washburn Road, Waterloo, Iowa 50701. Attendance by all prospective bidders is not mandatory but highly recommended.

On the following date, December 10, 2025, this Notice was posted at the following locations:

1. Master Builders service.
2. Qwest CDN construction lead generating service.
3. The BHCSWMC Website. <http://wastetrac.org/>

**REQUEST FOR PROPOSALS
FOR DESIGN-BUILD PROPOSALS FOR
THE BLACK HAWK COUNTY LANDFILL SCALE HOUSE REMODEL AND
SCALE REPLACEMENT PROJECT**

1. INTRODUCTION

The Black Hawk County Solid Waste Management Commission (Commission or Owner) is issuing this Request for Proposals (RFP) to solicit proposals from experienced Contractors to design and modify the existing Scale house and remove and replace an existing truck scale. Qualified Contractors are invited to submit a proposal in the format outlined in this RFP.

The Commission is an inter-governmental agency organized under Iowa Code Chapter 28E and overseen by a five (5) member Board. Membership consists of the Cities within and the County of Black Hawk, Iowa. The Commission's charge is to manage solid waste generated within its service area, which includes the municipalities and the rural population within Black Hawk County. The Commission owns and contracts the operations of a 200,000-ton-per-year municipal solid waste landfill, yard debris composting, and small-load drop-off facilities. It is self-supported through user fees it collects.

2. PROJECT DESCRIPTION

The intent of this RFP for the Design-Build of the Black Hawk County Landfill Scale House Modification and Scale Replacement Project (Project) is to select a qualified and competent Contractor (Contractor) to provide design and build services to modify the existing scale house and replace the existing 70-foot truck scale. The Project is located at the Black Hawk County Landfill, 1509 East Washburn Road, Waterloo, Iowa.

This scale house modification portion of the Project intends to facilitate the transactions between customers and the scale house attendant so the customer does not need to get out of the vehicle, eliminate the need for the catwalk around the scale, and increase storage space. The intent of the remodel is to utilize the existing enclosure with minor structural modification. The alternate bid will assume the structure's demolition and construction of an addition with an expanded footprint. Attachment A contains the As-Built Site Condition Construction Plans.

The Contractor will be required to remove the existing 70-foot by 10-foot above-ground truck scale and demolish and modify the existing foundation to meet the new scale's requirements, including removing or modifying the approaches and relocating utilities as needed. The Contractor shall add bollards and other structures to address fall hazards. The Contractor will permit and install a new 70-foot by 14-foot truck scale. Attachment A contains the As-Builts Site Condition Construction Plans. Attachment B contains the scale specifications.

The Facility will remain open and in operation during construction. The contractor must work with the Owner and Contract Operator to minimize the impact on operations. The Facility is open Monday through Friday, 7:30 to 4:30, and Saturday, 7:30 to 12:30.

The estimated budget for this project is \$350,000. Understandably, this budget may prevent some features from being included in the Scope of Work and Project Summary. The selection of features to be included in the design depends upon the discretion of the vendor submitting the proposal, but they must be the same or similar features as noted in this RFP.

The project Owner Representative (OR) is John Foster, Administrator BHCSWMC, 319-210-8860, Jfoster@wastetrac.org, PO Box 208, Waterloo, IA 52705.

3. SCHEDULE

The tentative RFP schedule is as follows:

December 10, 2024	Request for Proposals released
December 19, 2024	10:00 AM Public Hearing on Contract Documents
January 6, 2025	10:00 AM Optional Pre-Proposal Meeting
January 13, 2025	11:00 AM Deadline for RFP questions to the Commission
January 16, 2025	2:00 PM Final Addendum issued
January 21, 2025	10:00 AM RFP response due and opening
January 23, 2025	Consideration of Contract Award
June 30, 2025	Substantial Project Completion

The Contractor shall provide the tentative Project Schedule with the following milestones, assuming a start date of February 1, 2025:

Kickoff – Scoping Meeting
30% Design Review
100% Final Design Plans / Construction Documents
100% Design Review and Pre- pre-construction meeting
Permitting
Construction
As-Built Drawings
Project Closeout

4. SCOPE OF WORK

A. General Responsibilities of Contractor.

The Commission is adept at working with professionals to guide it through a project from beginning to end. The following list is a layperson's vision of what services are needed. This project is expected to be turnkey, with all costs in the proposed budget.

The scope of services includes communication with the Commission, assistance with designing the changes to meet regulatory requirements, customer convenience, efficient operations, and strict adherence to the project schedule. Under Commission guidance, the Contractor is to develop a conceptual design, cost estimates for the proposed Project, and schematic design drawings to establish the overall project cost.

Scope of Scale Replacement Contractor is Responsible for:

- Procurement of a truck scale that meets the Vehicle Scales Specifications found in Attachment B — Project Specifications.
- Providing surveying services for the Project.
- Shall be or hire a sub-contractor registered to install scales in Iowa by the Iowa Department of Agriculture – Weights and Measures. The Contractor shall submit the Notice of Sale of Scale for Companies and the Placed in Service Report - Scales to the Iowa Department of Agriculture – Weights and Measures. All work shall be completed per Iowa Code 215.18 and Iowa Administrative Rules, Chapter 85, Weights and Measures.
- Remove the existing scale and modify the foundations as required to facilitate the installation of the new scale.
- Employ services of the independent testing laboratory to perform testing for work.
- Relocate utilities or approaches as the replacement scale will be wider.
- Install bollards or rail support to address fall hazards, as needed.

- Verify operation and place the scale into service before acceptance.

If the project requires additional fill material, the Owner may coordinate with its contract operator to assist. The Contractor will be required to place and prepare the surface. It is preferred that the current scale indicators and display units be utilized in this project.

Scope of Scale House Modification. The Contractor is Responsible for:

- Evaluating options and providing a design to modify the existing scale house to meet project goals. The cost estimate provided will be for modification with an alternate for the demolition and construction of an addition.
- Develop design and construction plans for the remodel or addition.
- Obtaining and procuring all building permits, surveying, plan reviews, and state and local building codes.
- Self-perform or procure sub-contractors to construct the plans consistent with industry standards, SUDAS 2025 Standards, and best practices.
- Employing the services of the independent testing laboratory to perform testing for work.

The Commission will be responsible for all items not connected to the building structure, such as furniture, electronics, etc. This proposal assumes the HVAC and electrical systems are sized for the expanded area for both bids. This includes installing electrical baseboard heating units and wiring into either structure.

B. Progress Payments. Progress payments during the design phase of the work will be based on the submission, review, and acceptance of design deliverables. Progress payments during construction will be based on the percentage of work completed on items listed on the approved schedule of values. Actual construction completed and in place will form the basis for payment. All progress payments must be for the services performed through the last day of the preceding month. Commission and Contractor will negotiate a scale payment schedule before delivery and installation; such prepayment shall not exceed 50% of the scale purchase price. The Commission meets on the 4th Thursday of each month. Progress Payment Applications are due by the 3rd Wednesday of each month.

C. Scoping and Pre-Construction Meetings. After the contract is awarded and the required insurance and bonds are accepted, the Commission will arrange a kickoff scoping meeting with the Contractor. A pre-construction meeting is required before construction, and progress meetings will be set as needed. The meeting agendas shall include the following as a minimum:

- Review and emphasize the needs and design objectives of the project (scoping)
- Roles and Responsibilities of participants, including subcontractors
- Schedule
- Status of submittals or construction
- Modifications and change orders
- Quality control plan
- Progress Payments

D. Design Requirements. This element of work involves preparing the design development and construction documents.

- *Design Development Documents (30% Plans):* Submit two paper copies and one electronic copy of the Draft DB Design Development Documents for review. The Commission will respond within seven working days with comments.
- *100% Draft Construction Documents:* Submit two paper copies and one electronic copy of the 100% Draft DB Construction Documents for review. The Commission will respond within seven working days with comments.

- *Complete Stamped and Signed Construction Documents:* Submit two paper copies and one electronic copy of the 100% Completed Stamped and Signed DB Construction Document.

E. **Construction Requirements.** The Contractor will employ construction practices that minimize dust production and combustion byproducts and processes that ensure the generation of as little waste as possible. Waste disposal in landfills shall be minimized. All waste is required to be run across the scale and charged to the Contractor. All material unsuitable for recycling must be disposed of in a legal manner.

The contractor will provide a working hours schedule with the Owner. The Contractor may perform work after the Facility hours and is responsible for maintaining site security when the Facility is closed. The Contractor shall work with the Owner and its Contract Operator to ensure continuity of operations with minimal impact on the traffic queue and utilization of space used for staging materials and support functions. Working outside of Facility hours may be a strategy to reduce the impact on operations.

F. **Project Close-out.**

Before requesting a final inspection, submit the following:

- a. Project Record Drawings: Maintain one complete set of contract drawings and one full-size set of vendor-supplied drawings. Mark changes, deletions, and additions to show actual constructed conditions. Keep record drawings current. Certification of accuracy and completeness will be required for monthly payment requisitions. On completion of the total project, submit complete record drawings.
- b. As-Constructed Drawings: Provide as-constructed drawings by updating the Approved DB Construction Drawing AutoCAD files with the information on the record drawings, contract modifications, and other applicable shop drawings, sketches, and data. The provided as-constructed drawings shall include an electronic copy in PDF and DWG format and 1 set of ledger-size paper copies.
- c. Operation and Maintenance Manual: Compile product data and related information appropriate for OWNER'S maintenance and operation of products furnished under the Contract. Prepare O&M data in the form of an instructional manual for use by OWNER'S personnel in an electronic PDF format and two hard copies of 8-1/2 in. by 11 in. or 11 in. by 17 in. folded, with standard three-holes punching including manufacturer's printed data, or neatly typewritten. The contents will include, at a minimum:
 - A cover with the typed or printed title "OPERATING AND MAINTENANCE INSTRUCTIONS" with the title of the Project, Contractor name, subject matter covered in the manual, and installation date.
 - Table of contents
 - Product Data with annotations of the specific product or part installed, data applicable to installation, delete references to inapplicable information, Project installation schedule listing dates and locations of products installed.
 - Include drawings to fit inside the binder. Larger drawings may be folded to the size of text pages and placed in envelopes to be bound into the manual.
- d. Guarantees and Bonds: As specified in Contract Documents.
- e. Mechanical and Electrical Systems: Verify in writing that all systems are complete, have been properly started, and are operational, all controls are complete and operational, and sequences have been checked and are functioning properly.
- f. Testing and Balancing Report: As applicable.

Substantial Completion.

- a. The scale portion of the project will be considered substantially completed when the scale is placed into service.
- b. The Scale House Modification portion of the project will be considered substantially completed when the Occupancy Permit is issued and space is available for use by Owner.

Final Inspection. Submit written certification that the project, or designated portion of the project, is substantially complete, and request a final inspection in writing. Upon receipt of the written request that the project is substantially complete, the OR will proceed with an inspection within 5 days of receiving the request or advise the Contractor of items that prevent the project from being designated as substantially complete.

- a. When work is completed substantially, the OR will prepare a list of deficiencies ("Punch List") to be corrected before final acceptance or issue a Letter of Substantial Completion.
- b. The Contractor shall complete the work described on the list of deficiencies within a specified time frame. If the Contractor fails to complete the work within this time frame, the OR may either replace or correct the work with an appropriate reduction in the contract price or charge for re-inspection costs.
- c. If work is not determined to be substantially complete, the OR will notify the Contractor in writing. After completing work, the Contractor shall resubmit certification and request a new final inspection.

Project Acceptance. After correcting all deficiencies, the Contracting Officer will issue a Letter of Acceptance and release Project Retainage.

5. PRE-PROPOSAL MEETING AND FACILITY TOUR

An optional pre-proposal meeting shall be held at 10:00 on January 06, 2025, at the Facility. The Solid Waste and Resource Recovery Administrator will be present to provide further information requested, clarify the intent of the RFP or services, and provide a tour for interested proposers. Any visitor to the site is required to check in with the Scale House and display reflective clothing.

6. ADDENDUMS

All requests for clarification or further information relating to this RFP may be submitted by e-mail to jfoster@wastetrac.org or U.S. mail to John Foster, P.O. Box 208, Waterloo, IA 50704, before 11:00 AM CT Monday, January 13, 2025. Questions and responses will be provided in the form of a supplement issued before January 16, 2025, by email to Proposers who have declared an intent to submit a proposal. Proposers must acknowledge receipt of Addendums on the Proposal Form in Exhibit A.

Bids may be withdrawn on written request by the Bidder received before the time fixed for opening. The Bid Bond of any bidder withdrawing his Bid in accordance with the foregoing conditions will be returned promptly.

7. PROPOSAL RESPONSE REQUIREMENTS

Proposal Submittal Deadline and Location

Responses to this RFP must be labeled and received before 10:00 AM, January 21, 2025, at:

BHCSWMC – Scale Project
INRCOG Front Desk
Attn: Administrator
229 E. Park
Waterloo, IA 50703

Two (2) hard copies and one (1) PDF digital copy of the RFP response must be submitted. Late submittals will not be evaluated. The responses will be distributed to the committee for review and subsequent recommendation. Formal action by the Commission is anticipated at its January 23, 2025, business meeting.

Proposal Response Requirements

Proposals must contain, at the minimum, the following information clearly and comprehensively and in the following order:

1. Letter of Transmittal. The letter of transmittal should briefly outline the Proposer's understanding of the work and general information regarding the Proposer and its staff anticipated to be assigned to the Project, including sub-contractors.
2. Statement of Contractor Qualifications.
 - a. Proposer shall provide its business name, DBA's or former names, and its main office address;
 - b. Provide the background and experience of the principal members of your business, including the officers and names of individuals to be assigned to this Project;
 - c. A summary of the business history, including the number of years in the business and the general character of the work performed;
 - d. Provide a brief description of the Proposer's experience in work similar to this project;
 - e. Detailed descriptions of no more than three (3) projects that best illustrate the firm's experience, capabilities, and characteristics, which would be uniquely relevant in evaluating the firm's expertise in handling the proposed Project to include project schedule and change order amounts as a percentage of the project; and,
 - f. List any work awarded to Proposer that was not completed or any contracts that were in default, including where and why. If none, state such.
3. Management Plan. Describe your proposed approach to this assignment, addressing the following points:
 - a. Discuss how your proposed Project team members have performed on past projects, which have included interactive design reviews with multiple public agencies, a program manager, and the owner;
 - b. Discuss your approach and initial work approach to this Project;
 - c. Budget management and control: Discuss your approach/method of designing to budget; and,
 - d. Provide a realistic outline schedule for the design and build process.
4. Proposal Form Fee Schedule (Attachment D).
5. Provide written comments on the proposed Improvement Contract and Performance Bond language. If there are no changes, indicate so.

6. Bid Bond. Proposals shall be accompanied in a separate envelope by a certified or cashier's check drawn from an Iowa bank, a certified share draft drawn on a credit union in Iowa or chartered under the laws of the United States, or bid security, payable to BHCSWMC in the sum of not less than 10% of the cost proposed for the Base Bid (as shown in the Proposal Form), which certified check, certified share draft or bid security will be held as security that the respondent will enter into a Contract for the work and will furnish the required bonds, and in case the successful respondent shall fail or refuse to enter into the Contract and furnish the required bonds, respondent's bid security may be retained by said BHCSWMC as agreed upon liquidated damages.

Faxed and emailed proposals will not be accepted.

VII. SELECTION PROCESS

Selection Criteria

All submittals will be reviewed based on written responses to the RFP, including the respondent's qualifications, past project history, key team members and subcontractors, fee proposal, and other factors deemed important.

The Commission may reject any or all proposals if, in its opinion, they do not meet the RFP's requirements. The Committee's recommendation will be subject to the Commission Board of Directors' consideration and approval. All Proposers will be notified in writing regarding the selection process results.

Reservations

The Commission reserves the right to reject any and all submittals, waive formalities, technical requirements, and/or deficiencies, or solicit new or additional proposals if deemed in its best interests. The Commission also reserves the right to contact Proposers to clarify responses.

Proposer's Costs

The proposer is responsible for any costs incurred in responding to this RFP.

Attachment A

EXISTING CONDITIONS AS-BUILT CONSTRUCTION PLANS

1. Scale Improvement Construction Drawings, May 2008, AECOM (10 pages)
2. Scale and Access Road Improvements Construction Drawings, June 2006, AECOM (15 pages)
3. Sale and Small Loads Facility Construction Drawings, April 1995, AECOM (5 pages)

**BLACK HAWK COUNTY SOLID WASTE COMMISSION
SCALE IMPROVEMENTS
CONSTRUCTION DRAWINGS**


**BLACK HAWK COUNTY SANITARY LANDFILL
WATERLOO, IOWA
MAY 2008**

INDEX OF DRAWINGS

- | | |
|----|-----------------------------------|
| 1 | TITLE SHEET |
| 2 | LEGEND AND GENERAL NOTES |
| 3 | QUANTITIES AND ESTIMATE REFERENCE |
| 4 | GENERAL SITE PLAN AND BEACH MARKS |
| 5 | REMOVAL PLAN |
| 6 | NEW FACILITIES PLAN |
| 7 | PAVEMENT JOINTING AND GRADES |
| 8 | DETAILS |
| 9 | DETAILS |
| 10 | DETAILS |
| 11 | ELECTRICAL SITE PLAN |
| 12 | DETAILS |



LOCATION MAP
NIS

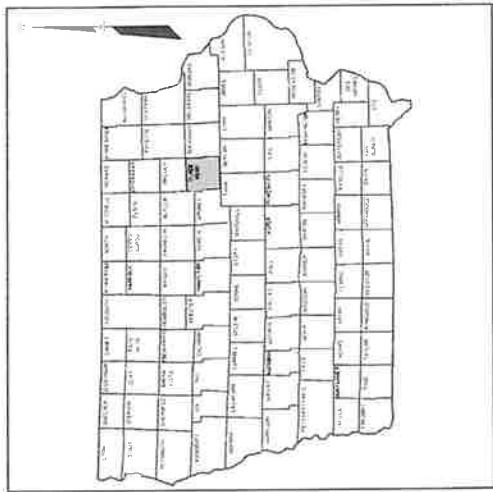

VICINITY MAP
NIS

PREPARED FOR
**BLACK HAWK COUNTY
SOLID WASTE COMMISSION**

1407 INDEPENDENCE AVENUE, 5TH FLOOR
WATERLOO, IOWA 50704
319-234-8115

PREPARED BY



501 SYCAMORE STREET, SUITE 222
WATERLOO, IOWA 50703
319-232-6531

I hereby certify that this Drawing (or document) was prepared by me or my direct personal supervision and that I am a duly Licensed Professional Engineer under the laws of the State of Iowa.	
RICHARD L. BURGER, P.E. LICENSURE NUMBER 1148 My license renewal date is December 31, 2009 Fees or taxes covered by this fee: PER UNIT OF BUILDINGS	

GENERAL NOTES		GENERAL AND NOTES	
<p>1. ARRANGE WITH THE VARIOUS UTILITY COMPANIES FOR SUPPORT OR RELOCATION OF ANY UTILITIES AND/OR UTILITY POLES. ANY CHARGE FOR TEMPORARY SUPPORTING OR RELOCATING ANY UTILITIES AND/OR UTILITY POLES SHALL BE PAID AT NEW SCALE FOR OPERATION. CONTACT IOWA CALL 1-800-292-8989 FOR EXISTING UTILITY LOCATIONS PRIOR TO EXCAVATION.</p> <p>2. WHERE PUBLIC UTILITY LINES ARE SHOWN AS EXISTING ON DRAWINGS OR ENCOUNTERED DURING CONSTRUCTION AREA, IT SHALL BE THE RESPONSIBILITY OF CONTRACTOR TO NOTIFY OWNERS OF UTILITIES PRIOR TO BEGINNING CONSTRUCTION. CONTRACTOR SHALL AFFORD ACCESS TO THESE FACILITIES FOR NECESSARY MODIFICATION OF SERVICES. UNDERGROUND FACILITIES, STRUCTURES AND UTILITIES HAVE BEEN PLOTTED FROM AVAILABLE SURVEYS AND RECORDS, AND THEREFORE THE IR LOCATIONS MUST BE CONSIDERED APPROXIMATE ONLY. IT IS POSSIBLE THAT THE LINE(S) IN THE STENCE WHICH IS PRESENTLY NOT KNOWN IN SURFACE SURVEY, IS THE EXISTING LINE. IT IS THE CONTRACTOR'S RESPONSIBILITY TO DETERMINE WHETHER AN EXISTING LINE IS PRESENT AND TO AVOID DAMAGE TO CONTRACTOR FOR ANY INFERIORITY OR DELAY CAUSED BY SUCH WORK.</p> <p>3. PROVIDE, ERECT AND MAINTAIN AT ALL TIMES DURING THE PROGRESS AND SUSPENSION OF THE WORK AND UNTIL COMPLETION AND FINAL ACCEPTANCE THEREOF, SUITABLE AND REQUISITE BARRIERS, SIGNS OR OTHER ADEQUATE PROTECTION, KEEP AND MAINTAIN SUCH LIGHTS, DANGER SIGNS AND RAFFIC SIGNALS AS MAY BE NECESSARY TO ENSURE SAFETY OF PERSONNEL AND PEDESTRIANS ENGAGED IN THE WORK, BARRICADES AND OBSTRUCTION CONES SHALL BE PROVIDED SO AS TO MAINTAIN CLEAR SIGNAL LIGHTS AND KEEP BIRTHING FROM SURVEY TO SURVEY BY CABLES AND LIGHTS, SHALL CONFORM TO THE REQUIREMENTS OF "MANUAL OF RAFFIC CONTROL DEVICES FOR STATE HIGHWAYS", U. S. DEPARTMENT OF TRANSPORTATION, FEDERAL HIGHWAY ADMINISTRATION, 1978, AND THE LATE REVISION OF IOWA DEPARTMENT OF TRANSPORTATION SPECIFICATIONS ENTITLED "SUPPLEMENTAL SPECIFICATION FOR TRAFFIC CONTROL FOR TREE AND HIGHWAY CONSTRUCTION AND MAINTENANCE OPERATIONS."</p> <p>4. GRADED AREAS DISBURSED DURING CONSTRUCTION SHALL BE FINISH GRADED WITH A MINIMUM 6" TOPSOIL, FERTILIZED, SEEDED AND MULCHED.</p> <p>5. FINISH GRADE AND CLEAUP IMMEDIATELY BEHIND EXCAVATION AND BACKFILL OPERATIONS TO MINIMIZE INCONVENIENCE TO PUBLIC.</p> <p>6. PROVIDE COMPACTED STRUCTURAL BACKFILL FOR TRENCHES BEING CUT IN CONCRETE AND IRWA FAKED SURFACES.</p> <p>7. GRADE ALL AREAS TO GRAIN.</p> <p>8. MINIMIZE DISTURBANCE TO EXISTING DRIVES, SIDEWALKS AND GRASSED AREAS.</p> <p>9. COST OF REMOVAL AND RELOCATION OF EXISTING SIGN WITHIN LIMITS OF CONSTRUCTION IS INCIDENTAL TO PROJECT.</p> <p>10. CONTRACTOR SHALL APPLY NECESSARY MOISTURE TO CONSTRUCTION AREA AND HAUL ROADS TO PREVENT SPREAD OF DUST.</p> <p>11. WORK SHALL BE CONDUCTED IN ACCORDANCE WITH BLACK HAWK COUNTY SANITARY LANDFILL'S WASTE POLLUTION PREVENTION PLAN.</p> <p>12. USE BORROW EXCAVATION FROM ON-SITE, COORDINATE WITH OWNER FOR LOCATION OF EARTH BORROW.</p> <p>13. DISPOSE OF EXCESS EARTH AND CONCRETE REMOVAL ON SITE IN LOCATION AS DIRECTED BY OWNER.</p>		<p>DATE: MAY 2008 PROJECT NO: 03142-00400 TELEPHONE: (515) 432-4000 SALES NO: 2 DRAWING NO: 2</p>	
<p>SYMBOLS LEGEND</p>		<p>CONSTRUCTION DRAWINGS SCALE: 1/25000 BLACK HAWK COUNTY LANDFILL</p>	
<p>STAGING NOTES</p> <p>1. STAGE CONSTRUCTION OF IMPROVEMENTS TO MAINTAIN CUSTOMER TRAFFIC OVER EXISTING STAKES, EXISTING ACCESS ROAD AND SMALL CONSTRUCTION AREA, UNTIL NEW SCALE IS COMPLETE AND READY FOR OPERATION.</p> <p>2. COMPLETE AS MUCH NEW CONSTRUCTION AS POSSIBLE PRIOR TO PLACING NEW SCALE IN OPERATION.</p> <p>3. EQUIP LINE WEST 20' OF PAVEMENT REMOVAL AND REPLACEMENT AS SOON AS POSSIBLE.</p> <p>4. DO NOT ROUTE TRAFFIC OVER NEW SCALE UNTIL NEW SCALE IS INSTALLED AND READY FOR OPERATION. COORDINATE WITH OWNER TO NEW FACILITY.</p> <p>5. PROVIDE OWNER WITH DETAILED STAGING PLAN FOR OWNER AND ENGINEER REVIEW PRIOR TO COMMENCING PROJECT CONSTRUCTION.</p>		<p>EarthTech</p>	
<p>GENERAL NOTES</p> <p>1. ARRANGE WITH THE VARIOUS UTILITY COMPANIES FOR SUPPORT OR RELOCATION OF ANY UTILITIES AND/OR UTILITY POLES. ANY CHARGE FOR TEMPORARY SUPPORTING OR RELOCATING ANY UTILITIES AND/OR UTILITY POLES SHALL BE PAID AT NEW SCALE FOR OPERATION. CONTACT IOWA CALL 1-800-292-8989 FOR EXISTING UTILITY LOCATIONS PRIOR TO EXCAVATION.</p> <p>2. WHERE PUBLIC UTILITY LINES ARE SHOWN AS EXISTING ON DRAWINGS OR ENCOUNTERED DURING CONSTRUCTION AREA, IT SHALL BE THE RESPONSIBILITY OF CONTRACTOR TO NOTIFY OWNERS OF UTILITIES PRIOR TO BEGINNING CONSTRUCTION. CONTRACTOR SHALL AFFORD ACCESS TO THESE FACILITIES FOR NECESSARY MODIFICATION OF SERVICES. UNDERGROUND FACILITIES, STRUCTURES AND UTILITIES HAVE BEEN PLOTTED FROM AVAILABLE SURVEYS AND RECORDS, AND THEREFORE THE IR LOCATIONS MUST BE CONSIDERED APPROXIMATE ONLY. IT IS POSSIBLE THAT THE LINE(S) IN THE STENCE WHICH IS PRESENTLY NOT KNOWN IN SURFACE SURVEY, IS THE EXISTING LINE. IT IS THE CONTRACTOR'S RESPONSIBILITY TO DETERMINE WHETHER AN EXISTING LINE IS PRESENT AND TO AVOID DAMAGE TO CONTRACTOR FOR ANY INFERIORITY OR DELAY CAUSED BY SUCH WORK.</p> <p>3. PROVIDE, ERECT AND MAINTAIN AT ALL TIMES DURING THE PROGRESS AND SUSPENSION OF THE WORK AND UNTIL COMPLETION AND FINAL ACCEPTANCE THEREOF, SUITABLE AND REQUISITE BARRIERS, SIGNS OR OTHER ADEQUATE PROTECTION, KEEP AND MAINTAIN SUCH LIGHTS, DANGER SIGNS AND RAFFIC SIGNALS AS MAY BE NECESSARY TO ENSURE SAFETY OF PERSONNEL AND PEDESTRIANS ENGAGED IN THE WORK, BARRICADES AND OBSTRUCTION CONES SHALL BE PROVIDED SO AS TO MAINTAIN CLEAR SIGNAL LIGHTS AND KEEP BIRTHING FROM SURVEY TO SURVEY BY CABLES AND LIGHTS, SHALL CONFORM TO THE REQUIREMENTS OF "MANUAL OF RAFFIC CONTROL DEVICES FOR STATE HIGHWAYS", U. S. DEPARTMENT OF TRANSPORTATION, FEDERAL HIGHWAY ADMINISTRATION, 1978, AND THE LATE REVISION OF IOWA DEPARTMENT OF TRANSPORTATION SPECIFICATIONS ENTITLED "SUPPLEMENTAL SPECIFICATION FOR TRAFFIC CONTROL FOR TREE AND HIGHWAY CONSTRUCTION AND MAINTENANCE OPERATIONS."</p> <p>4. GRADED AREAS DISBURSED DURING CONSTRUCTION SHALL BE FINISH GRADED WITH A MINIMUM 6" TOPSOIL, FERTILIZED, SEEDED AND MULCHED.</p> <p>5. FINISH GRADE AND CLEAUP IMMEDIATELY BEHIND EXCAVATION AND BACKFILL OPERATIONS TO MINIMIZE INCONVENIENCE TO PUBLIC.</p> <p>6. PROVIDE COMPACTED STRUCTURAL BACKFILL FOR TRENCHES BEING CUT IN CONCRETE AND IRWA FAKED SURFACES.</p> <p>7. GRADE ALL AREAS TO GRAIN.</p> <p>8. MINIMIZE DISTURBANCE TO EXISTING DRIVES, SIDEWALKS AND GRASSED AREAS.</p> <p>9. COST OF REMOVAL AND RELOCATION OF EXISTING SIGN WITHIN LIMITS OF CONSTRUCTION IS INCIDENTAL TO PROJECT.</p> <p>10. CONTRACTOR SHALL APPLY NECESSARY MOISTURE TO CONSTRUCTION AREA AND HAUL ROADS TO PREVENT SPREAD OF DUST.</p> <p>11. WORK SHALL BE CONDUCTED IN ACCORDANCE WITH BLACK HAWK COUNTY SANITARY LANDFILL'S WASTE POLLUTION PREVENTION PLAN.</p> <p>12. USE BORROW EXCAVATION FROM ON-SITE, COORDINATE WITH OWNER FOR LOCATION OF EARTH BORROW.</p> <p>13. DISPOSE OF EXCESS EARTH AND CONCRETE REMOVAL ON SITE IN LOCATION AS DIRECTED BY OWNER.</p>		<p>CONSTRUCTION DRAWINGS SCALE: 1/25000 BLACK HAWK COUNTY LANDFILL</p>	


ESTIMATE REFERENCE NOTES


1. REFER TO SECTION 1110.
2. INCLUDES MOBILIZATION AND DEMOBILIZATION COSTS FOR COMPLETE PROJECT. CONTRACTOR WILL BE ELIGIBLE FOR UP TO HALF OF MOBILIZATION COST AT BEGINNING OF PROJECT WITH REMAINDER TO BE PAID AS PART OF Closeout.
3. REFER TO SECTION Q2232. INCLUDES PLUGGING ABANDONED WATER SERVICE. REMOVAL OF SANITARY SEWER SERVICE, GLEANDOUT, AND REMOVAL OF OLD SCALE HOUSE FOOTING WALL AS REQUIRED. ALSO INCLUDES SILT FENCE AND SILT FENCE REMOVAL AS REQUIRED TO CONTROL EROSION.
4. LUMP SUM PRICE INCLUDES EXCAVATION REQUIRED FOR NEW PAVEMENT. EMBANKMENT FOR SCALE RAMPS AND ANY OTHER MISCELLANEOUS EARTHWORK REQUIRED FOR PROJECT.
5. & 6. REFER TO SECTION 02515 AND TYPICAL SECTIONS.
7. REFER TO SECTION 02230 AND TYPICAL SECTIONS. MEASUREMENT AND PAYMENT FOR CLASS A CRUSHED STONE SAME UNIT PRICE AS MODIFIED FOR SCALE RAMPS.
8. INCLUDES REMOVAL OF EXISTING ROCK, REGDRAIN AREA, EXCAVATION FOR SWALE, ENGINEERING FABRIC, EROSION STONE AND REPLACEMENT TOPSOIL IN DISTURBED AREA.
9. INCLUDES EXCAVATION TO EXPOSE SEWER SERVICE, FURNISHING AND PLACE OF INSULATION AND STRUCTURAL BACKFILL.
10. INCLUDES CONCRETE REMOVAL IN AREAS INDICATED ON PLANS. REFER TO SECTION 02510.
11. INCLUDES REMOVAL OF GUARD POST AND FOOTINGS COMPLETE. INCLUDES DISPOSAL OF GUARD POSTS NOT SCHEDULED FOR REPLACEMENT AND SALVAGING GUARD POSTS FOR REUSE.
12. & 13. INCLUDES FURNISHING AND INSTALLATION OF GUARD POSTS PER PLANS DETAILS AT LOCATIONS INDICATED.
14. INCLUDES RE INSTALLATION OF REMOVABLE GUARD POSTS PER DETAIL AND REPAINTING GUARD POSTS TO MATCH EXISTING.
15. INCLUDES EXCAVATION, FURNISHING AND INSTALLATION OF POST SLEEVE, CONCRETE ENCASEMENT AND BACKFILL.
16. INCLUDES FURNISHING AND INSTALLATION OF GRATED PLATFORM AND GRATING AS DETAILED ON PLANS. METAL SKIRTING AND PLUMWOOD DECK PANELS PAID FOR AS SEPARATE BID ITEMS.
17. INCLUDES REMOVAL OF GRATED PLATFORMS, MODIFICATIONS AS REQUIRED TO SUITE NEW LOCATION, AND RE INSTALLATION.
18. INCLUDES FURNISHING AND INSTALLATION OF METAL SKIRTING ON GRATED PLATFORMS PER PLANS DETAILS.
19. INCLUDES EXCAVATION, FURNISHING AND INSTALLATION OF PLUMWOOD PANELS ON GRATED PLATFORMS BENEATH NEW OR EXISTING GRATING.
20. INCLUDES FURNISHING AND INSTALLATION OF NEW BARRIER GATE WIRED TO OPERATE AUTOMATICALLY AFTER VEHICLE HAS BEEN MOVED. ALSO INCLUDES PAVEMENT INSTALLED DETECTOR LOOPS.
21. INCLUDES NEW CAMERA, MOUNTING POLE, POLE FOUNDATION, AND ASSOCIATED WIRING COMPLETE.
22. INCLUDES FURNISHING AND INSTALLATION OF ALL ELECTRICAL WIRING NOT INCLUDED IN OTHER BID ITEMS AND WIRING NECESSARY TO INSTALL OWNER TURNED WASTE WIZARD AUTOMATIC WEIGHING SYSTEM COMPLETE.
23. LUMP SUM BID ITEM INCLUDES RESTORATION OF SEDED AREAS DISTURBED DURING CONSTRUCTION WITH 6 INCHES TOPSOIL AND SEEDING PER SECTION 02485.
24. INCLUDES ALL TRAFFIC CONTROL REQUIRED FOR PROJECT. REFER TO SECTION 02970.


ESTIMATED QUANTITIES


ITEM		DESCRIPTION	UNIT	ESTIMATED QUANTITY
1	100' Tan Plastic Soil Compaction	LS	1.0	
2	Site Preparation	LS	1.0	
3	Surfacing	LS	1.0	
4	PC Concrete Paving	LS	1.0	
5	PC Concrete Paving	SY	52.0	
6	6" Thick Mobilized Subbase	SY	373.0	
7	6" Thick Mobilized Subbase	SY	923.0	
8	Relocate Rock Lined Slope	SY	30.0	
9	Relocate Steel Sheet Pile	LF	50.0	
10	Pavement Removal	SY	983.0	
11	Guard Rail Removal	E.A.	5.0	
12	Guard Rail Posts	E.A.	8.0	
13	Key Hole Guard Posts	E.A.	8.0	
14	Guard Rail Posts	E.A.	2.0	
15	Guard Rail Posts	E.A.	2.0	
16	Circled Walkway Platforms	LS	1.0	
17	Remove and Replace Grated Platform	LS	232.0	
18	Grated Walkway Skirting	LF	2,100.0	
19	Plumwood Panels Beneath Grating	SF	1.0	
20	Barrier Gates	E.A.	1.0	
21	Video Camera Surveillance System	LS	1.0	
22	Electrical Hookups	LS	1.0	
23	Fertilizing, Seeding and Mulching	LS	1.0	
24	Traffic Control	LS	1.0	


CONSTRUCTION DRAWINGS SCALE MPPRODEMENTS BLACK HAWK COUNTY LANDFILL		QUANTITIES AND ESTIMATE REFERENCE	
DATE	May 2008	PAGE	10 of 12, 06.00
FAIRM	CHG/C-S, reg	SETT NO	1
DRAWING NO. 3			

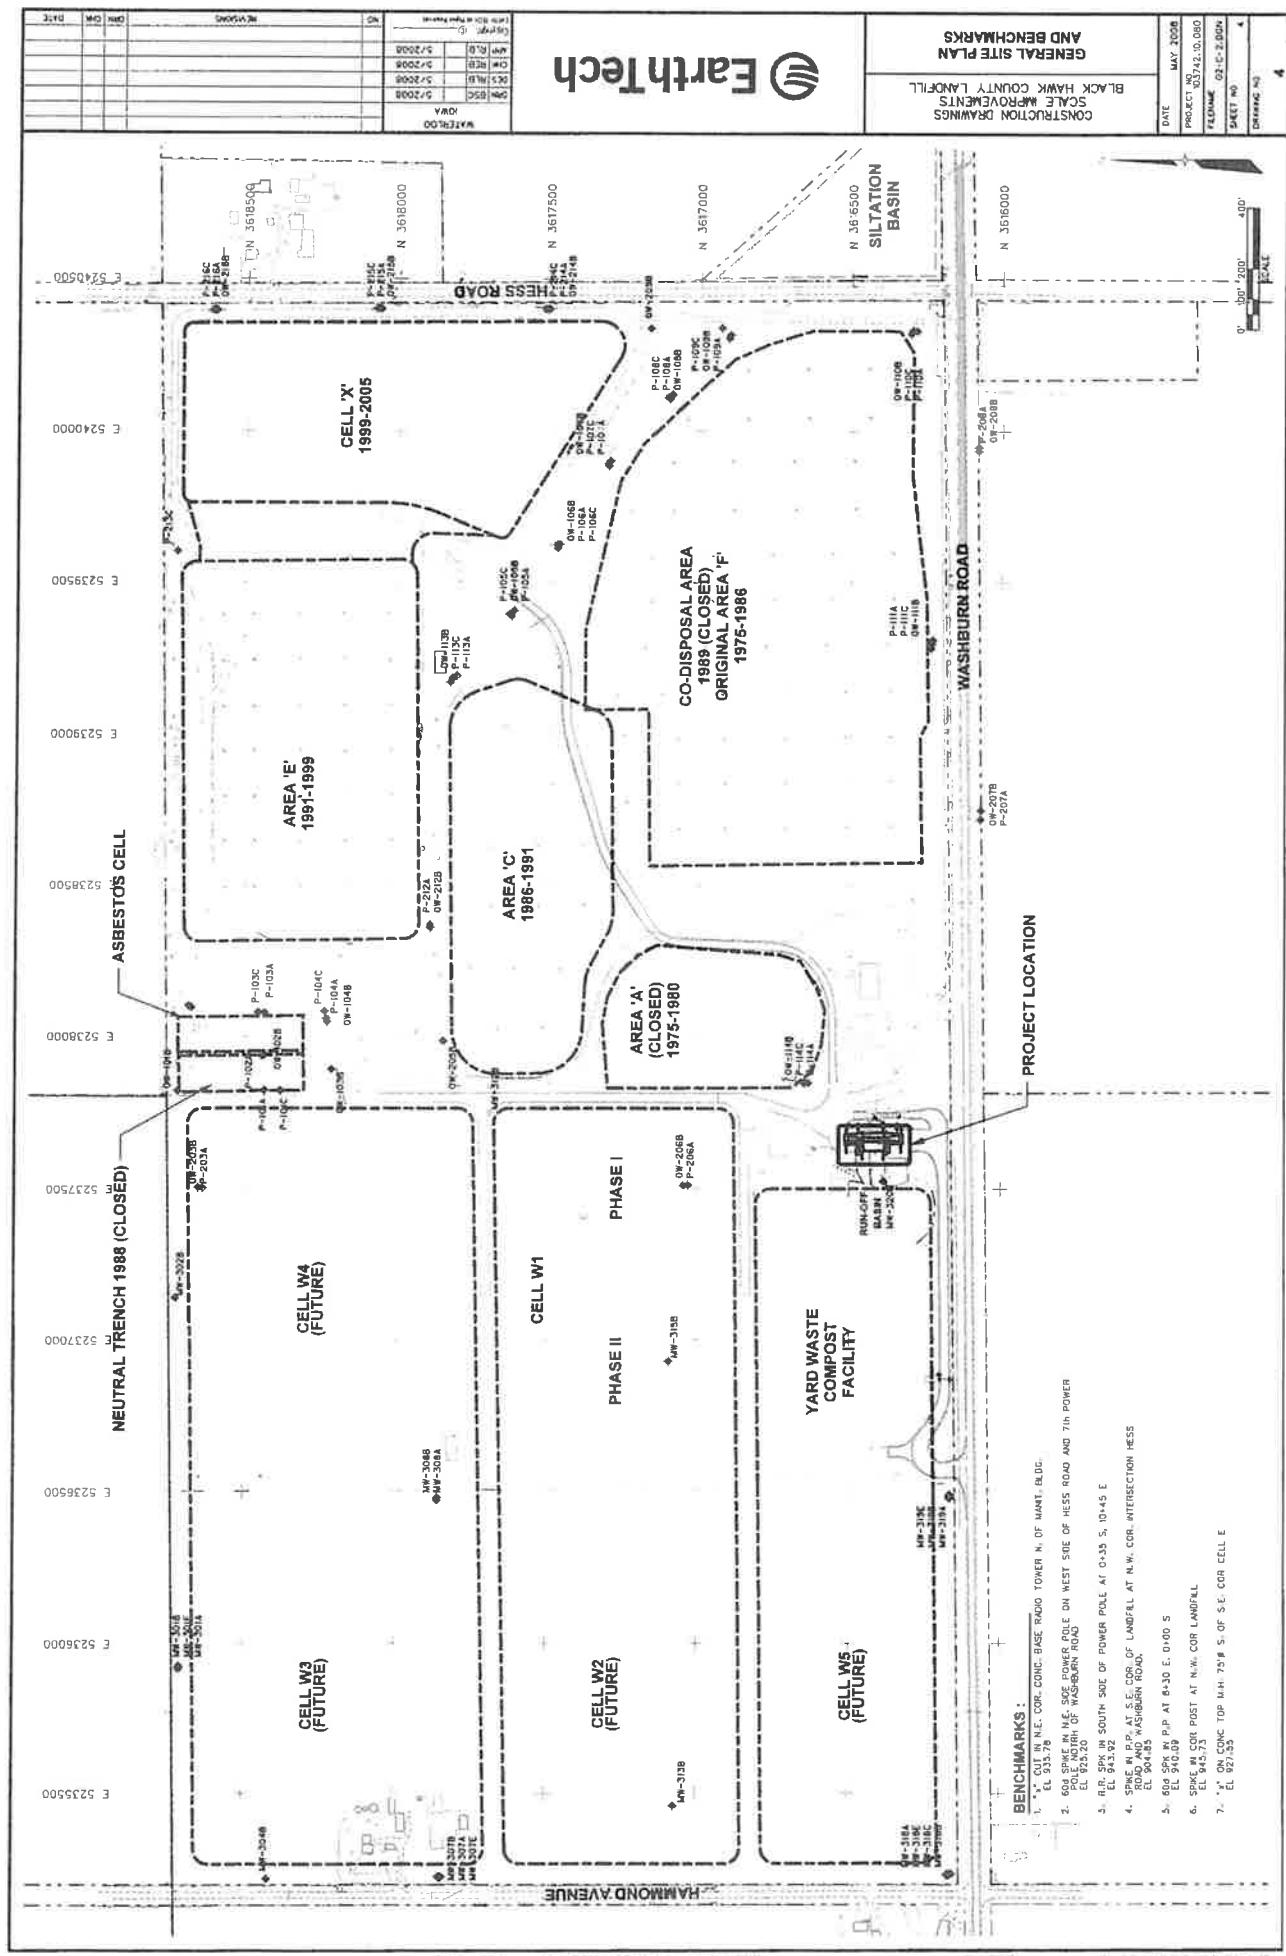


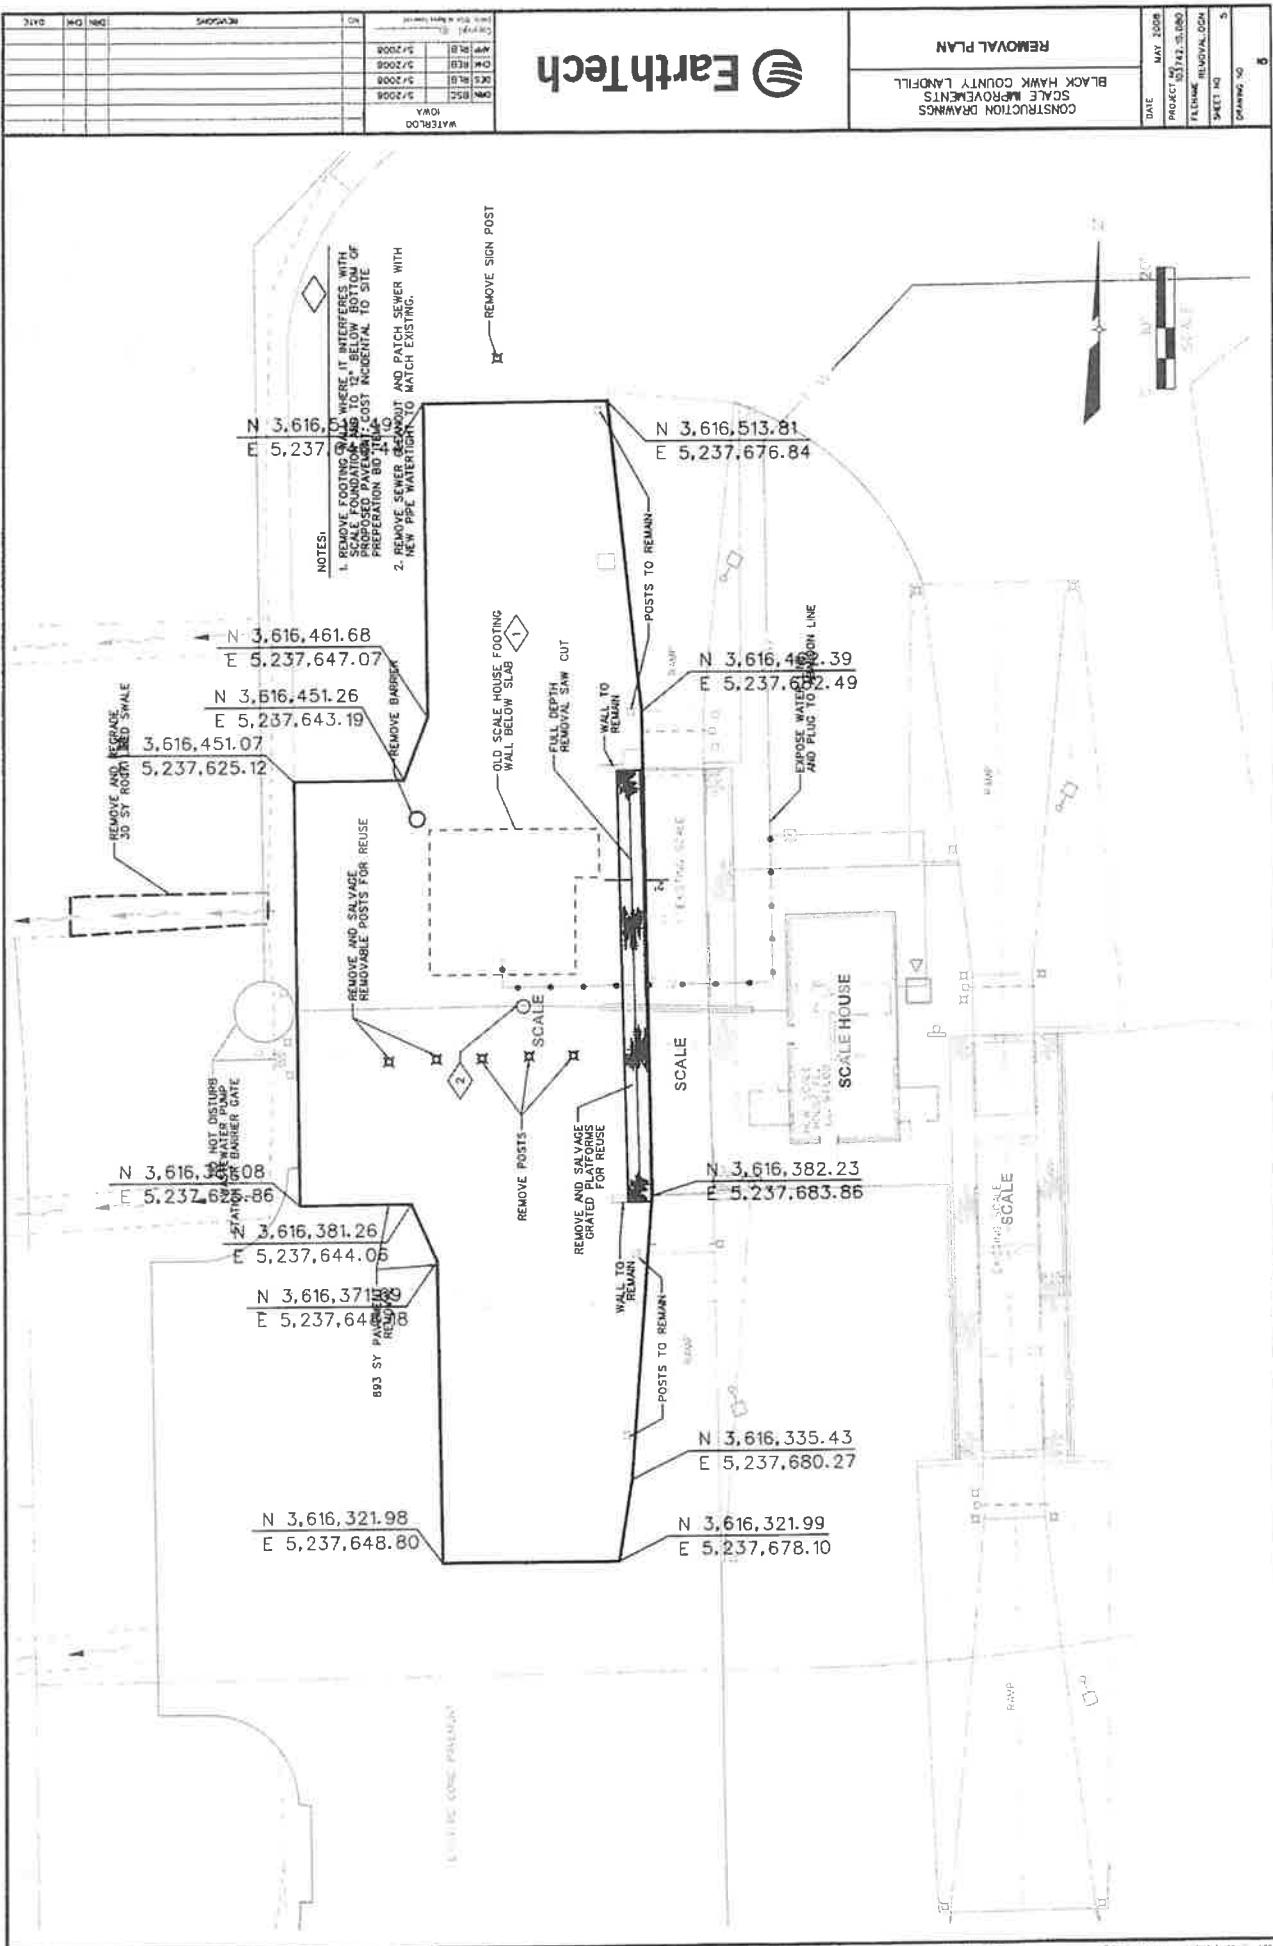


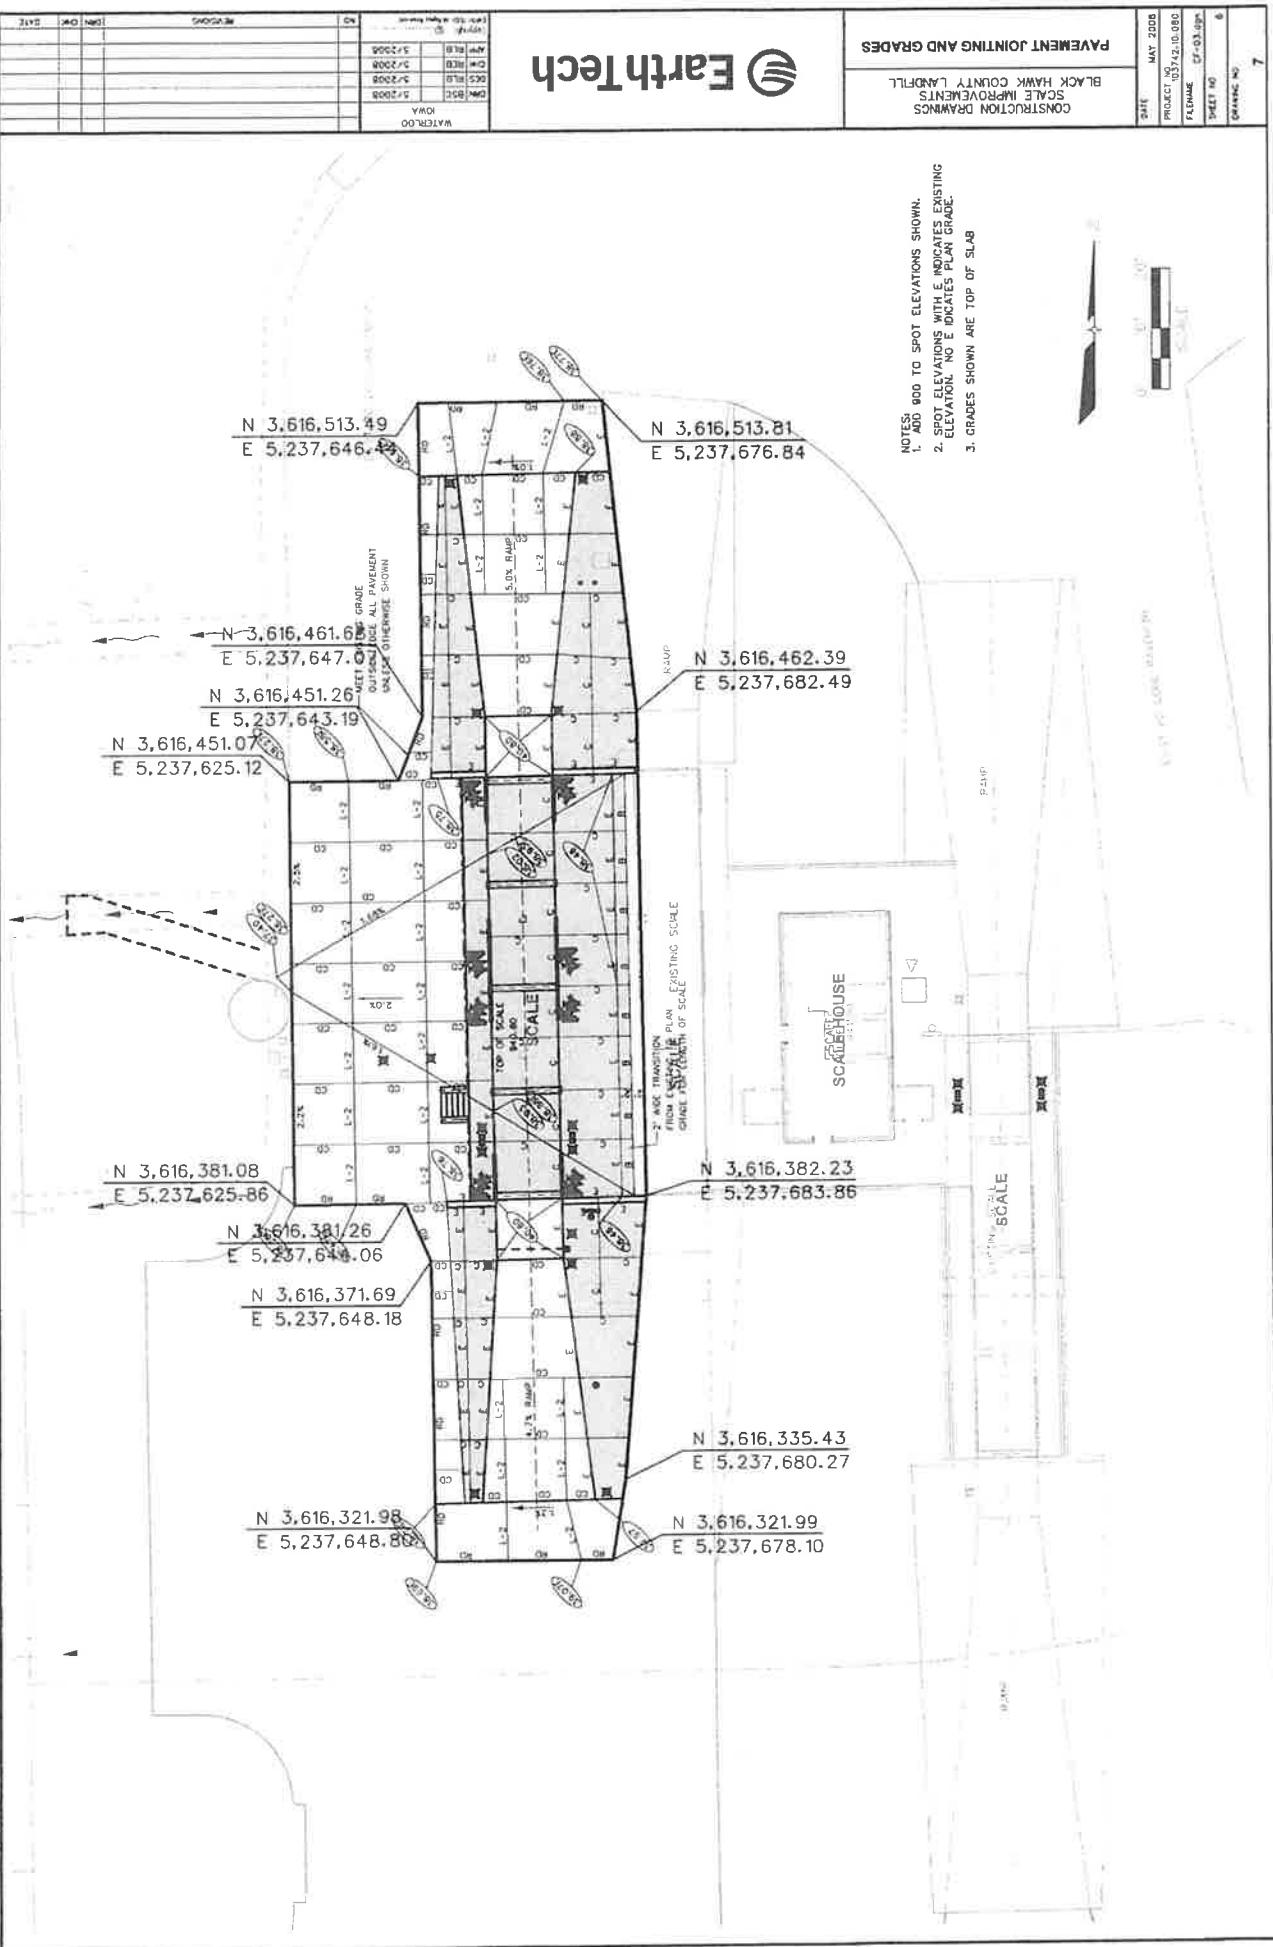


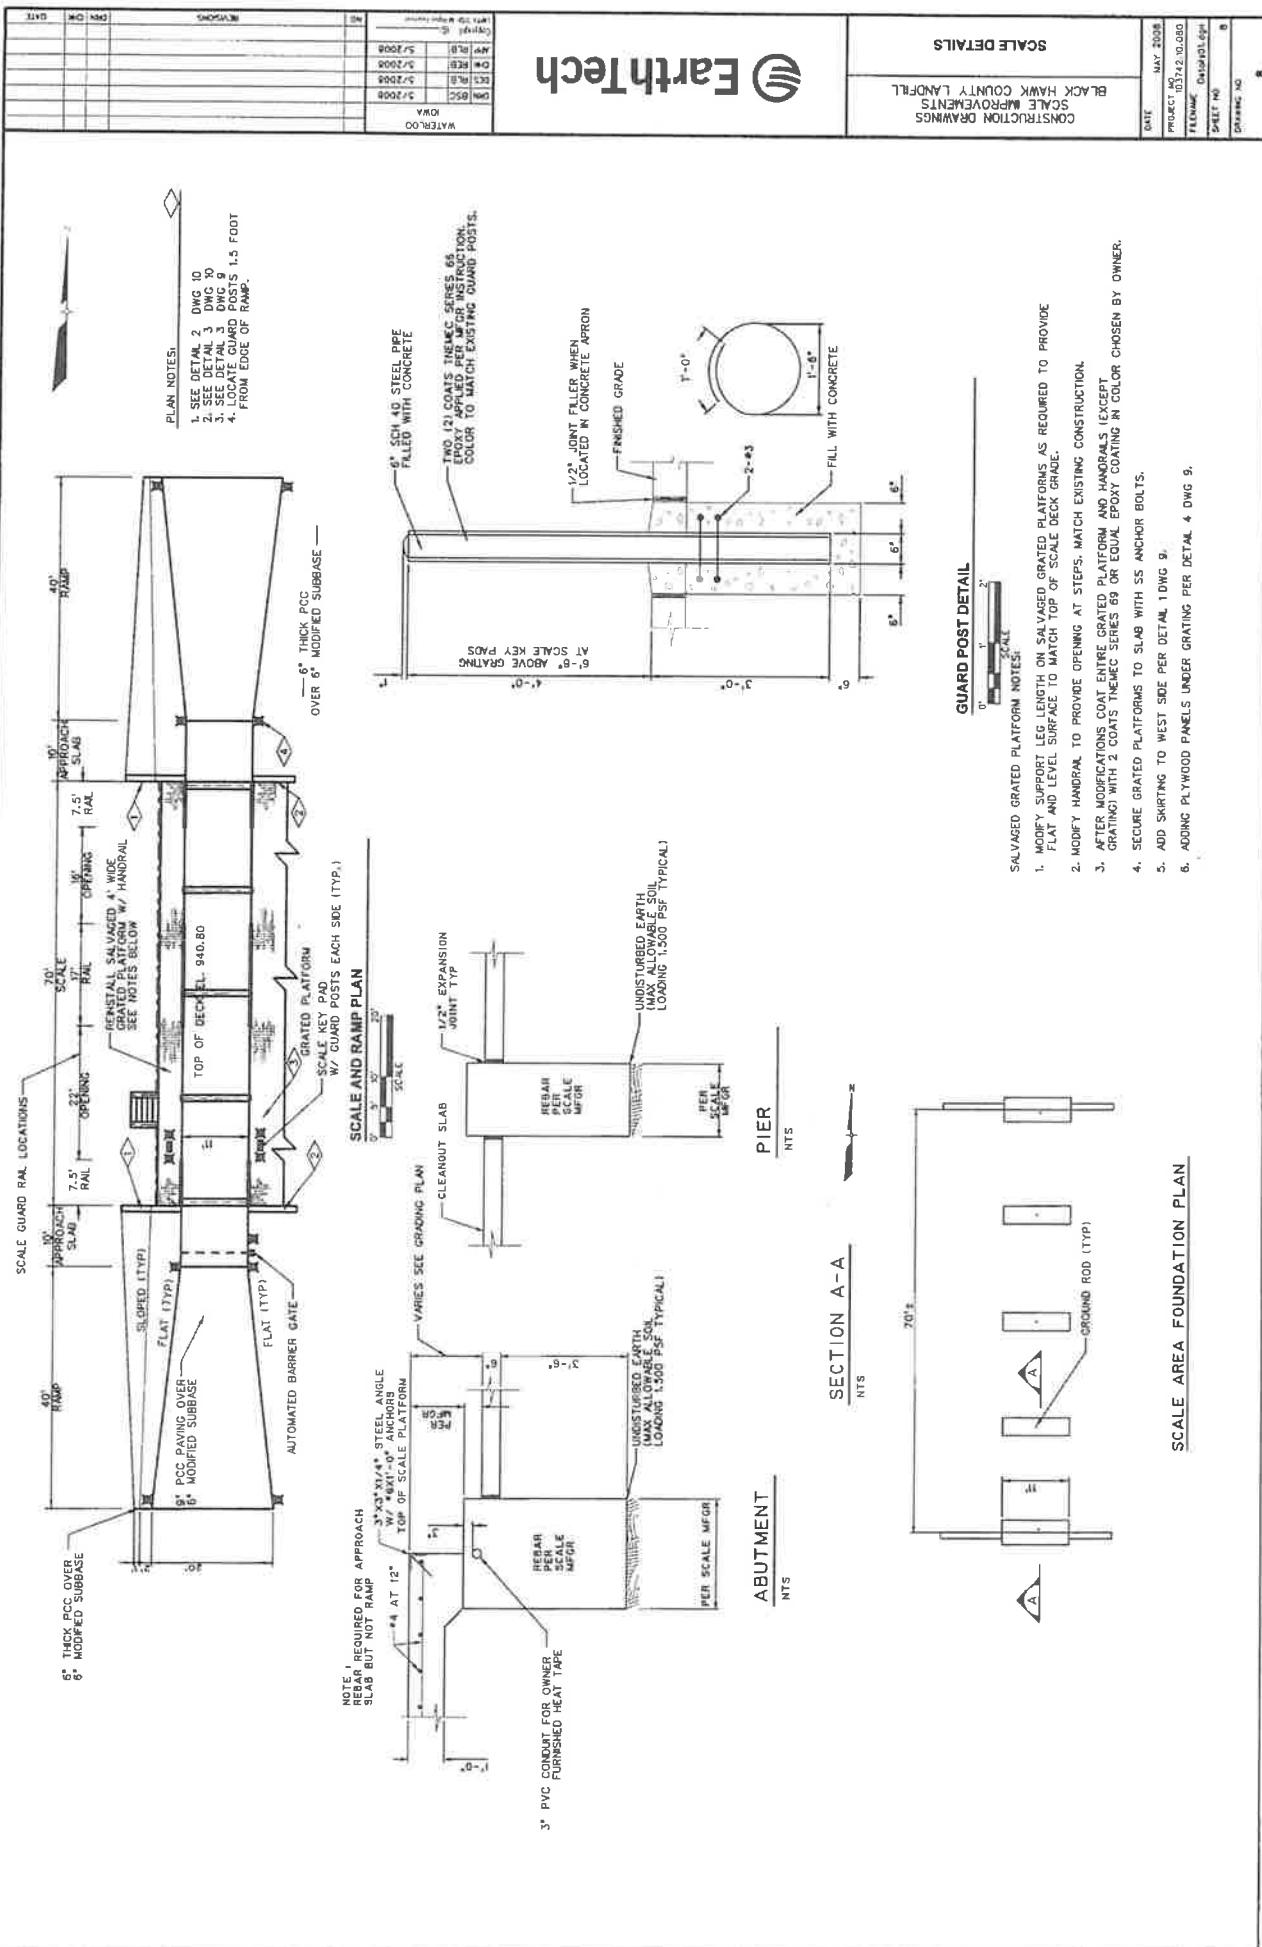

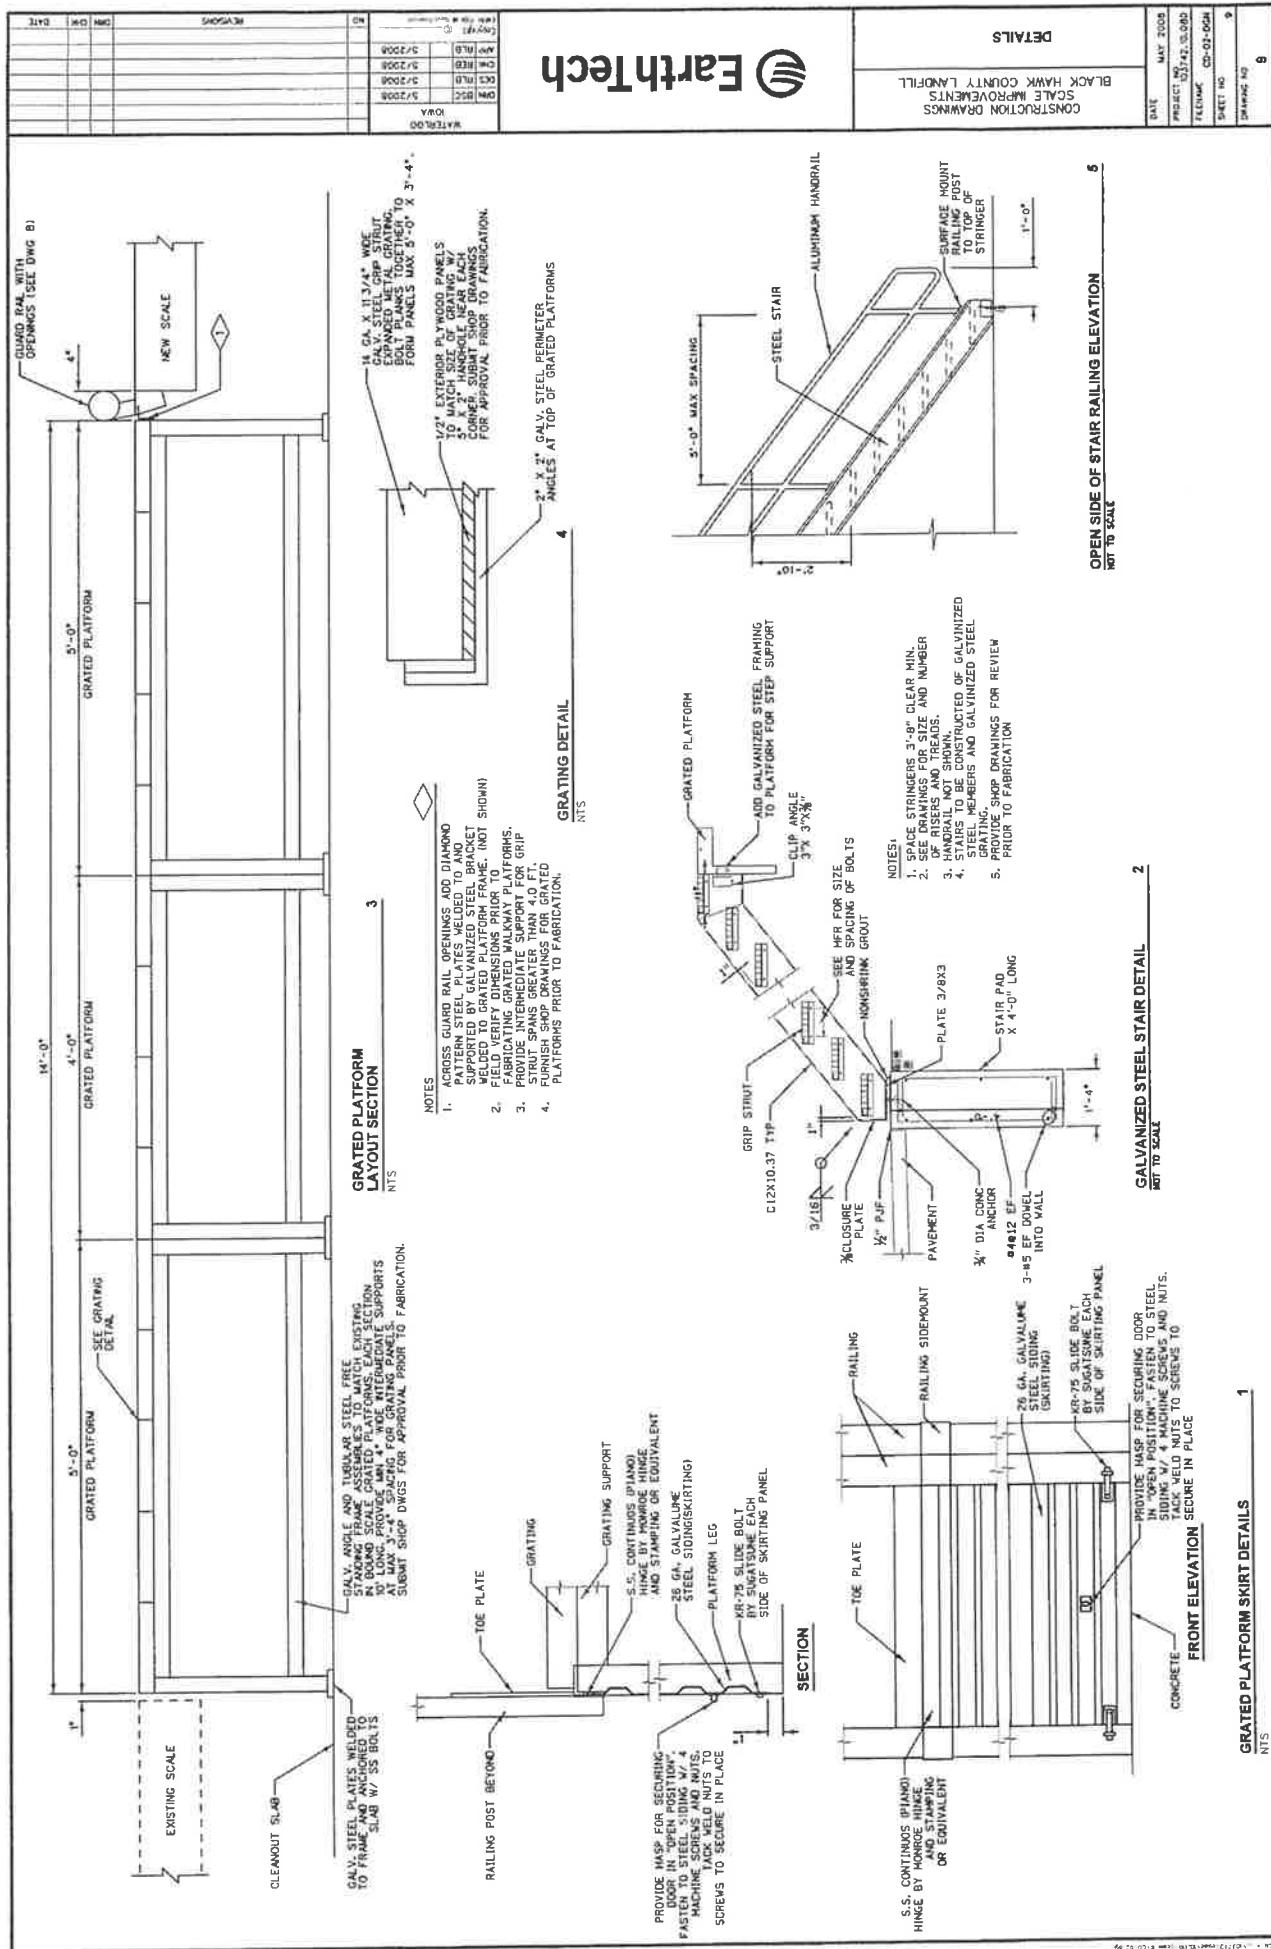

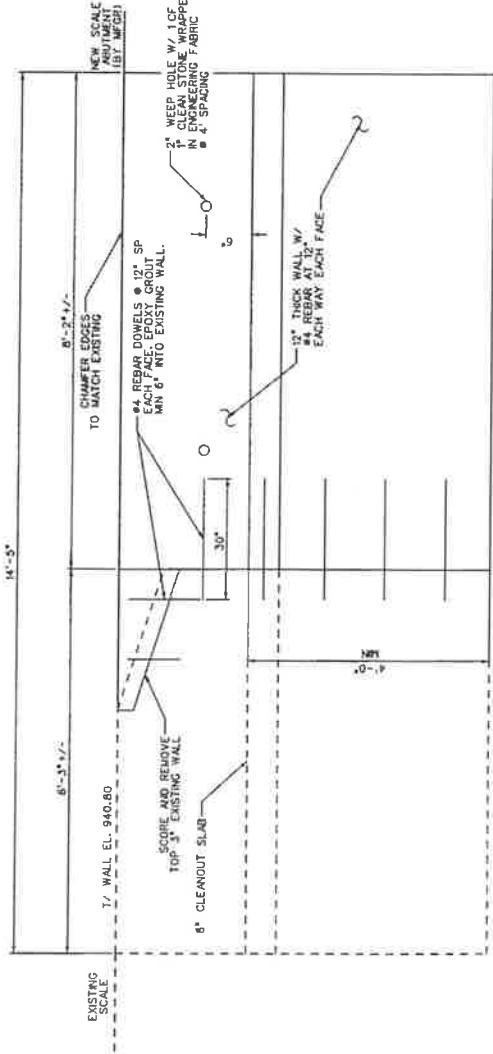


**RETAINING WALL DETAIL
BETWEEN SCALES**
NTS

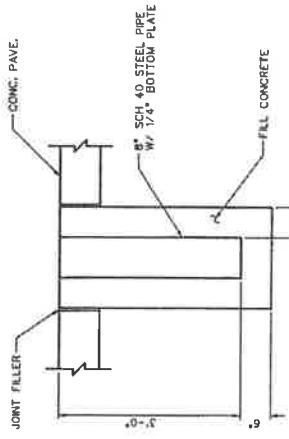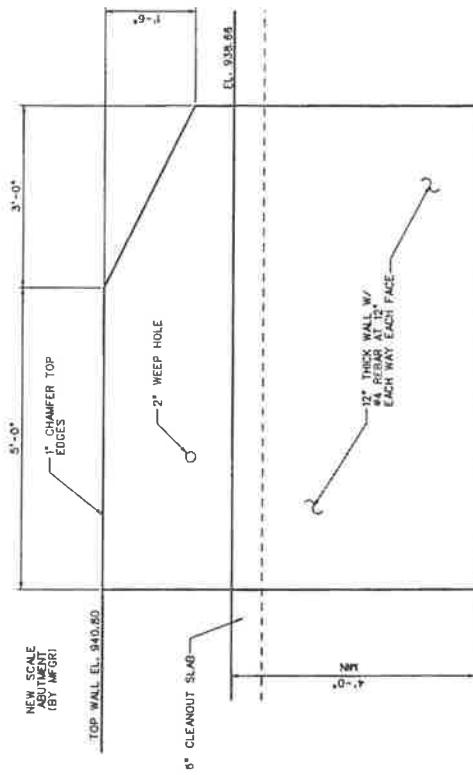

BLACK HAWK COUNTY SOLID WASTE COMMISSION SCALE AND ACCESS ROAD IMPROVEMENTS CONSTRUCTION DRAWINGS

BLACK HAWK COUNTY SANITARY LANDFILL
WATERLOO, IOWA
JUNE 2006

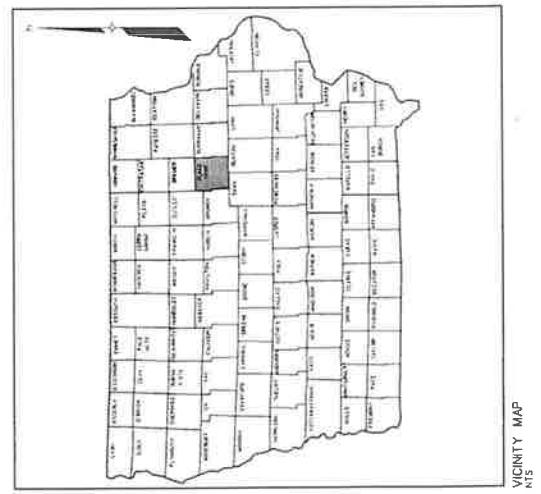


INDEX OF DRAWINGS

GENERAL DRAWINGS		ARCHITECTURAL / STRUCTURAL	
G-01	GENERAL, AND ARCHITECTURAL DEFINITIONS AND SYMBOLS	AS-01	FOUNDATION PLAN
G-02	ABBREVIATIONS AND SYMBOLS	AS-02	FLOOR PLAN
G-03	ELECTRICAL ABBREVIATIONS AND SYMBOLS	AS-03	STEEL FRAMING PLAN
G-04	NOTES LEGEND AND GENERAL QUANTITIES AND ESTIMATE REFERENCE	AS-05	SECTIONS
G-05		AS-07	ARCHITECTURAL, ROOF, PLAN ELEVATIONS, AND DETAILS
		AS-09	ARCHITECTURAL SCHEDULES
		AS-10	ARCHITECTURAL DETAILS
		AS-11	STRUCTURAL, STANDARD DETAILS
		AS-12	STRUCTURAL, STANDARD DETAILS
			HVAC
			H-01
			H-02
			HVAC SCHEDULES & DETAILS
			PLUMBING
			P-01
			FLOOR PLANS, SCHEMATICS AND DETAILS
			ELECTRICAL
			E-01
			ELECTRICAL LIGHTING PLAN
			E-02
			ELECTRICAL POWER PLAN
			E-03
			ELECTRICAL SCHEDULES
			E-05
			ELECTRICAL DETAILS
			E-06

PREPARED FOR
BLACK HAWK COUNTY
SOLID WASTE COMMISSION

PREPARED BY
Earth Tech
A **tyco** International Ltd. Company

501 STAMORE STREET, SUITE 222
WATERLOO, IOWA 50703
319-232-6531

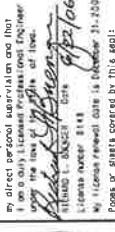I hereby certify that this Engineering document was prepared by me or under my direct personal supervision and that I am a duly licensed Professional Engineer and the responsible party for this work.  LAWRENCE J. CHAPMAN, P.E. State of Iowa Registration No. 106 Exhibit 1 - Docket No. 106 Date: 07/22/06	
My license renewal date is December 31, 2007 Prints or sheets covered by this seal: PEL INDEX OF DRAWINGS	

GENERAL LEGEND		ARCHITECTURAL AND STRUCTURAL LEGEND	
DISCIPLINE IDENTIFIER		DRAWING NUMBER DESIGNATION	
DISCIPLINE:	DISCIPLINE IDENTIFIER	DISCIPLINE IDENTIFIER	DISCIPLINE IDENTIFIER
GENERAL	C	NONE	STRUCTURE IDENTIFIER
CIVIL	C	02-000 10 02-980	DISCIPLINE IDENTIFIER (S)
STRUCTURAL	A	02-000 10 07-980	DRAWING NUMBER
MACHINES & CONTROL	M	02-000 10 08-480	
PIPEFOLDS	N	02-000 10 08-490	
PLUMBING	P	02-000 10 08-499	
HVAC	H	02-000 10 08-500	
ELECTRICAL	E	02-000 10 08-509	
FIREWALLS	R	02-000 10 08-510	
		NONE	
SECTION DESIGNATION	SECTION DESIGNATIONS USE LETTERS	SECTION DESIGNATION	SECTION DESIGNATION
ON DRAWING WHERE SECTION IS TAKEN:	ON DRAWING WHERE SECTION IS SHOWN:	ON DRAWING WHERE SECTION IS SHOWN:	ON DRAWING WHERE SECTION IS SHOWN:
10-AS-15		10-AS-1	10-AS-2
DETAIL DESIGNATION	DETAIL DESIGNATIONS USE NUMBERS	DETAIL DESIGNATION	DETAIL DESIGNATION
ON DRAWING WHERE DETAIL IS TAKEN:	ON DRAWING WHERE DETAIL IS SHOWN:	ON DRAWING WHERE DETAIL IS SHOWN:	ON DRAWING WHERE DETAIL IS SHOWN:
10-AS-2		10-AS-1	10-AS-2
STANDARD DETAIL DESIGNATION			
ON DRAWING WHERE DETAIL IS TAKEN:	ON DRAWING WHERE DETAIL IS SHOWN:	STANDARD DETAIL DESIGNATION	STANDARD DETAIL DESIGNATION
08-123		08-123	08-123
REVISIONS	REVISIONS	REVISIONS	REVISIONS
NO	NO	NO	NO

GENERAL AND STRUCTURAL
ABBREVIATIONS AND SYMBOLS

SYMBOLS	DESCRIPTION
	INSULATION NON-RADIO
	INSULATION RADIO
	ALTERNATE JOINT
	JOINT OFF BLOCK
	BLOCK
	BOT
	CENTERLINE
	COLUMN
	CONTRACTION JOINT
	CUT
	CONCRETE MASONRY UNIT
	CONTINUOUS CONCRETE
	DOUBBLE CONCRETE
	DIA.
	DOWN
	DWG.
	EACH
	END
	EQUIP.
	EXP.
	EL.
	EXP. JT.
	EW.
	FE.
	FOOTING
	DRAIN
	GALV.
	GALVANIZED HOLLOW METAL
	HORIZONTAL
	HIGH POINT
	INSULATION
	INTERIOR
	LOW POINT
	LONG LEG VERTICAL
	MASONRY
	MANHOLE
	MINIMUM OPENING
	NO SCALE
	NO CENTER OPENING
	PERFORMED JOINT FILLER
	REINFORCED CONCRETE PIPE
	REQUIRED
	RISER
	ROOF DRAIN
	SPACE OR SPACING
	STAINLESS STEEL SOUND TRANSMISSION CLASS
	STEEL
	SQUARE
	TOP
	TOP OF STEEL
	TOP AND BOTTOM
	TYPICAL
	UNLESS NOTED OTHERWISE
	VERTICAL
	VERTICAL WOOD
	WATERSTOP WITH WELDED WIRE FABRIC
	FINE EXTINGUISHER AND CABINET
	RAILING
	STEEL ON ALL SECTION
	BAR GRATING
	PLANK GRATING

NOTE:
1. THIS IS A STANDARD LEGEND. NOT ALL
2. THE INFORMATION ON THIS PROJECT
3. IS USED ON THIS PROJECT.

DATE	JUNE 2006
PRODUCT NO.	81461
FILE NO.	C-01461
SHEET NO.	0
DRAWING NO.	G-01

ABBREVIATIONS		PIPE SYMBOLS		PIPE SPECIALTIES (HVAC)		DUCTWORK SYMBOLS		PLUMBING AND HVAC		ABBRIVATIONS AND SYMBOLS	
A	AIR	BIO	BOILER BLOW DOWN	—	GUIDE			POSITIVE PRESSURE AIR DUCT RISE	—	POSITIVE PRESSURE AIR DUCT DROP	—
AC	AIR COMPRESSOR	CP	COLD WATER DISCHARGE	—	ANCHOR			NEGATIVE PRESSURE AIR DUCT RISE	—	NEGATIVE PRESSURE AIR DUCT DROP	—
AFF	ABOVE FINISHED FLOOR	BLON	BLON DUCT	—	FLOW MEASURING DEVICE			THEMOSTATIC TRAP	—	THEMOSTATIC TRAP	—
BOD	DACK DRAFT DAMPER	CD	CF	HPS	HIGH PRESSURE SHAM			LOW PRESSURE STEAM	—	FLUID & THERMOSTATIC TRAP	—
BOD	BOTTOM OF DUCT	CE	CFH	NPS	MEDIUM PRESSURE STEAM			HIGH PRESSURE RETURN	—	BUCKET TRAP	—
CAU	COMBUSTION AIR LOUVER	CDL	CFR	NPR	NEUTRAL PRESSURE			MEDIUM PRESSURE RETURN	—	EXPANSION COMPENSATOR	—
CD	CEILING DIFFUSER	CG	CFH	PRH	WATER			LOW PRESSURE RETURN	—	MANUAL VOLUME DAMPER	—
CFH	CEILING FAN	CGH	CFH	SPH	WATER			WATER	—	BACK DRAFT DAMPER	—
CFH	CABINET HEATER	CH	CFH	THP	WATER			WATER	—	SMOKE DAMPER	—
CFH	CIRCULATING PUMP (DOMESTIC HOT WATER)	CH	CFH	WTR	WATER			WATER	—	DUCT CONNECTION	—
DC	DOOR GRILLE	CH	CFH	WTR	WATER			WATER	—	FIRE DAMPER (HIGH POSITION)	—
DF-U	DRAINAGE / VENTURE DRAINS	CH	CFH	WTR	WATER			WATER	—	1 1/2 HOUR (F1), 3 HOUR (F2)	—
DV	DRAINAGE VALVE	CH	CFH	WTR	WATER			WATER	—	FINE DAMPER (VERT POSITION)	—
EAL	EXHAUST AIR LOUVER	CH	CFH	WTR	WATER			WATER	—	1 1/2 HOUR (F1), 3 HOUR (F2)	—
EG	EXHAUST GRILLE	CH	CFH	WTR	WATER			WATER	—	INTERNAL ACoustICAL INSULATION	—
EH	EXHAUST HOOD	CH	CFH	WTR	WATER			WATER	—	PRESSURE SWITCH	—
ER	EXHAUST REGISTER	CH	CFH	WTR	WATER			WATER	—	FLUID CIRCULATION PUMP	—
ESP	EXTERNAL STATIC PRESSURE	CH	CFH	WTR	WATER			WATER	—	FLOW SWITCH	—
EWC	ELECTRIC WATER COOLER	CH	CFH	WTR	WATER			WATER	—	OPs	—
FUD	FAN COIL UNIT	CH	CFH	WTR	WATER			WATER	—	PRESSURE SWITCH	—
FVD	FRP VOLUME DAMPER	CH	CFH	WTR	WATER			WATER	—	AIR VENT	—
H&C	HOT AND COLD WATER	CH	CFH	WTR	WATER			WATER	—	THEMOMETER	—
HCU	HOT RECOVERY UNIT	CH	CFH	WTR	WATER			WATER	—	WATER MAIN VALVE	—
HNU	HEATING & VENTILATING UNIT	CH	CFH	WTR	WATER			WATER	—	WALL INTEGRANT (NON-FREEZE)	—
HWA	HIGH WATER ALARM	CH	CFH	WTR	WATER			WATER	—	HOSE BIBB	—
HWL	HIGH WATER LEVEL	CH	CFH	WTR	WATER			WATER	—	QS COCK	—
IH	INLINE H-COD	CH	CFH	WTR	WATER			WATER	—	CAUSE COCK	—
ID	LINEAR DIFFUSER	CH	CFH	WTR	WATER			WATER	—	PRESSURE REGULATING VALVE	—
LG	LINEAR GRILLE	CH	CFH	WTR	WATER			WATER	—	PIPE DIRECTION	—
MAU	MAKE-UP AIR UNIT	CH	CFH	WTR	WATER			WATER	—	BLIND FLANGE	—
MBP	MOP BASH	CH	CFH	WTR	WATER			WATER	—	PLUG VALVE	—
MOD	MOTOR OPERATED DAMPER	CH	CFH	WTR	WATER			WATER	—	QS VALVE	—
DAL	OUTDOOR AIR LOUVER	CH	CFH	WTR	WATER			WATER	—	CHECK VALVE	—
P	PUMP	CH	CFH	WTR	WATER			WATER	—	BTTERFLY VALVE	—
PA	RETURN AIR LOUVER	CH	CFH	WTR	WATER			WATER	—	PLUG VALVE	—
RC	RETURN GRILLE	CH	CFH	WTR	WATER			WATER	—	CALIBRATED	—
REL	RELIEF HOOD	CH	CFH	WTR	WATER			WATER	—	BALANCE VALVE	—
RHU	ROOF TOP UNIT	CH	CFH	WTR	WATER			WATER	—	MODULATING 3-WAY VALVE	—
SD	SQUARE DAMPER	CH	CFH	WTR	WATER			WATER	—	SOLENOID VALVE	—
SG	SUPPLY GRILLE	CH	CFH	WTR	WATER			WATER	—	MODULATING 2-WAY VALVE	—
SP	SUPPLY PUMP	CH	CFH	WTR	WATER			WATER	—	CLOSE VALVE	—
SR	SUPPLY RECISTER	CH	CFH	WTR	WATER			WATER	—	STRAINER	—
SS	SAMPLE SINK	CH	CFH	WTR	WATER			WATER	—	TEMPERATURE CONTROL	—
TCP	TEMPERATURE CONTROL PANEL	CH	CFH	WTR	WATER			WATER	—	PRESSURE REDUCING STATION (AS-BUILT)	—
TD	TRANSFER DUCT	CH	CFH	WTR	WATER			WATER	—	PIPS	—
TOD	TOP OF DUCT	CH	CFH	WTR	WATER			WATER	—	REL	—
TPF	TOP OF DUCT PRESSURE	CH	CFH	WTR	WATER			WATER	—	SWR	—
U	UNBAL.	CH	CFH	WTR	WATER			WATER	—	SHOWER DETECTOR	—
VO	VOLUME DAMPER (MANUAL)	CH	CFH	WTR	WATER			WATER	—	H-0-A	—
VTR	VENT THROUGH ROOF	CH	CFH	WTR	WATER			WATER	—	HAN-D-Off-AUTO	—
WSU	WATER SUPPLY PRESSURE UNITS	CH	CFH	WTR	WATER			WATER	—	FAN-Off-HAN	—

NOTE: THIS LIST OF ABBREVIATIONS AND SYMBOLS
1. THIS LIST OF ABBREVIATIONS AND SYMBOLS
AND DRAWINGS ARE SWARD & ALL USED IN THESE CONTRACTS

DRAWINGS

GENERAL NOTES

1. AFFRAGE WITH THE VARIOUS UTILITY COMPANIES FOR SUPPORT OR RELOCATING AND SUPPORTING OR RELOCATING UTILITIES, AND/OR UTILITY POLES SHALL BE PAID BY THE CONTRACTOR. CONTACT IONA ONE CALL 1-800-292-8981 FOR EXISTING UTILITIES LOCATIONS PRIOR TO EXCAVATION.

2. WHERE PUBLIC UTILITY FIXTURES ARE SHOWN AS EXISTING ON DRAWINGS OR ENCOUNTERED WITHIN THE CONSTRUCTION AREA, IT SHALL BE THE RESPONSIBILITY OF THE CONTRACTOR TO NOTIFY OWNERS OF SERVICES PRIOR TO BEGINNING CONSTRUCTION. CONTRACTOR SHALL OBTAIN ACCESS TO THESE FACILITIES FOR NECESSARY MOUVEMENT OF EQUIPMENT, SERVICES, AND UTILITIES. STUDIES AND UTILITIES SHALL BE MADE BY CONTRACTOR TO DETERMINE WHETHER IT IS POSSIBLE TO REMOVE THESE FACILITIES FROM THE CONSTRUCTION AREA. IF IT IS POSSIBLE, CONTRACTOR SHALL REMOVE THESE FACILITIES. THE CONTRACTOR'S RESPONSIBILITY IS TO DETERMINE THE EXISTENCE AND EXACT LOCATION AND TO AVOID DAMAGE THERETO. NO CLAIMS FOR ADDITIONAL COMPENSATION WILL BE ALLOWED TO CONTRACTOR FOR ANY INTERRUPTION OR DELAY CAUSED BY SUCH WORK.

3. PROVIDE, EFFECT AND MAINTAIN AT ALL TIMES DURING THE PROGRESS AND SUSPENSION OF THE WORK, AND UNTIL COMPLETION OF THE PROJECT, ACCEPTANCE OF NEWLY SITUATED AND RELOCATED UTILITIES SIGNS AND OTHER INDICATIVE MARKINGS AS MAY BE NECESSARY TO ENSURE SAFETY OF PUBLIC, AS WELL AS THOSE ENGAGED IN THE WORK. BARRICADES AND OBSTRUCTIONS SHALL BE MARKED AT NIGHT BY FLASHING YIELD SIGNAL LIGHTS, AND KEPT BURNING FROM SUNSET TO SUNRISE. BARRICADES AND TRAFFIC CONTROL DEVICES FOR STREETS AND HIGHWAYS, "U.S. DEPARTMENT OF TRANSPORTATION, FEDERAL HIGHWAY ADMINISTRATOR, 1978", AND THE LATEST EDITION OF LOCAL OR STATE HIGHWAY TRANSFER SPECIFICATIONS ENTHALTED SUPPLEMENTAL SPECIFICATION FOR TRAFFIC CONTROL FOR STREET AND HIGHWAY CONSTRUCTION AND MAINTENANCE OPERATIONS.

4. GRADED AREAS DISTURBED DURING CONSTRUCTION SHALL BE FINISH GRADED WITH MINIMUM 6" TOPSOIL, FERTILIZED, SEEDED AND MULCHED.

5. FINISH GRADE AND CLEANUP IMMEDIATELY BEHIND EXCAVATION AND BACKFILL OPERATIONS TO AVOID INCONVENIENCE TO PUBLIC.

6. PROVIDE COMPACTED STRUCTURAL BACKFILL FOR TRENCHES BEING HAD CONCRETE AND MM PAVED SURFACES.

7. GRADE ALL AREAS TO GRAIN.

8. DO NOT DISBURST TREES UNLESS NOTED OTHERWISE.

9. MINIMIZE DISTURBANCE TO EXISTING DRIVES, SIDEWALKS AND GRASSED AREAS.

10. PROVIDE MIN. 5' FEET COVER OVER ALL WATER LINES.

11. SAW CUT AND REMOVE MIN. 6"-WIDE STRIP OF EXISTING PAVEMENT AT LOCATIONS WHERE NEW PAVEMENT IS TO BE INSTALLED. PAVEMENT, NO SERVICING REQUIREMENTS, COST INCIDENTAL TO CONSTRUCTION.

12. COST OF REMOVAL AND RELOCATION OF EXISTING SIGNS WITHIN LIMITS OF CONSTRUCTION IS INCIDENTAL TO PROJECT.

13. COST FOR REMOVAL AND RELOCATION OF BOULDERS ALONG EDGE OF ACCESS ROAD IS INCIDENTAL TO CONSTRUCTION.

14. CONTRACTOR SHALL APPLY PRECISELY NOT STORE TO CONSTRUCTION AREA AND HAUL ROADS TO PREVENT SPREAD OF DUST.

15. NO FERTILIZER OR OTHER CHEMICALS SHALL BE APPLIED WITHIN A 50-FOOT RADIUS OF MONITORING WELLS.

16. MONITORING WELLS LOCATED NEAR CONSTRUCTION AREA SHALL NOT BE DAMAGED OR DISTURBED IN ANY WAY. CONTRACTOR SHALL BE RESPONSIBLE FOR ALL COSTS INCURRED DUE TO DAMAGE TO MONITORING WELLS.

17. USE BORROW EXCAVATION FROM FUTURE CELL #1 TO CONSTRUCT ENHANCEMENTS.

18. WORK SHALL BE CONDUCTED IN ACCORDANCE WITH BLACK HAWK COUNTY SANITARY LANDFILL'S HAZARDOUS POLLUTION PREVENTION PLAN.


19. COORDINATE WITH OWNER LOCATION OF EARTH BURROW AND CLAY BORROW WITHIN FUTURE CELL #1 SITE.

20. ALL STORM SEWER AND CULVERTS ARE CLASS 3 REINFORCED CONCRETE.

STAGING NOTES

1. STAGE CONSTRUCTION OF IMPROVEMENTS TO MAINTAIN CUSTOMER TRAFFIC OVER EXISTING SCALE, EXISTING ACCESS ROAD AND SMALL LOAD AREA, UTILIZING PUBLIC UTILITIES AND EXISTING ACCESS ROAD, SCALE AND SCALE HOUSE ARE COMPLETE AND READY FOR OPERATION.
2. COMPLETE AS MUCH NEW CONSTRUCTION AS POSSIBLE PRIOR TO PLACING NEW SCALE AND SCALE HOUSE IN OPERATION.
3. STATE PAYMENT REFUND AND RECONSTRUCTION ON EXISTING ACCESS ROAD NORTH SIDE OF NEW SCALE TO PERMIT UNINTERRUPTED TRAFFIC FLOW TO EAST HILL ROAD. CONSTRUCTION OF SUITABLE RUN AROUND ROADWAY, MAINTENANCE EXPENSE IF REQUIRED TO STATE UNINTERRUPTED ACCESS.
4. DO NOT ROUTE TRAFFIC OVER NEW SCALE UNTIL NEW COMPUTER AND SOFTWARE IS INSTALLED AND READY FOR OPERATION. CODORICAT WITH OWNER TO PROVIDE SMOOTH TRANSITION OF OPERATION FROM OLD SCALE FACILITY TO NEW FACILITY.
5. PROVIDE OWNER WITH DETAILED STAGING PLAN FOR OWNER AND ENGINEER REVIEW PRIOR TO COMMENCING PROJECT CONSTRUCTION.

SYMBOLS LEGEND

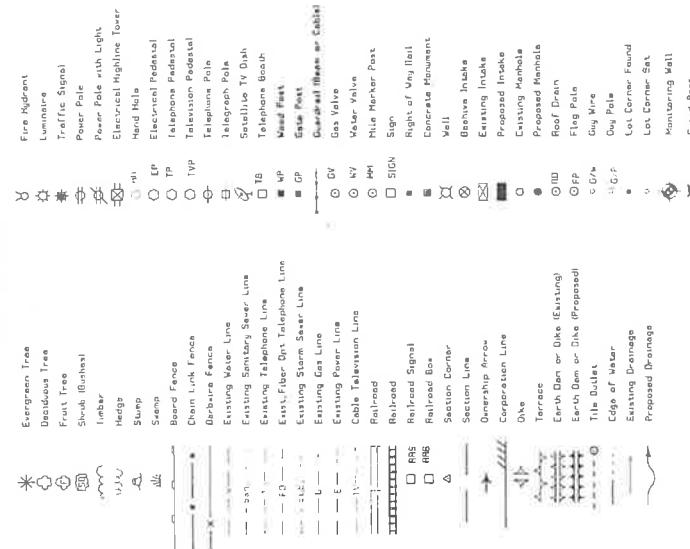

DATE	JUNE 2006
PROJECT NO.	HWY 10295
FILE NUMBER	01-G-4-DGW
SCALE NO.	Sheet No 4

ESTIMATE REFERENCE NOTES

1. REFER TO SECTION 11100. SURROUNDING DECK AREA, BARRIER GATES AND FENCE, CLOTHESLINE POLES, CLOTHESLINE, SHOWER ON PLANS OR OTHERWISE REQUIRED.
2. INCLUDES REINFORCED CONCRETE HOUSE, BARRIER GATES AND FENCE, CLOTHESLINE POLES, CLOTHESLINE, SHOWER ON PLANS OR OTHERWISE REQUIRED.
3. REFER TO SECTION 02211.
4. REFER TO SECTION 02211.
5. REFER TO SECTION 02211.
6. REFER TO SECTION 02211.
7. REFER TO SECTIONS 02215 AND 02210. LUMP SUM PRICE INCLUDES TOPSOIL STRIP, SALVAGE, STOCKPILE, AND SPREAD, EARTHEN EXCAVATION AND EXPANSION, COMPLETE IN SCAFFOLD AND SHEAR HOUSE AREA LOCATED EAST AND NORTH OF ACCESS ROAD.
8. REFER TO SECTION 02510 AND TYPICAL CROSS SECTIONS.
9. REFER TO SECTION 02510 AND TYPICAL CROSS SECTIONS.
10. REFER TO SECTION 02510 AND TYPICAL CROSS SECTIONS.
11. REFER TO SECTION 02511 AND TYPICAL CROSS SECTIONS.
12. REFER TO SECTION 02511 AND TYPICAL CROSS SECTIONS.
13. INCLUDES CONCRETE PAVEMENT AREAS INDICATED ON PLANS. REFER TO SECTION 02510.
14. REFER TO SECTION 02510 AND PLANS.
15. REFER TO SECTION 02510 AND PLANS.
16. REFER TO SECTION 02611. STORM SEWER WILL BE MEASURED FROM END OF PIPE TO END OF PIPE (NOT INCLUDING APHONS) FOR PAYMENT. ALSO INCLUDES JOINING JOINTS FOR LAST 2' PIPE JOINTS FROM END.
17. REFER TO SECTION 02611. STORM SEWER WILL BE MEASURED FROM INSIDE WALL OF STRUCTURE TO INSIDE WALL OF STRUCTURE OR EXCAVATION.
18. REFER TO SECTION 02611 AND TYPICAL CROSS SECTIONS.
19. INCLUDES CONCRETE PAVEMENT FOR A 1' X 3' PAVING AREA. ALSO INCLUDES CONCRETE PAVEMENT FOR A 1' X 3' PAVING AREA.
20. OUTLET APHONS INCLUDE DIA 14 TYPE 2 PIPE CONNECTORS ON APHON JOINT. REFER TO SECTION 02611.
21. OUTLET APHONS INCLUDE DIA 14 TYPE 2 PIPE CONNECTORS ON APHON JOINT. REFER TO SECTION 02611.
22. REFER TO SECTION 02445.
23. REFER TO SECTION 02514. MEASUREMENT AND PAYMENT PER LINEAL FOOT INCLUDES FITTINGS.
24. REFER TO SECTION 02514. CONNECITON TO EXISTING SERVICE LINE.
25. REFER TO SECTION 02514. MEASUREMENT AND PAYMENT PER LINEAL FOOT INCLUDES CURB STONE AND TAPPING EXISTING LINE.
26. INCLUDES ERUPTIONS AND GUARD RAILING FOR GUARD RAIL PROVIDED IN PLATEAU AT LOCATIONS INDICATED.
27. INCLUDES VIDEO SURVEILLANCE CAMERAS IN LOCATIONS SHOWN IN PLANS INCLUDING POLS AND ALL NECESSARY WIRING COMPLETE.
28. INCLUDES FURNISHING AND INSTALLING KEY GRATED PLATFORMS AND MODIFICATIONS TO EXISTING GRATED PLATFORMS AS REQUIRED AT THE LOCATIONS SHOWN.
29. INCLUDES REMOVAL AND DISPOSAL OF FENCE IN LOCATIONS SHOWN ON PLANS. NO SEPARATE PAYMENT FOR FURNISHING AND INSTALLING NEW END POSTS TO TERMINATE EXISTING FENCING.
30. MEASURE IN AND INSTALL PER LINEAL FOOT INCLUDES FENCE AND POSTS COMPLETE. REFER TO SECTION 02821.
31. INCLUDES CONCRETE PAVEMENT, OPERATING ELECTRICAL SERVICE, AND CONTROLS. REFER TO SECTION 02601.
32. 100' OF SEEDED GRASS HAS BEEN PRODUCED AND PLANTED IN ACCORDANCE WITH SECTION 2601.08 OF THE CONTRACT DOCUMENTS.
33. IF NO SEEDING CONTRACT IS PROVIDED, THE CONTRACTOR SHALL PROVIDE SEEDING CONTROL, PLANT, FERTILIZE, SEED AND MAINTAIN PLANTED AREAS INDICATED ON PLANS WITH STABILIZING EDGING REQUIREMENTS IN ACCORDANCE WITH APPLICABLE PROVISIONS OF SECTION 2601 OF 001 SPEC. TO SEPARATE PLANTED AREAS FROM OTHER AREAS WITH ROCK, BOULDER, PICKUP AND REMOVAL. THIS ITEM IS EXEMPT FROM SUPPLEMENTARY CONDITIONS ARTICLE 11, 03.
- 34.-35. FERTILIZE AND SEED DETERMINED AREAS INDICATED ON PLANS WITH RUBBER, OR URBAN MIX SEEDING IN ACCORDANCE WITH APPLICABLE PROVISIONS OF SECTION 2601 OF 001 SPEC. NO SEPARATE PAYMENT ALLOWED FOR DEBRIS AND ROCK, BOULDER, PICKUP AND REMOVAL. UNIT PRICE INCLUDES COST FOR MAINTAINING AREAS UNTIL AN ALIVE STAND OF GRASS HAS BEEN ESTABLISHED AND RESERVED AND AREAS NOT SHOWING GROWTH FOR DURATIONS CONTRACT DOCUMENTS.
36. PHOTOGRAPHING EXISTING FENCE ON CONSTRUCTION SITE, FENCES IN LOCATIONS SHOWN, AND OTHERWISE REQUIRED TO PREVENT STEALING FROM CONSTRUCTION SITE IN ACCORDANCE WITH PROJECT HOLLOW ON PAYMENT PLAN, TO CONSTRUCT BILLY FENCES AS DETAILED ON 100' STANDARD ROAD PLANS IN ACCORDANCE WITH SECTION 2602 OF 001 SPEC.
37. REMOVE SILT FENCE ONLY AFTER SEDED AREAS ARE ADEQUATELY ESTABLISHED AS DETERMINED BY OWNER.
38. INCLUDES RELOCATION OF BOULDERS ALONG EDGE OF ACCESS ROAD, REMOVAL OF WOOD POLE, AND CAMERA, REMOVAL OF EXISTING SIGNAL LIGHTS, REMOVAL OF SAN SEWER CLEAROUT, RELOCATION OF EXISTING SIGNS CONTAINED IN LIMITS OF CONSTRUCTION, PIPE AND APRON REMOVALS, AND OTHER SITE RELATED ITEMS NOT COVERED ELSEWHERE. REFER TO SECTION 02213.


ESTIMATED QUANTITIES


ITEM	DESCRIPTION	UNIT	ESTIMATED QUANTITY
1	100-Ton Pitless Scales Complete	LS	1
2	Scal-C House complete	LS	1
3	Mobile Trolley	LS	1
4	Access Road Topsoil 5' x 10' x 1' Stockpile	CY	2.18
5	Access Road Topsoil 5' x 10' x 1' Stockpile Across Road Between Excavation	CY	3.14
6	Scal-House Area Northbank	CY	6.568
7	8" Thick PC Concrete Paving	SY	7.150
8	6" Thick Modular Subbase	SY	50.5
9	6" Thick HMA Pavement	SY	461
10	6" Thick HMA Pavement	SY	330
11	Pavement Removal	SY	288
12	Soil Saver Line	SF	2.280
13	True Spec Pipe Subdrain Outlets	EA	4
14	1" PVC Storm Sewer	LF	152
15	1" PVC Storm Sewer	LF	108
16	1" PVC Storm Sewer	LF	48
17	1" PVC Storm Sewer Type Re-Bi Inlet	EA	1
18	1" PVC Storm Sewer Type Re-Bi Inlet	EA	1
19	30' RCP Arms	EA	2
20	30' RCP Arms	EA	2
21	12' Bar & Rod Jacked Casing Pipe	LF	25
22	12' Bar & Rod Jacked Casing Pipe	LF	23
23	1" PVC Sanitary Sewer Service	EA	1
24	1" PVC Sanitary Sewer Service	EA	1
25	1" PVC Sanitary Sewer Service	EA	1
26	Guard Posts	EA	12
27	Video Camera & Surveillance System	EA	1
28	Gated Walkway Platform	EA	1
29	Fence Removal	LF	200
30	6'-ft Chain Link Fence	LF	60
31	32'-ft Electrically Operated Chain Link Gate	EA	1
32	Matching Chain Link Gate	EA	1
33	Stabilization Mix Fertilizing and Seeding	AC	1.6
34	Bottom Mix Fertilizing and Seeding	AC	0.9
35	Bottom Mix Fertilizing and Seeding	AC	0.4
36	Silt Fence	LF	1,700
37	Silt Fence Removal	LF	1,700
38	Traffic Control	LS	1
39	Site Preparation	LS	1


EarthTech
Estimate International Ltd., Company
Quantities And Reference


SCALe AND ACCESS ROAD, WATERLOO, IOWA
BLACK HAWK CO., SOLID WASTE COMMISSION
ESTIMATE REFERENCE


DATE: JUNE 2003
PROJECT #: 91610000
FILE NAME: C:\C-G-S\Sp...
SHEET NO: 3
DRAWING NO: G-05

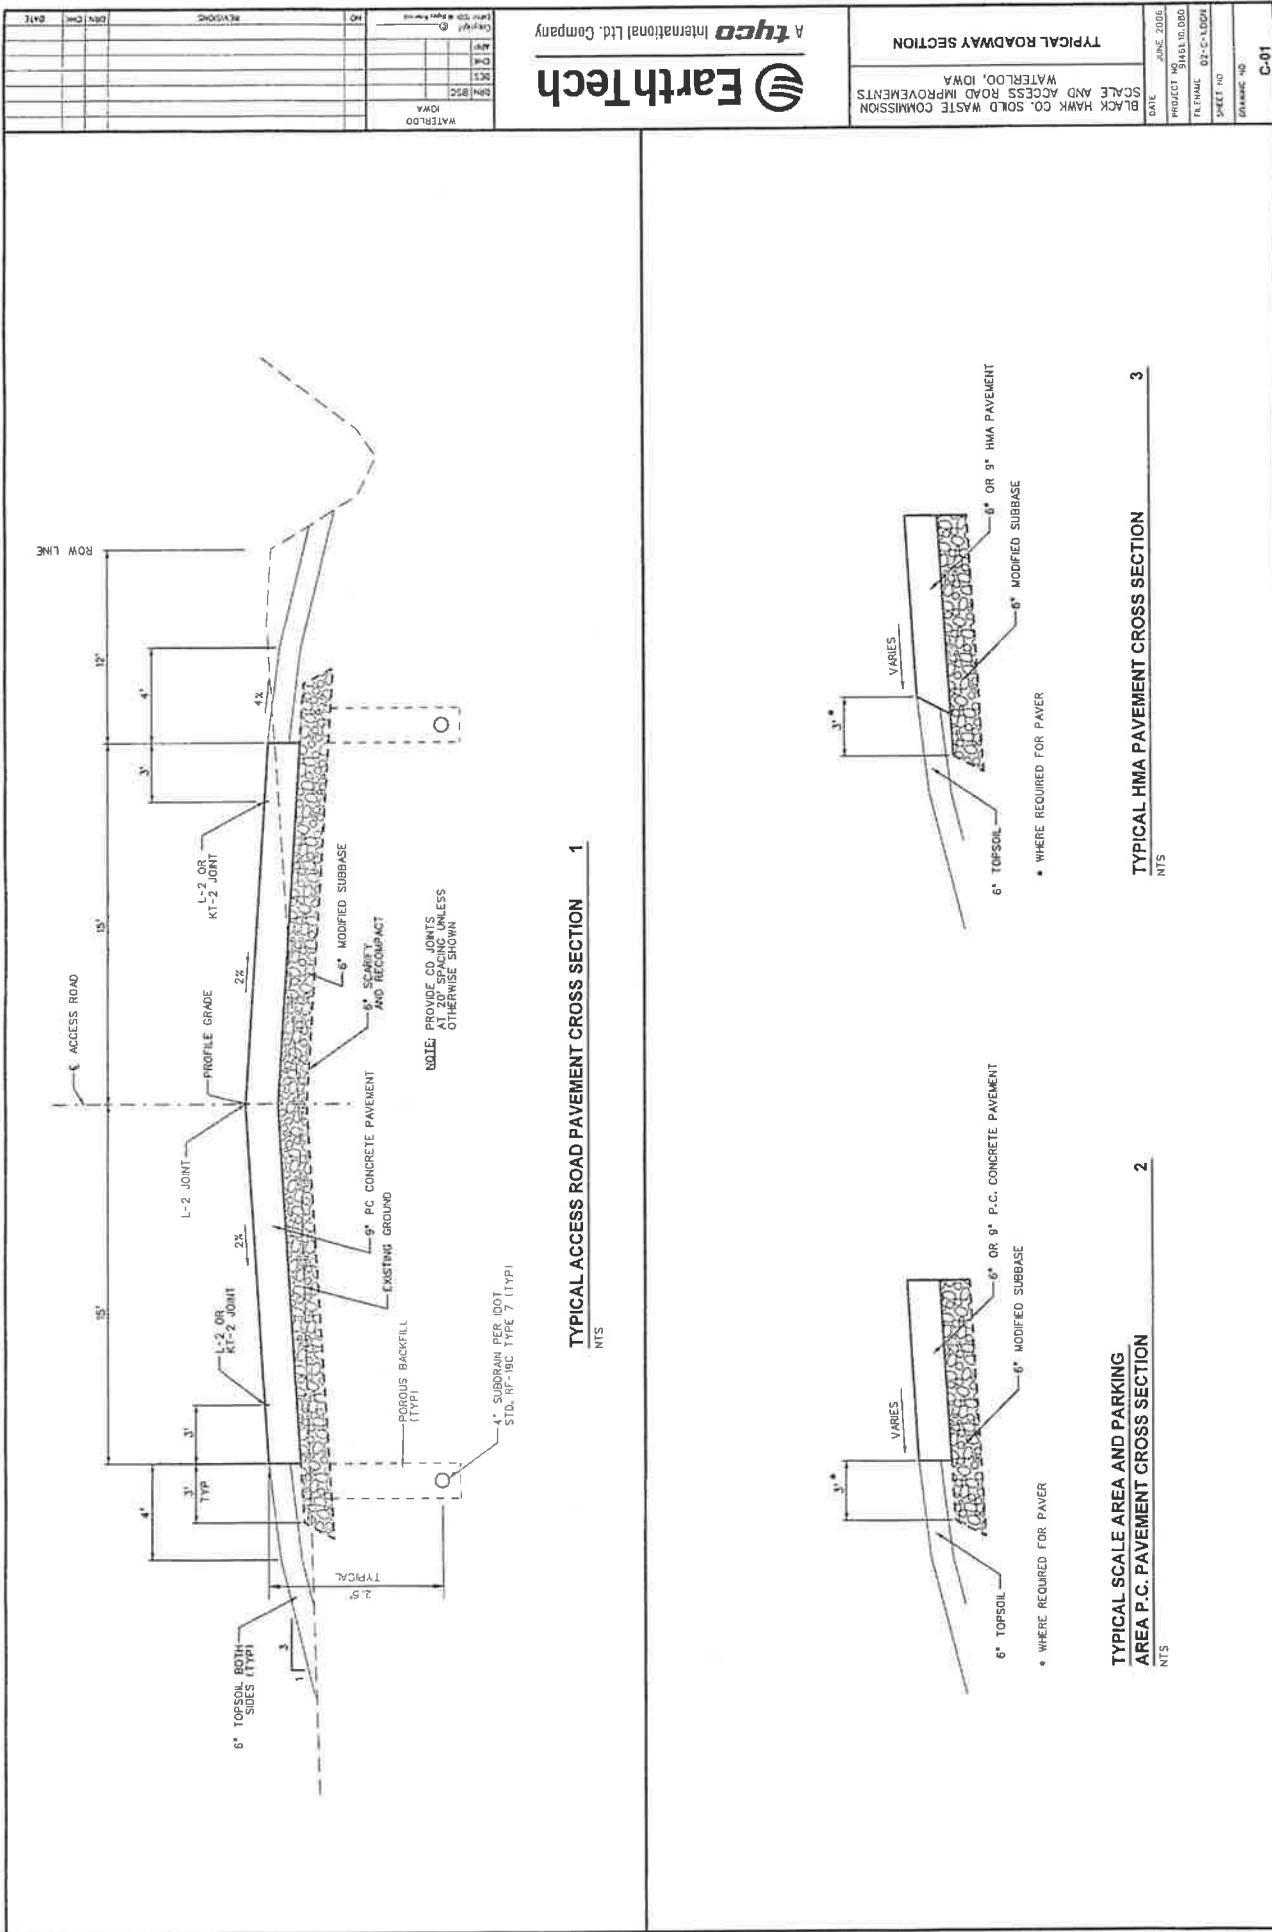


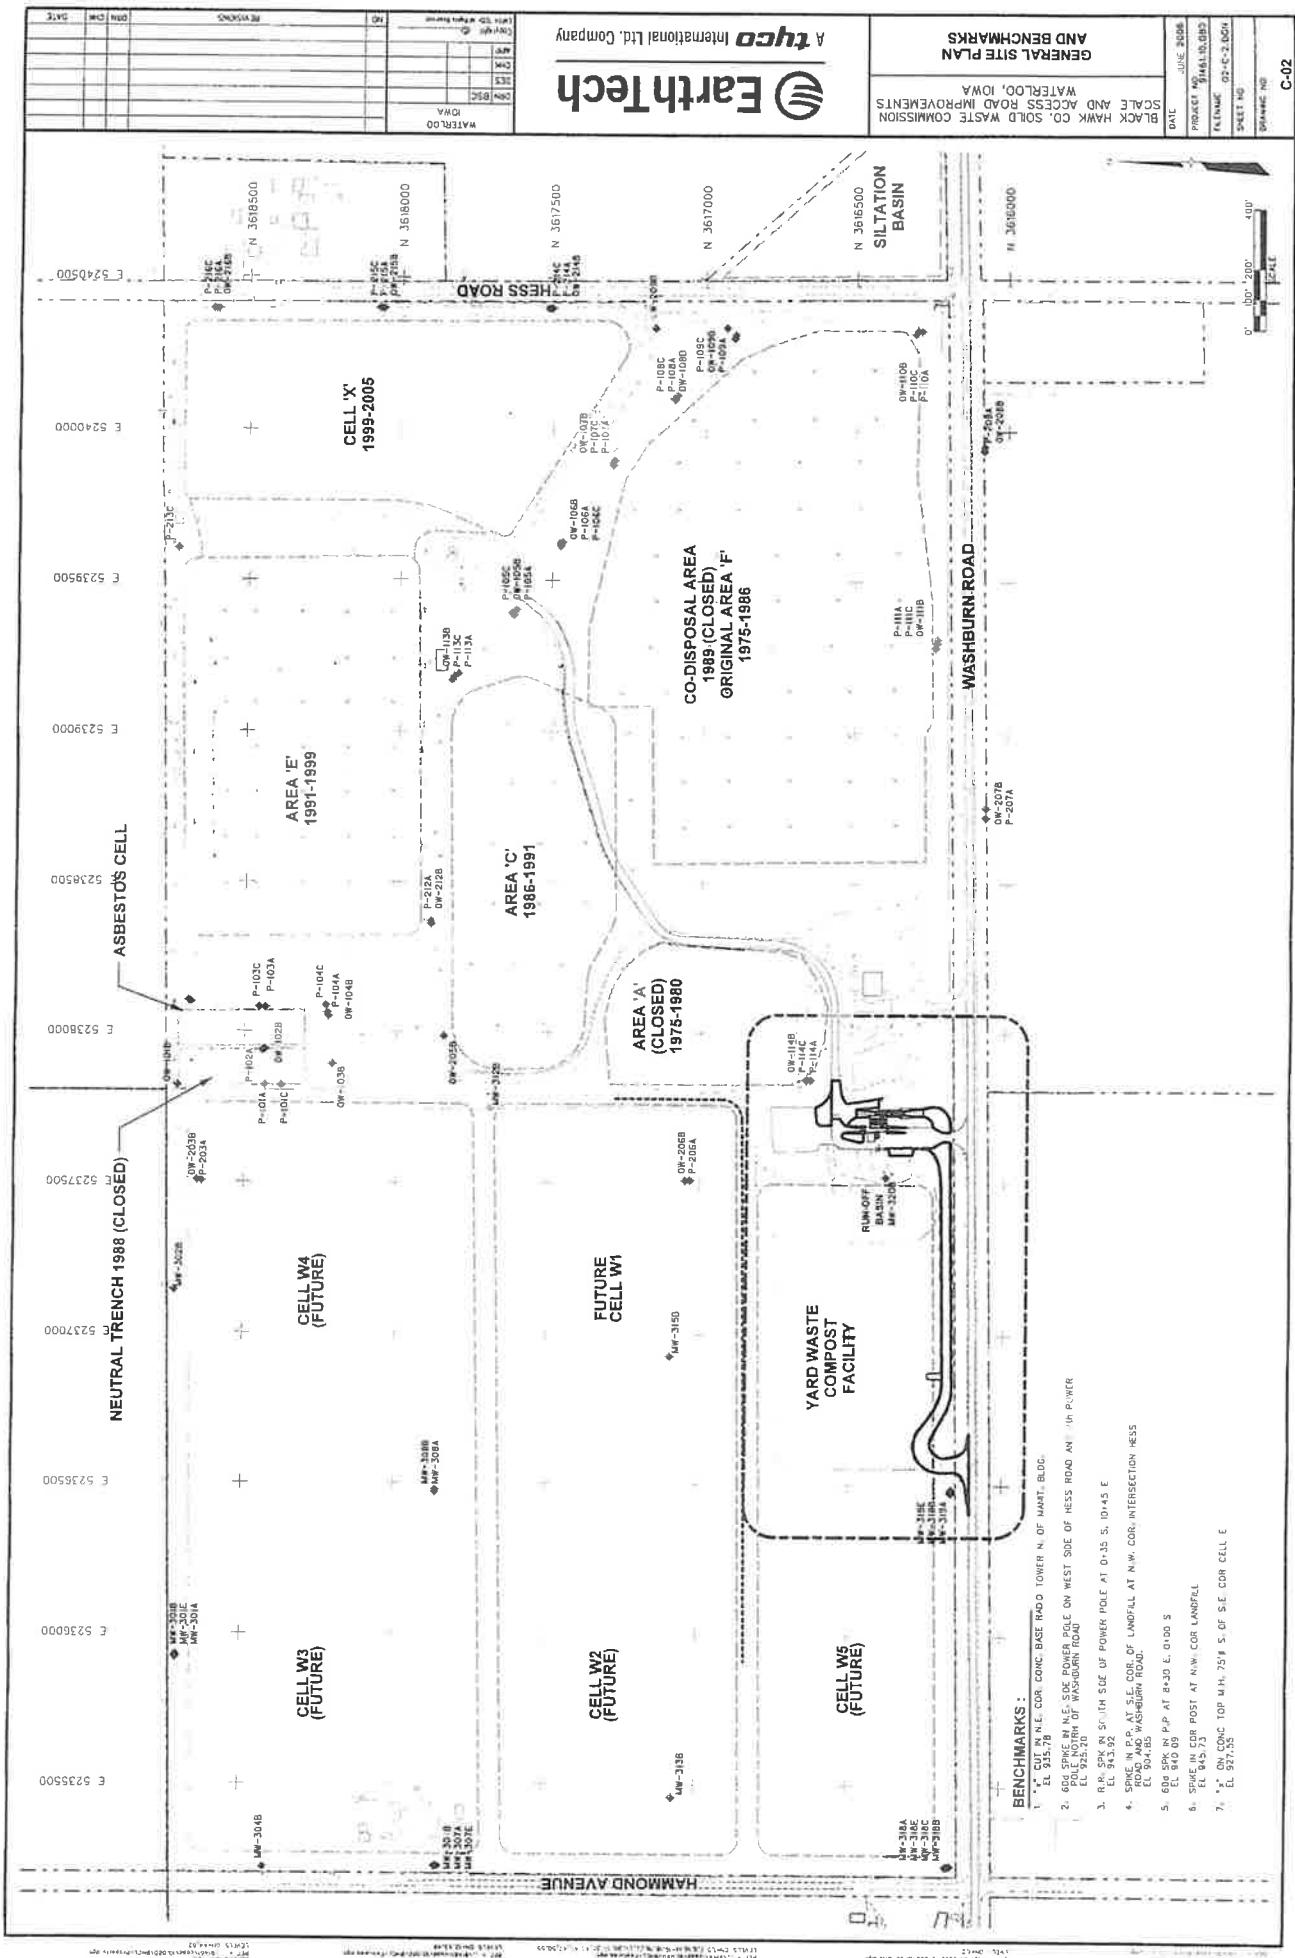


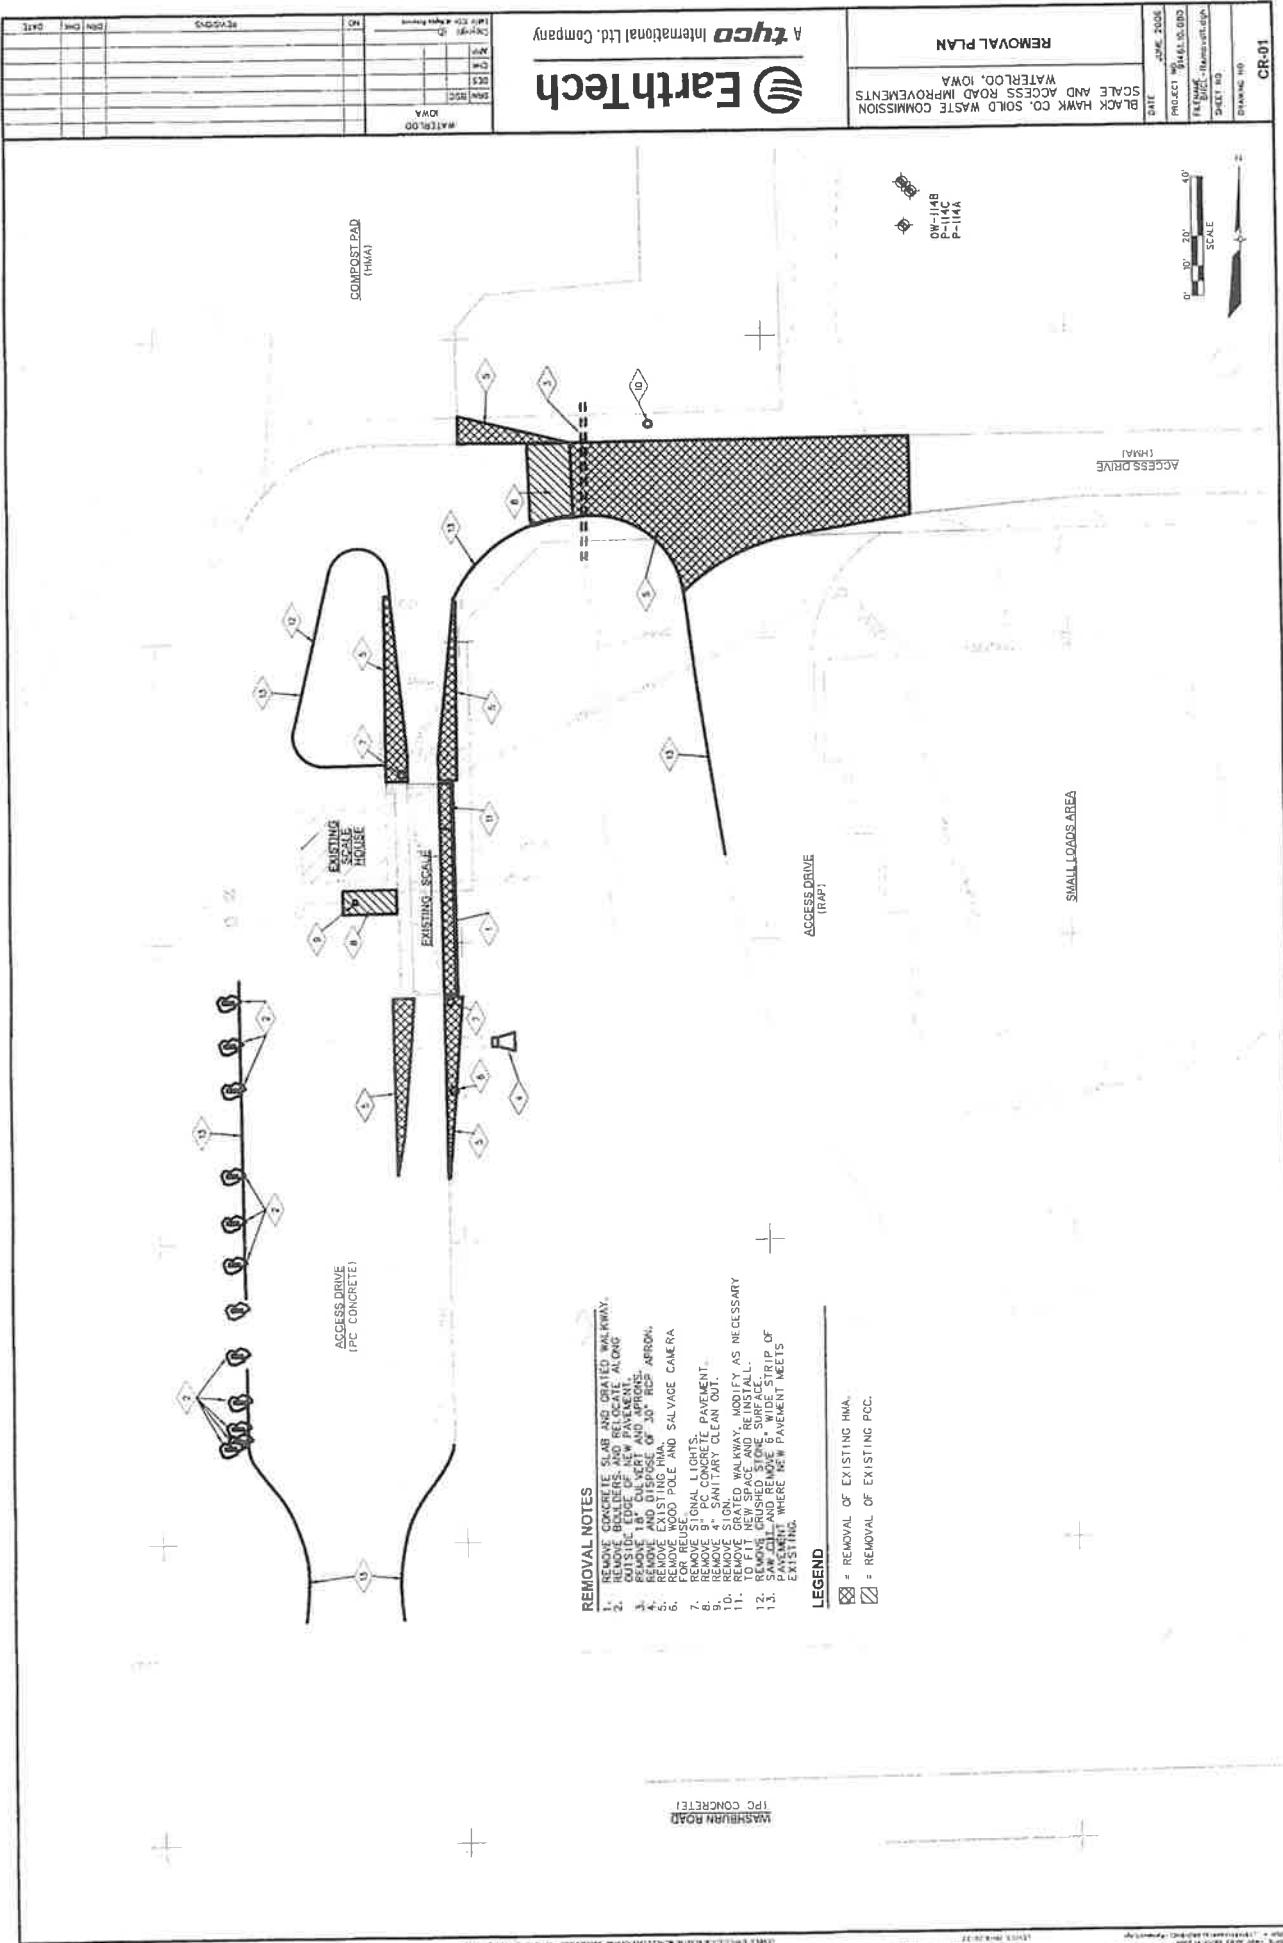


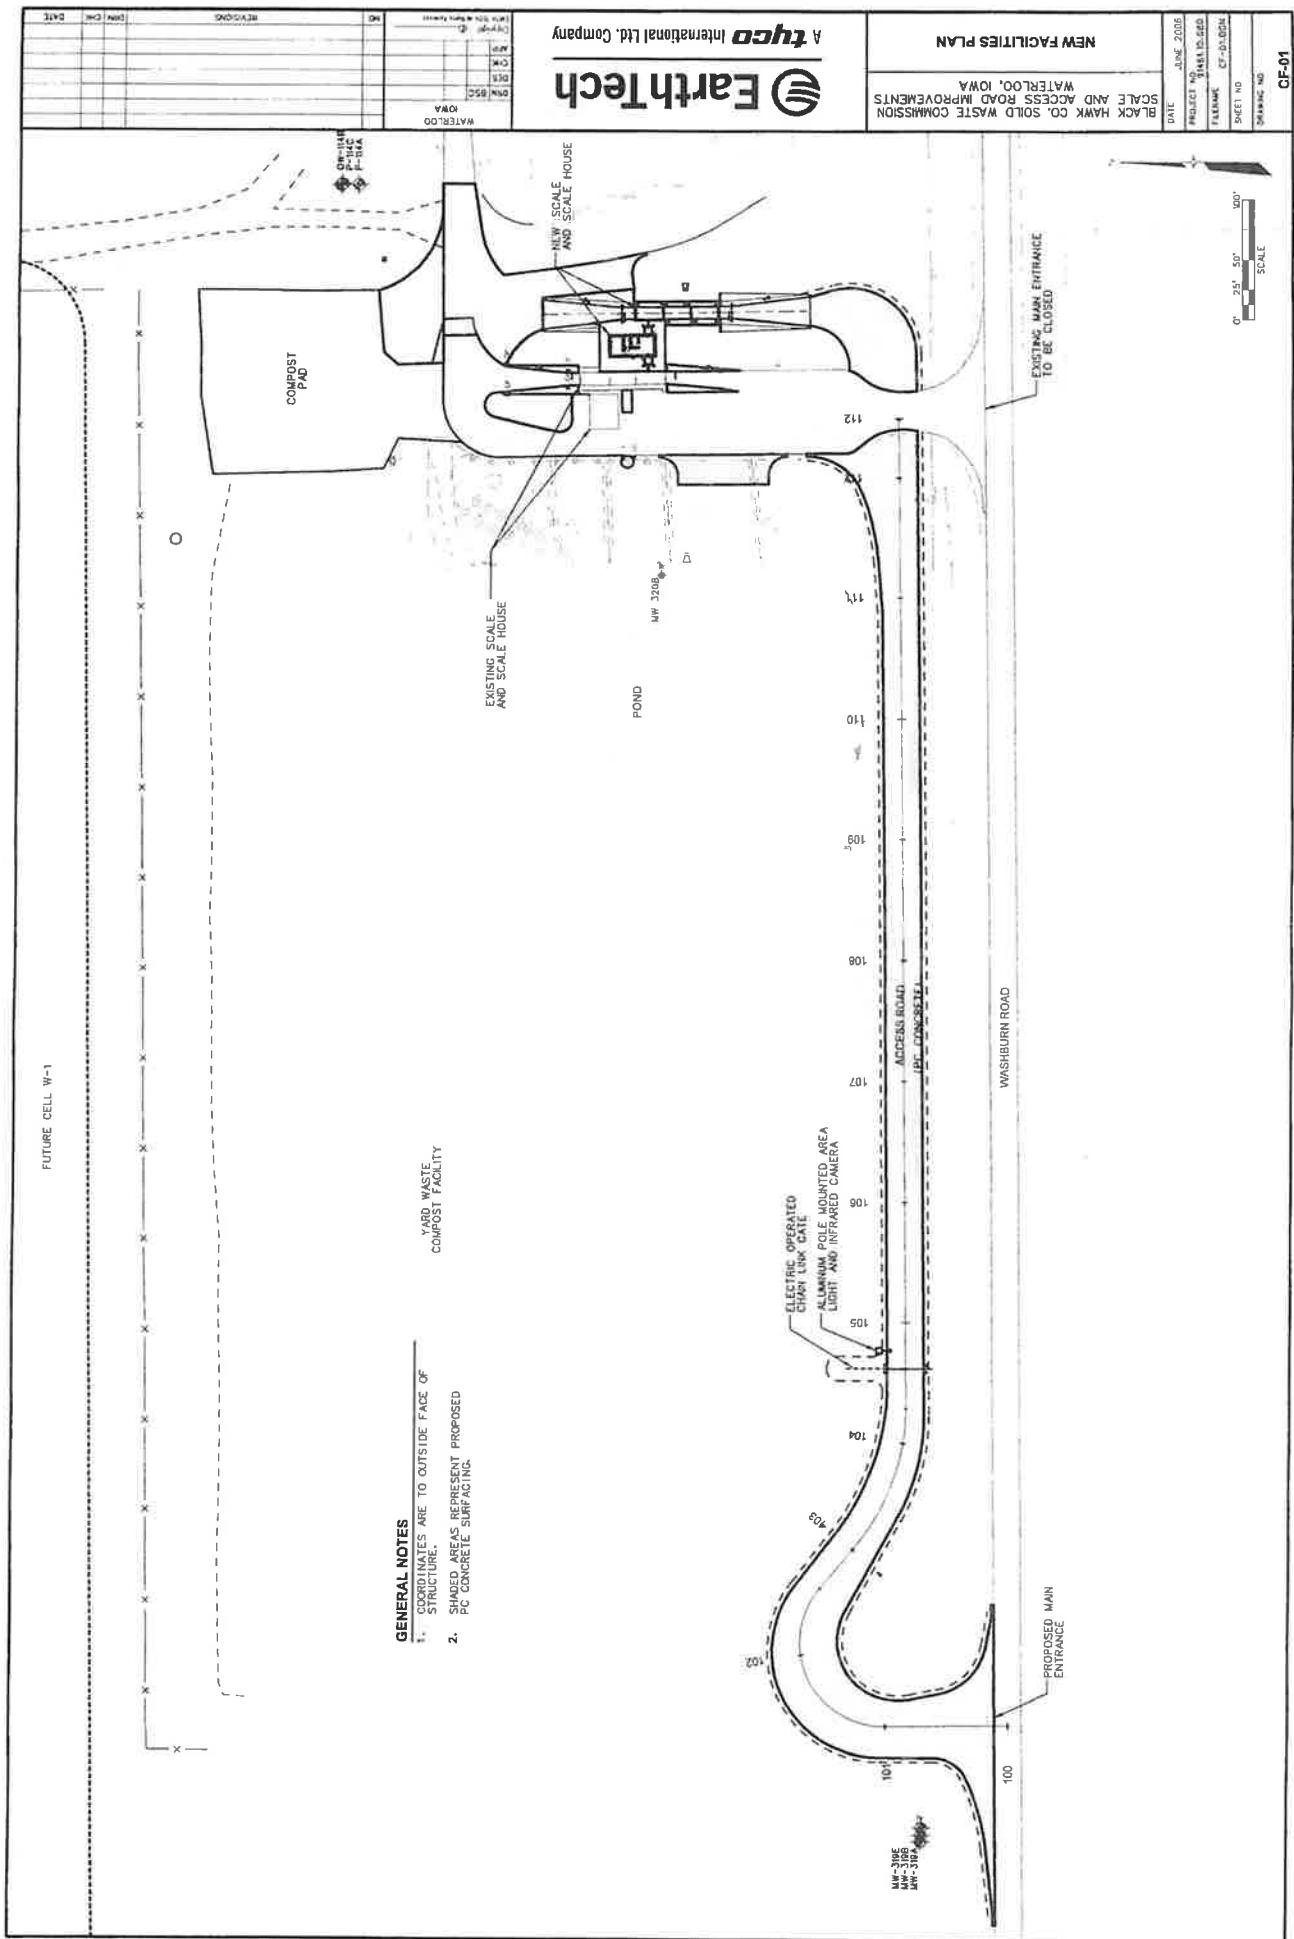


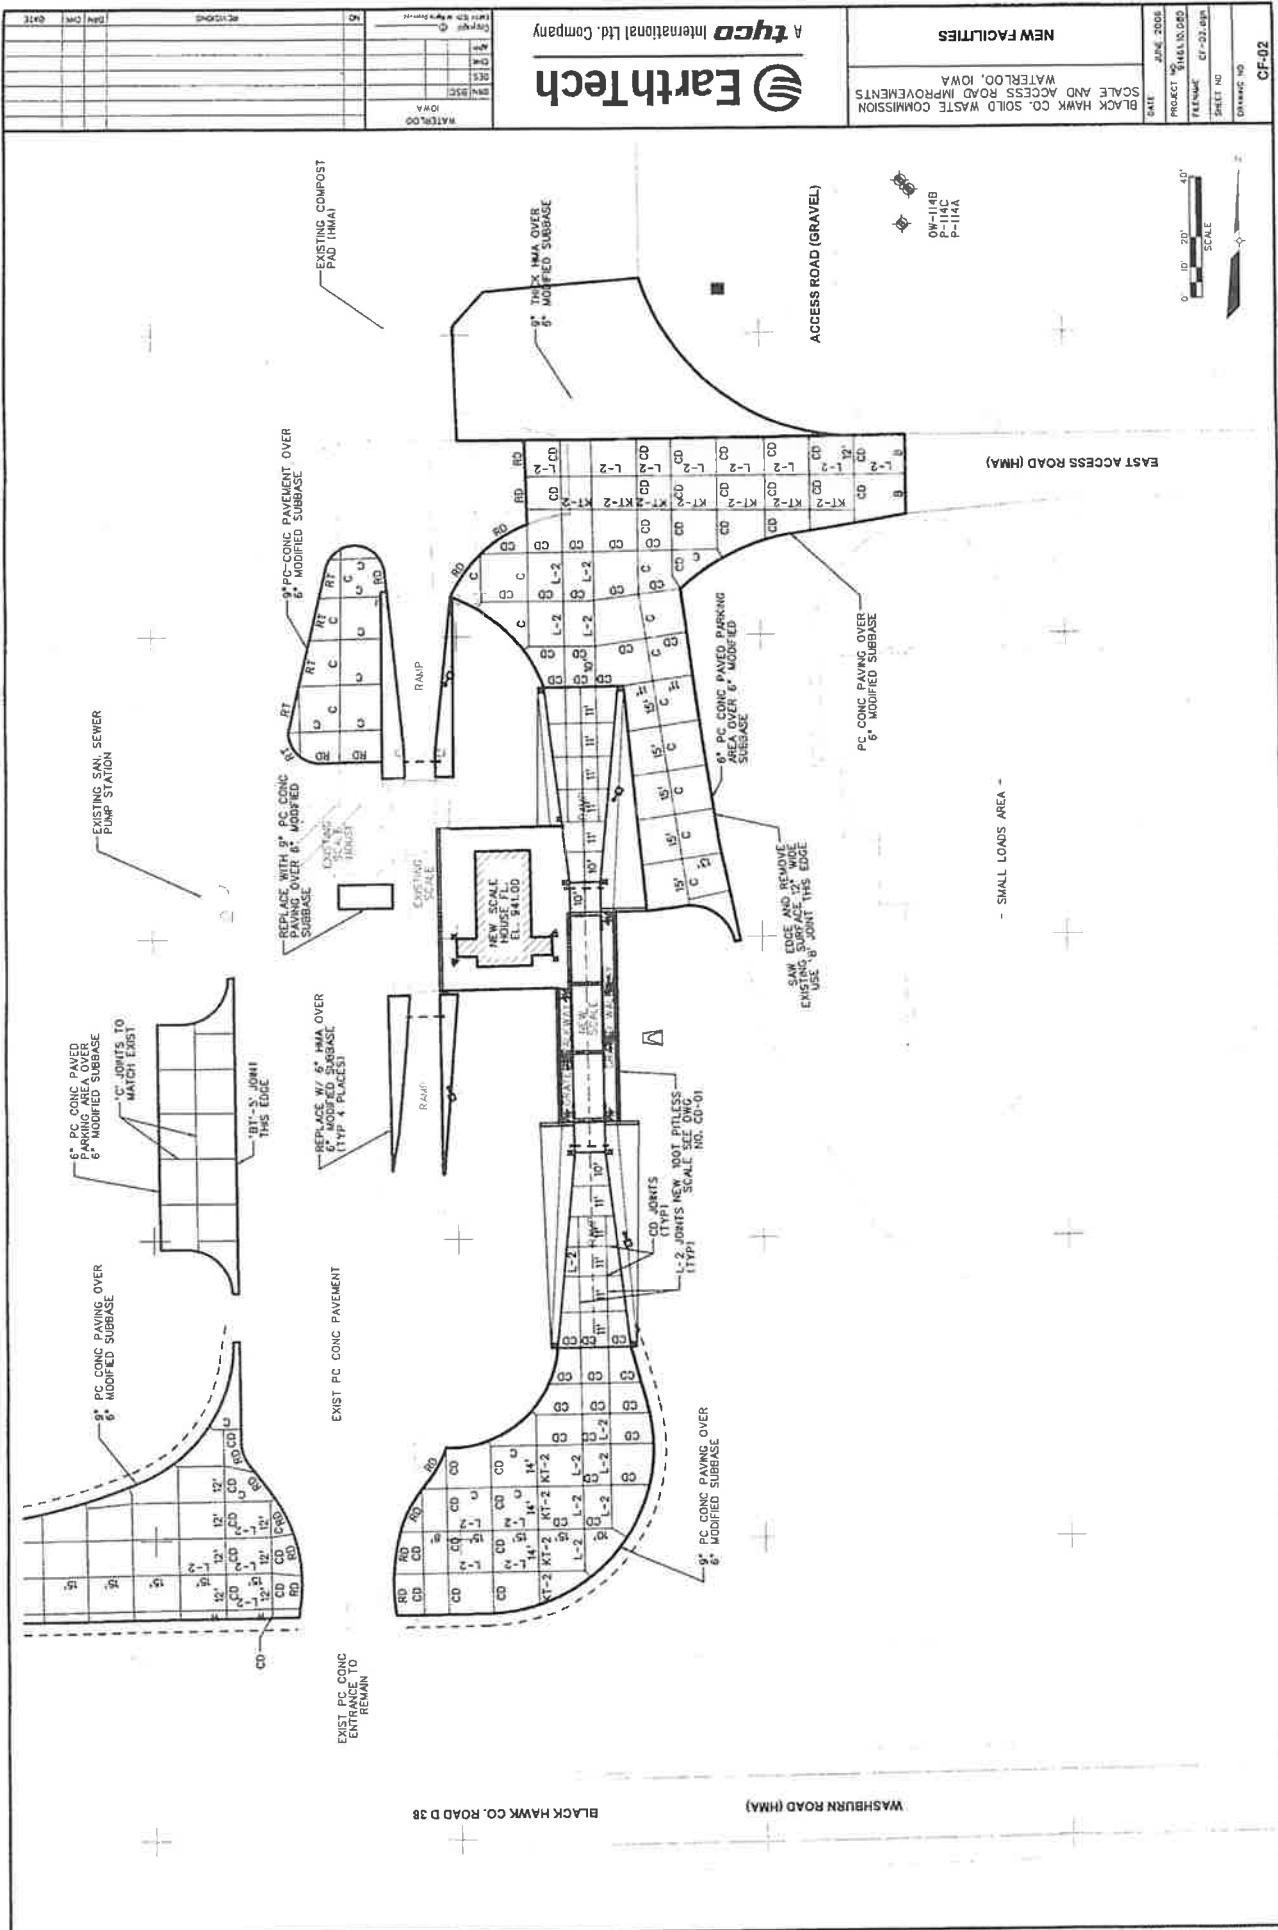


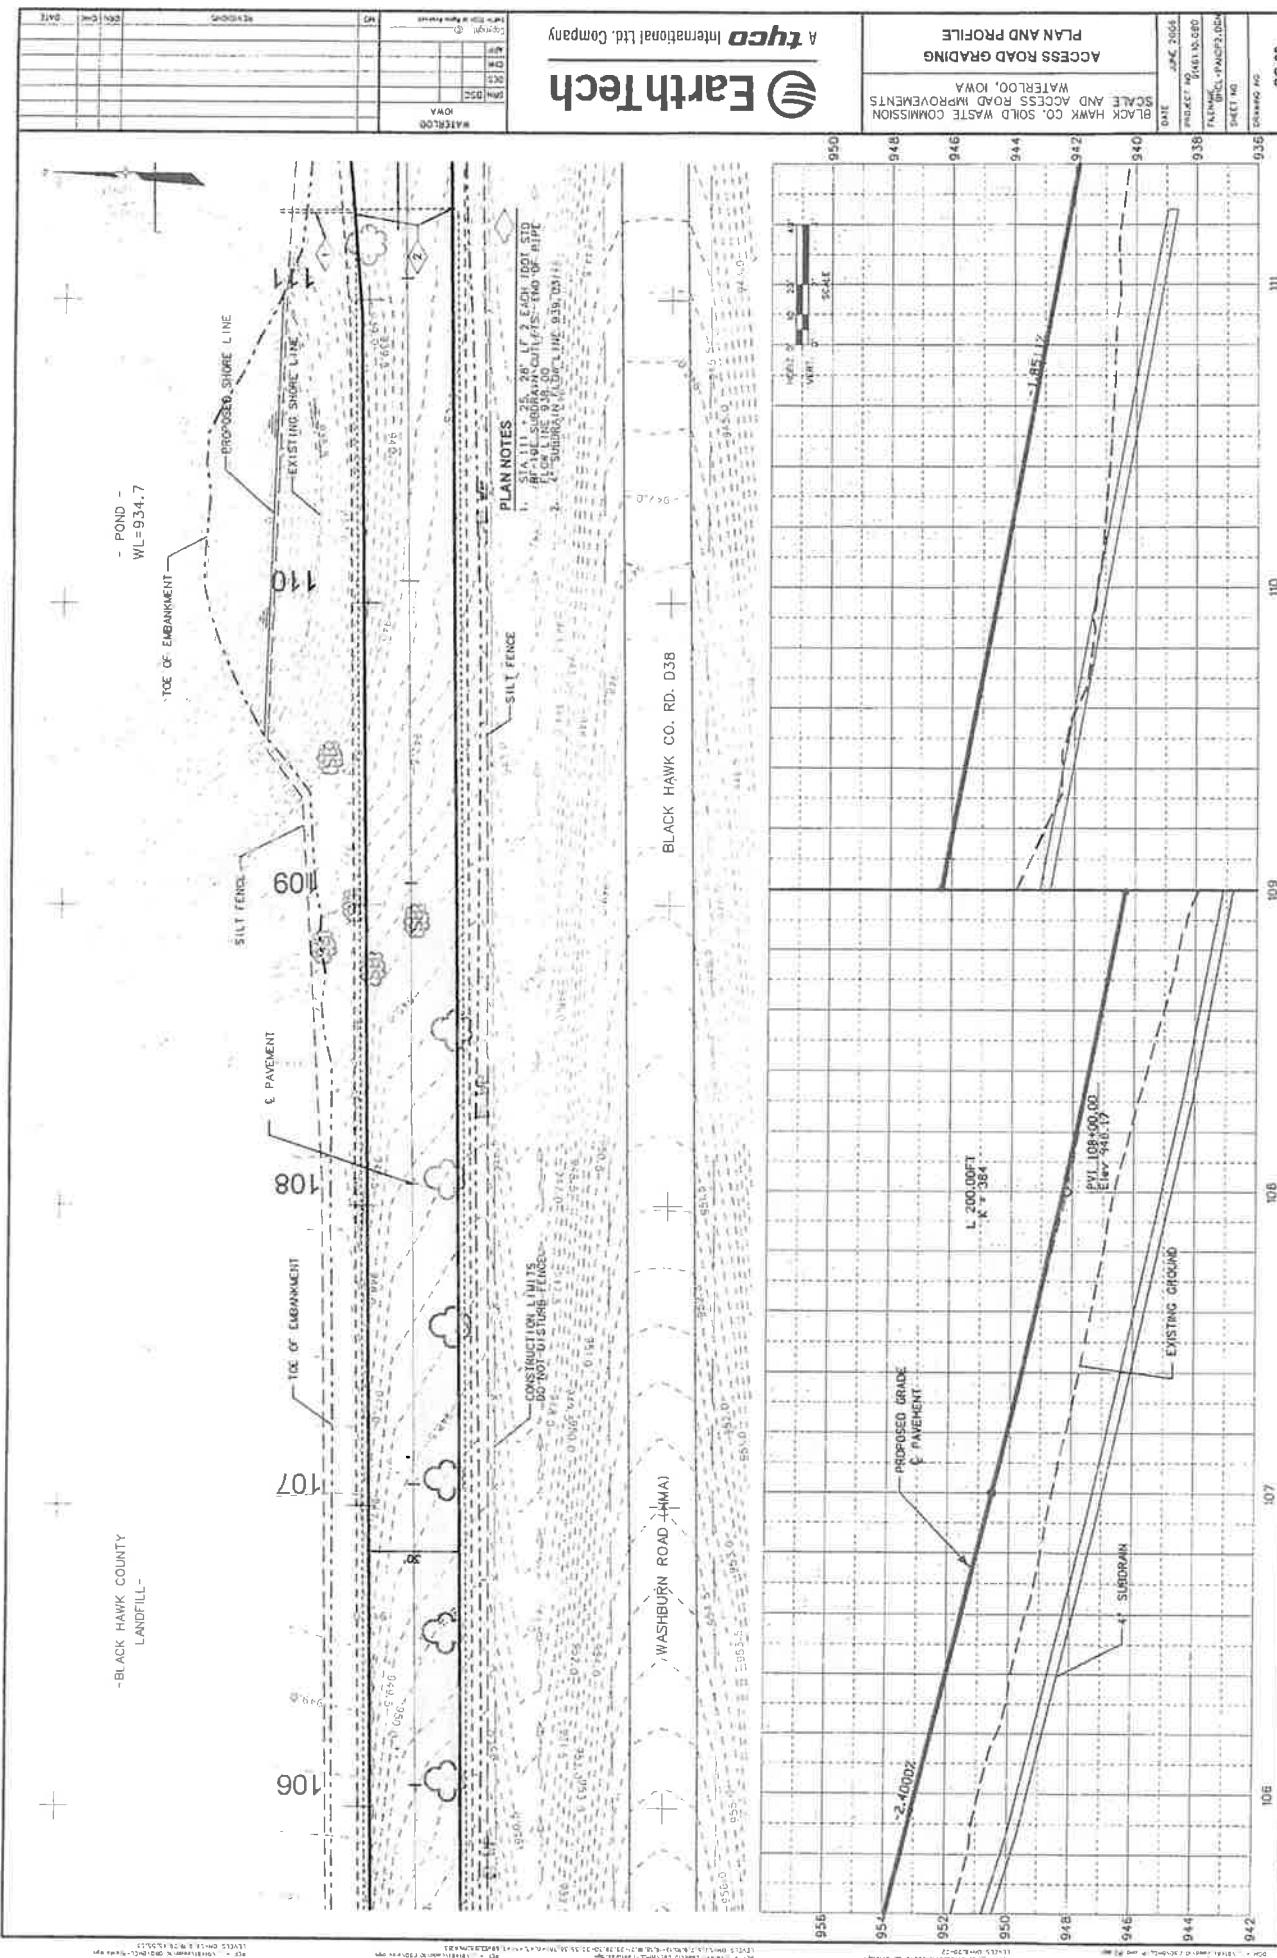


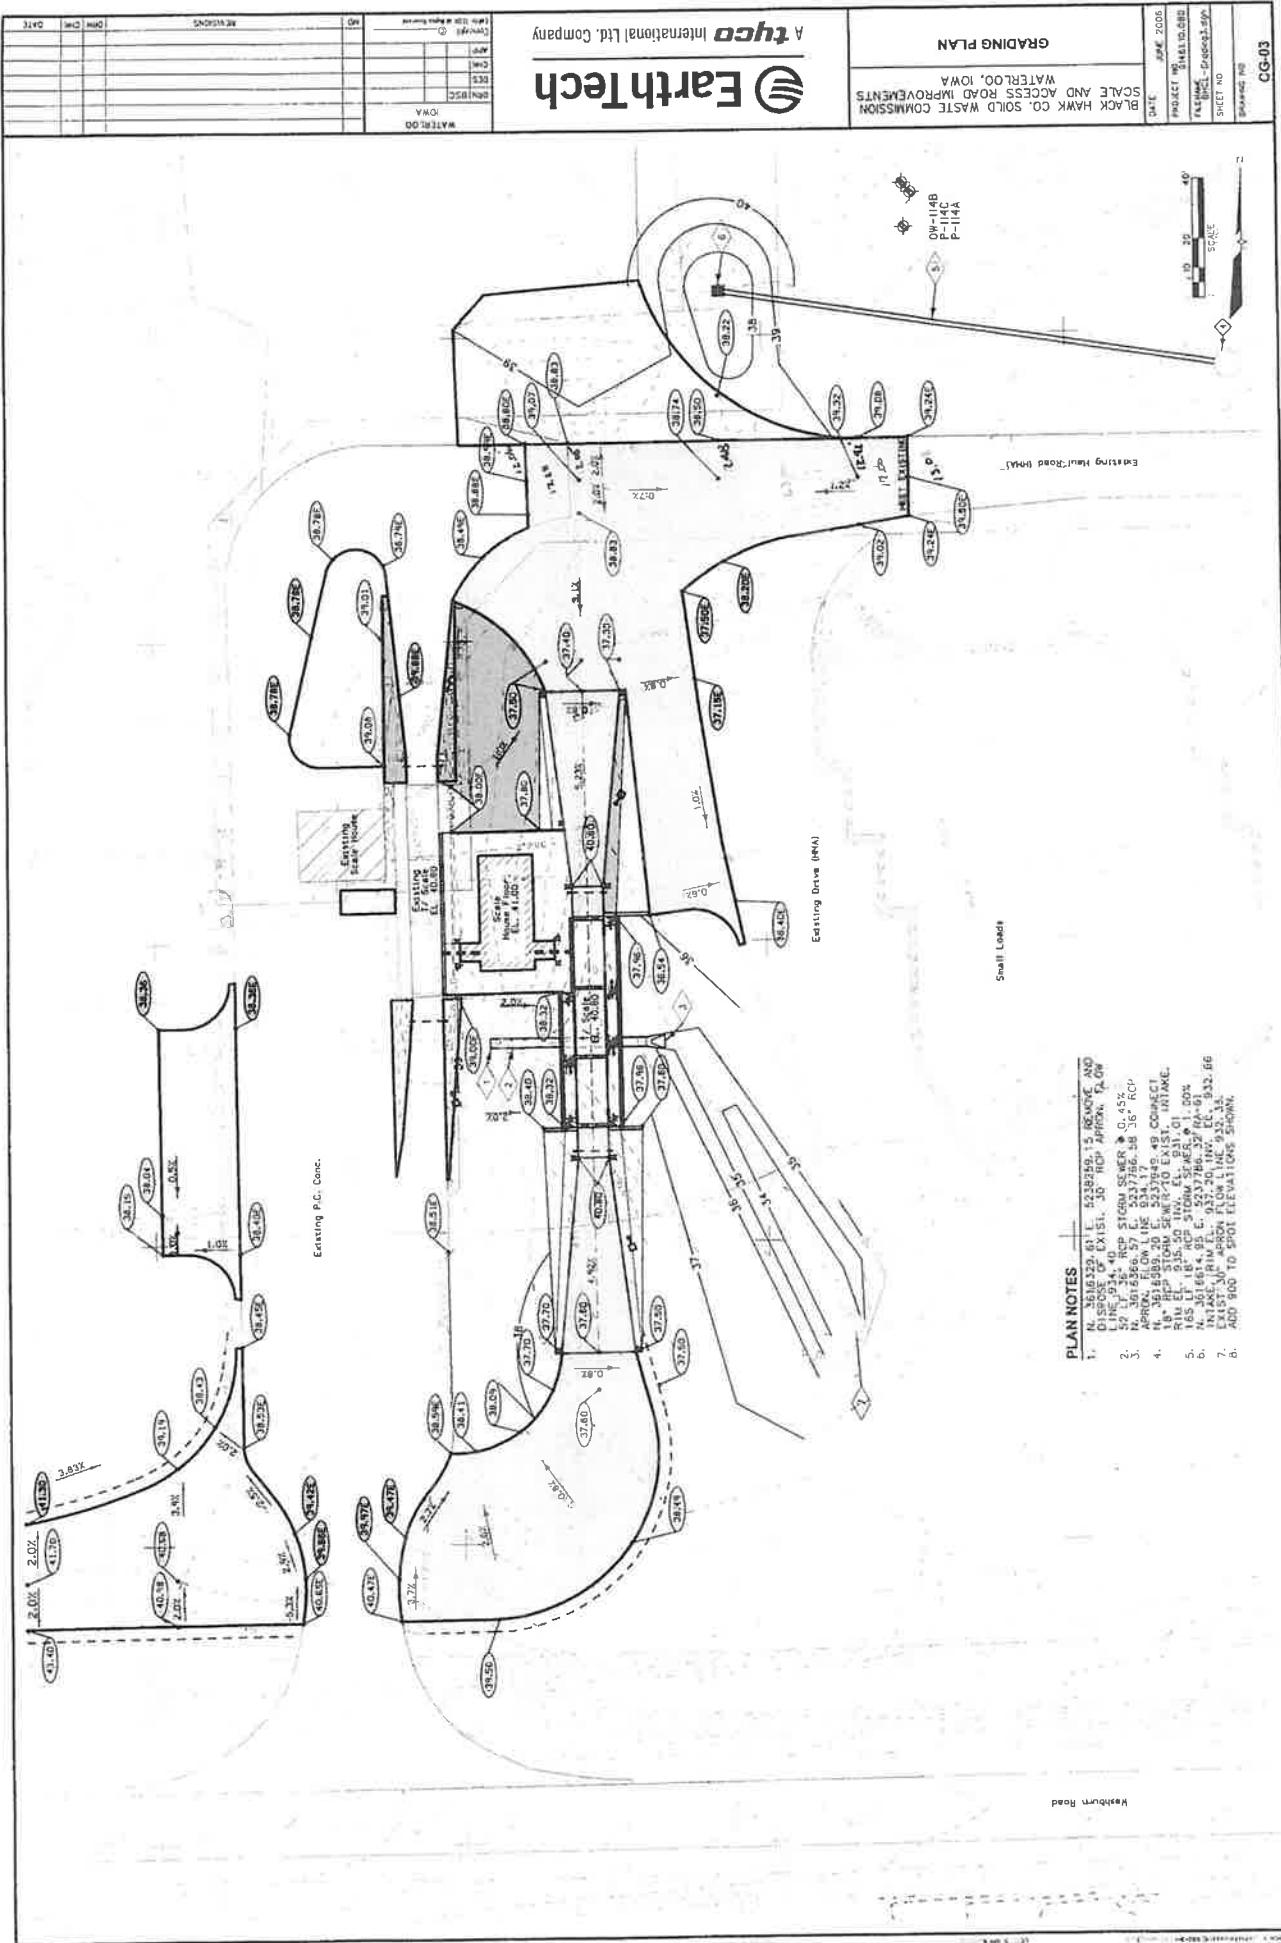


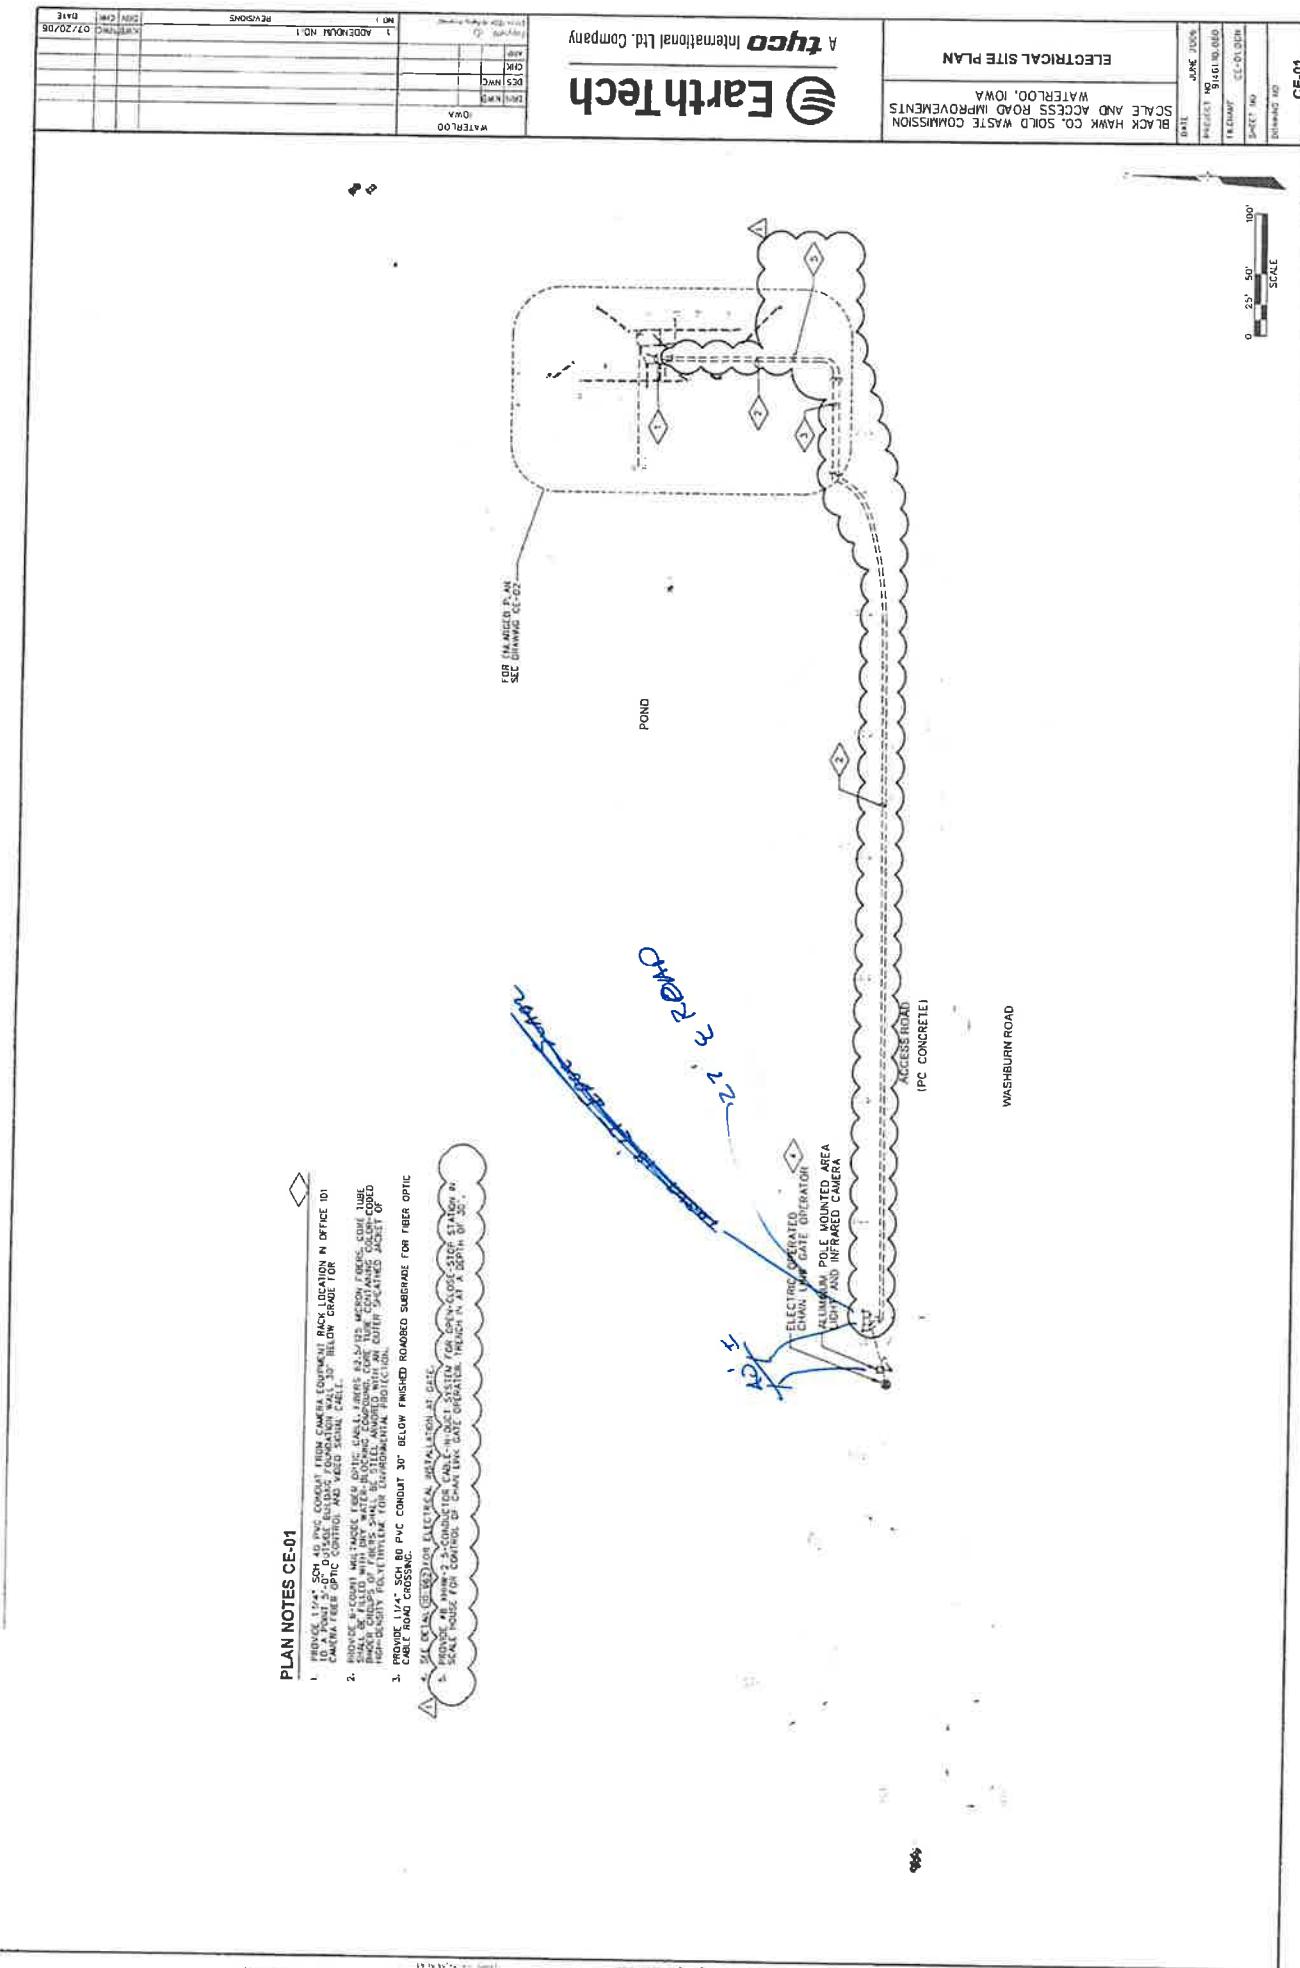


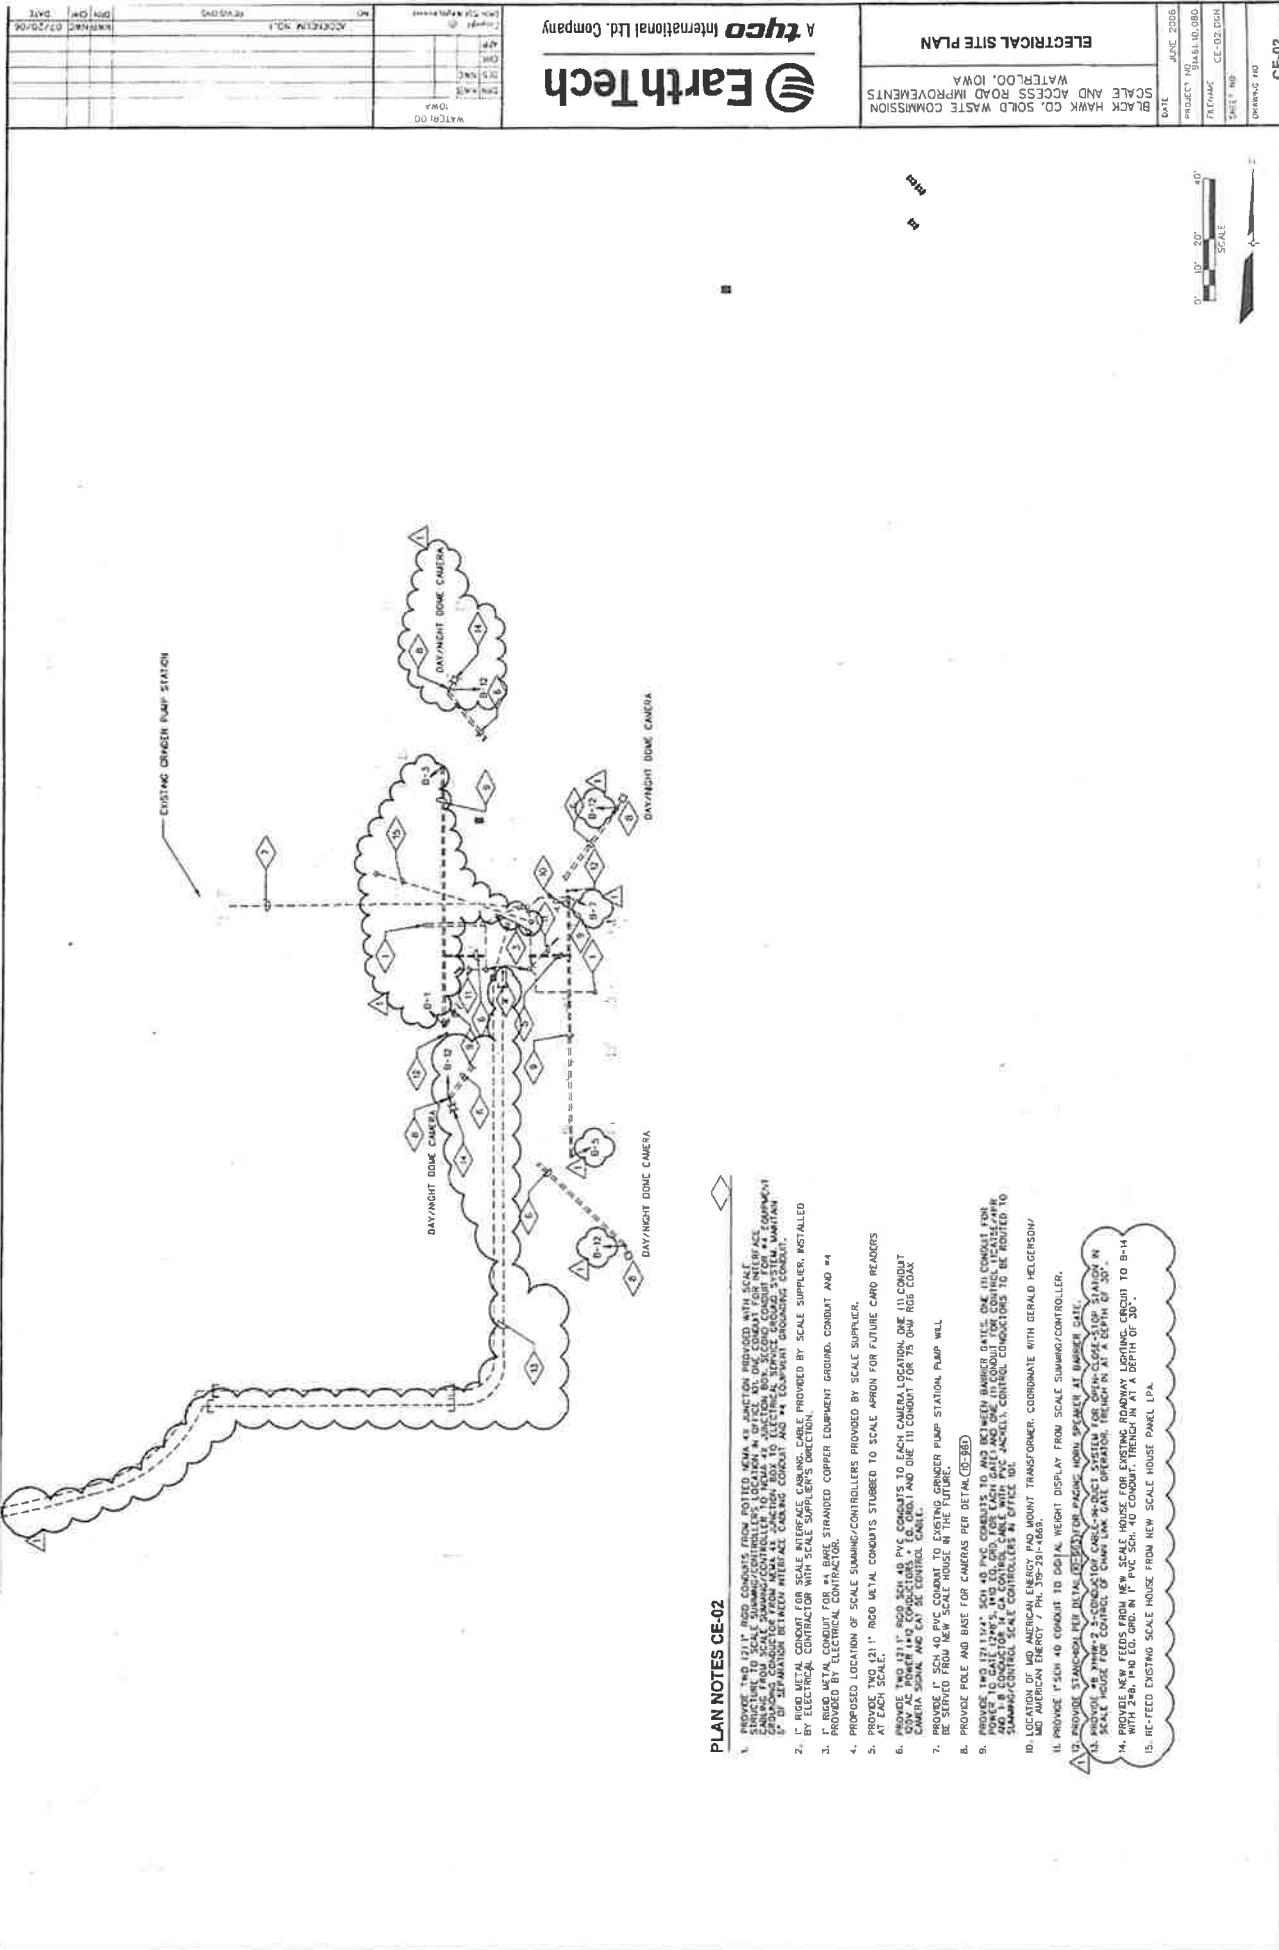


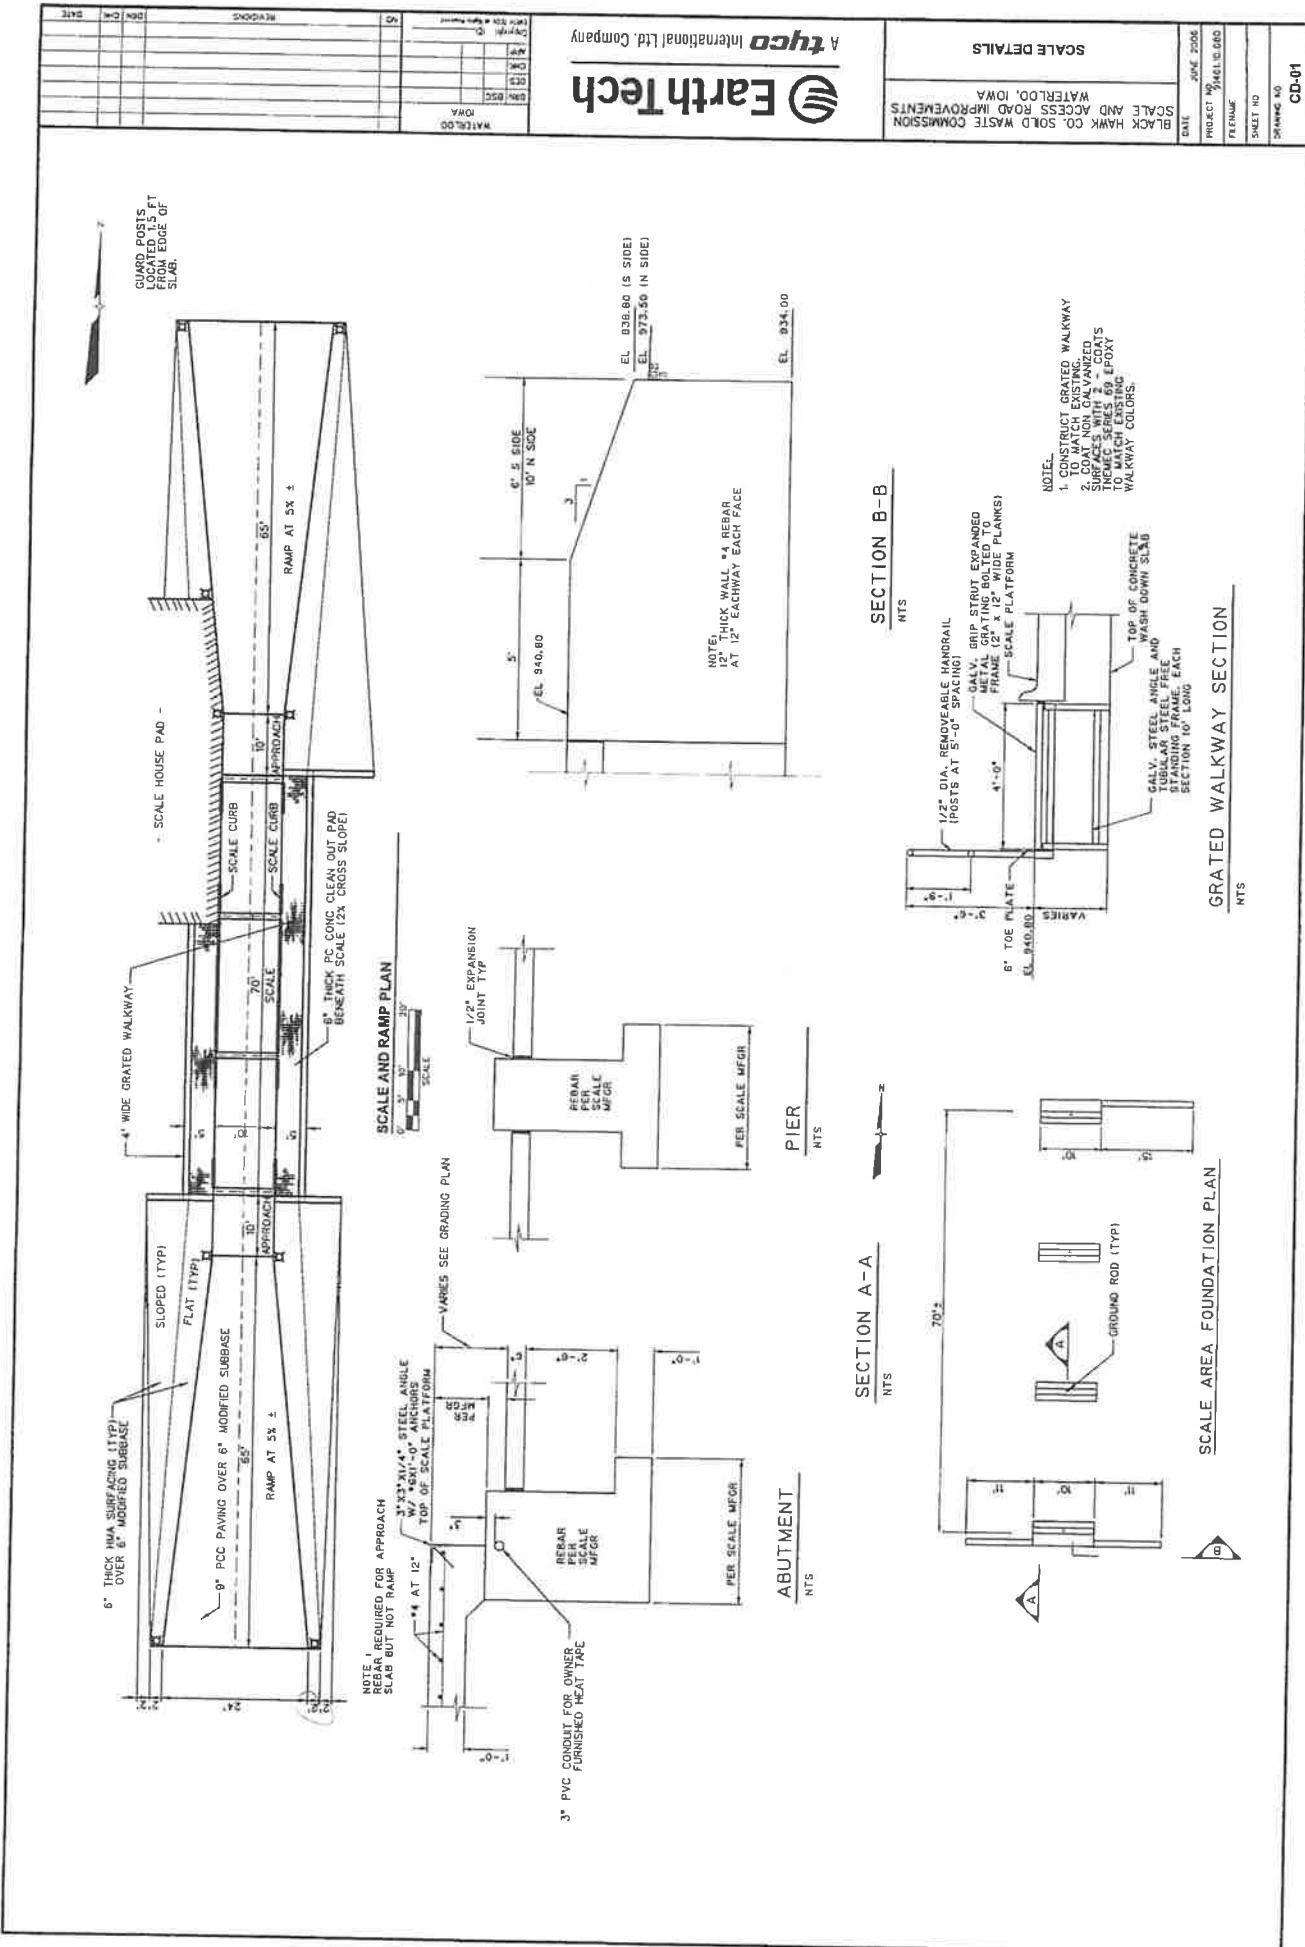


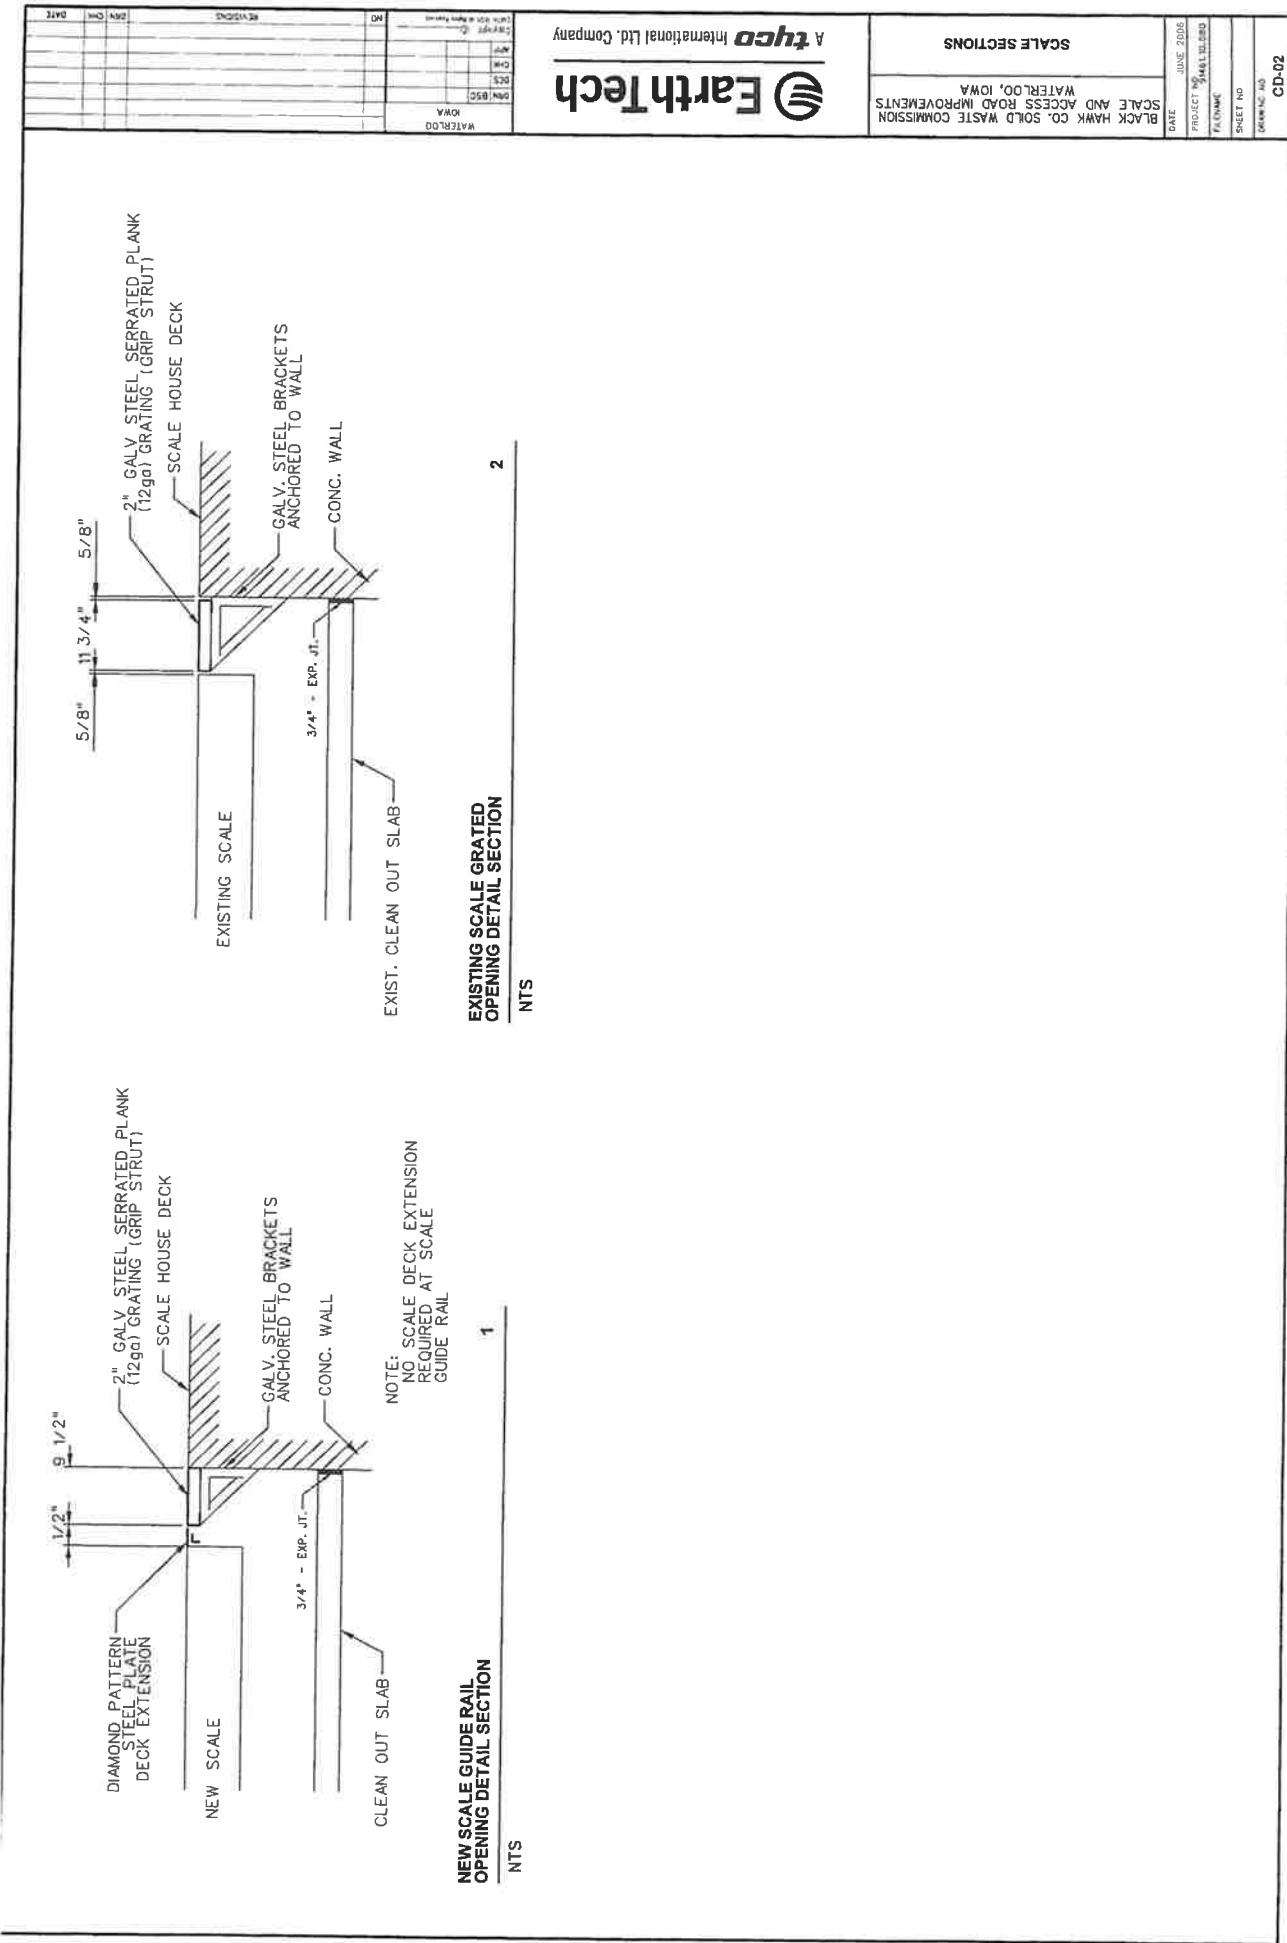


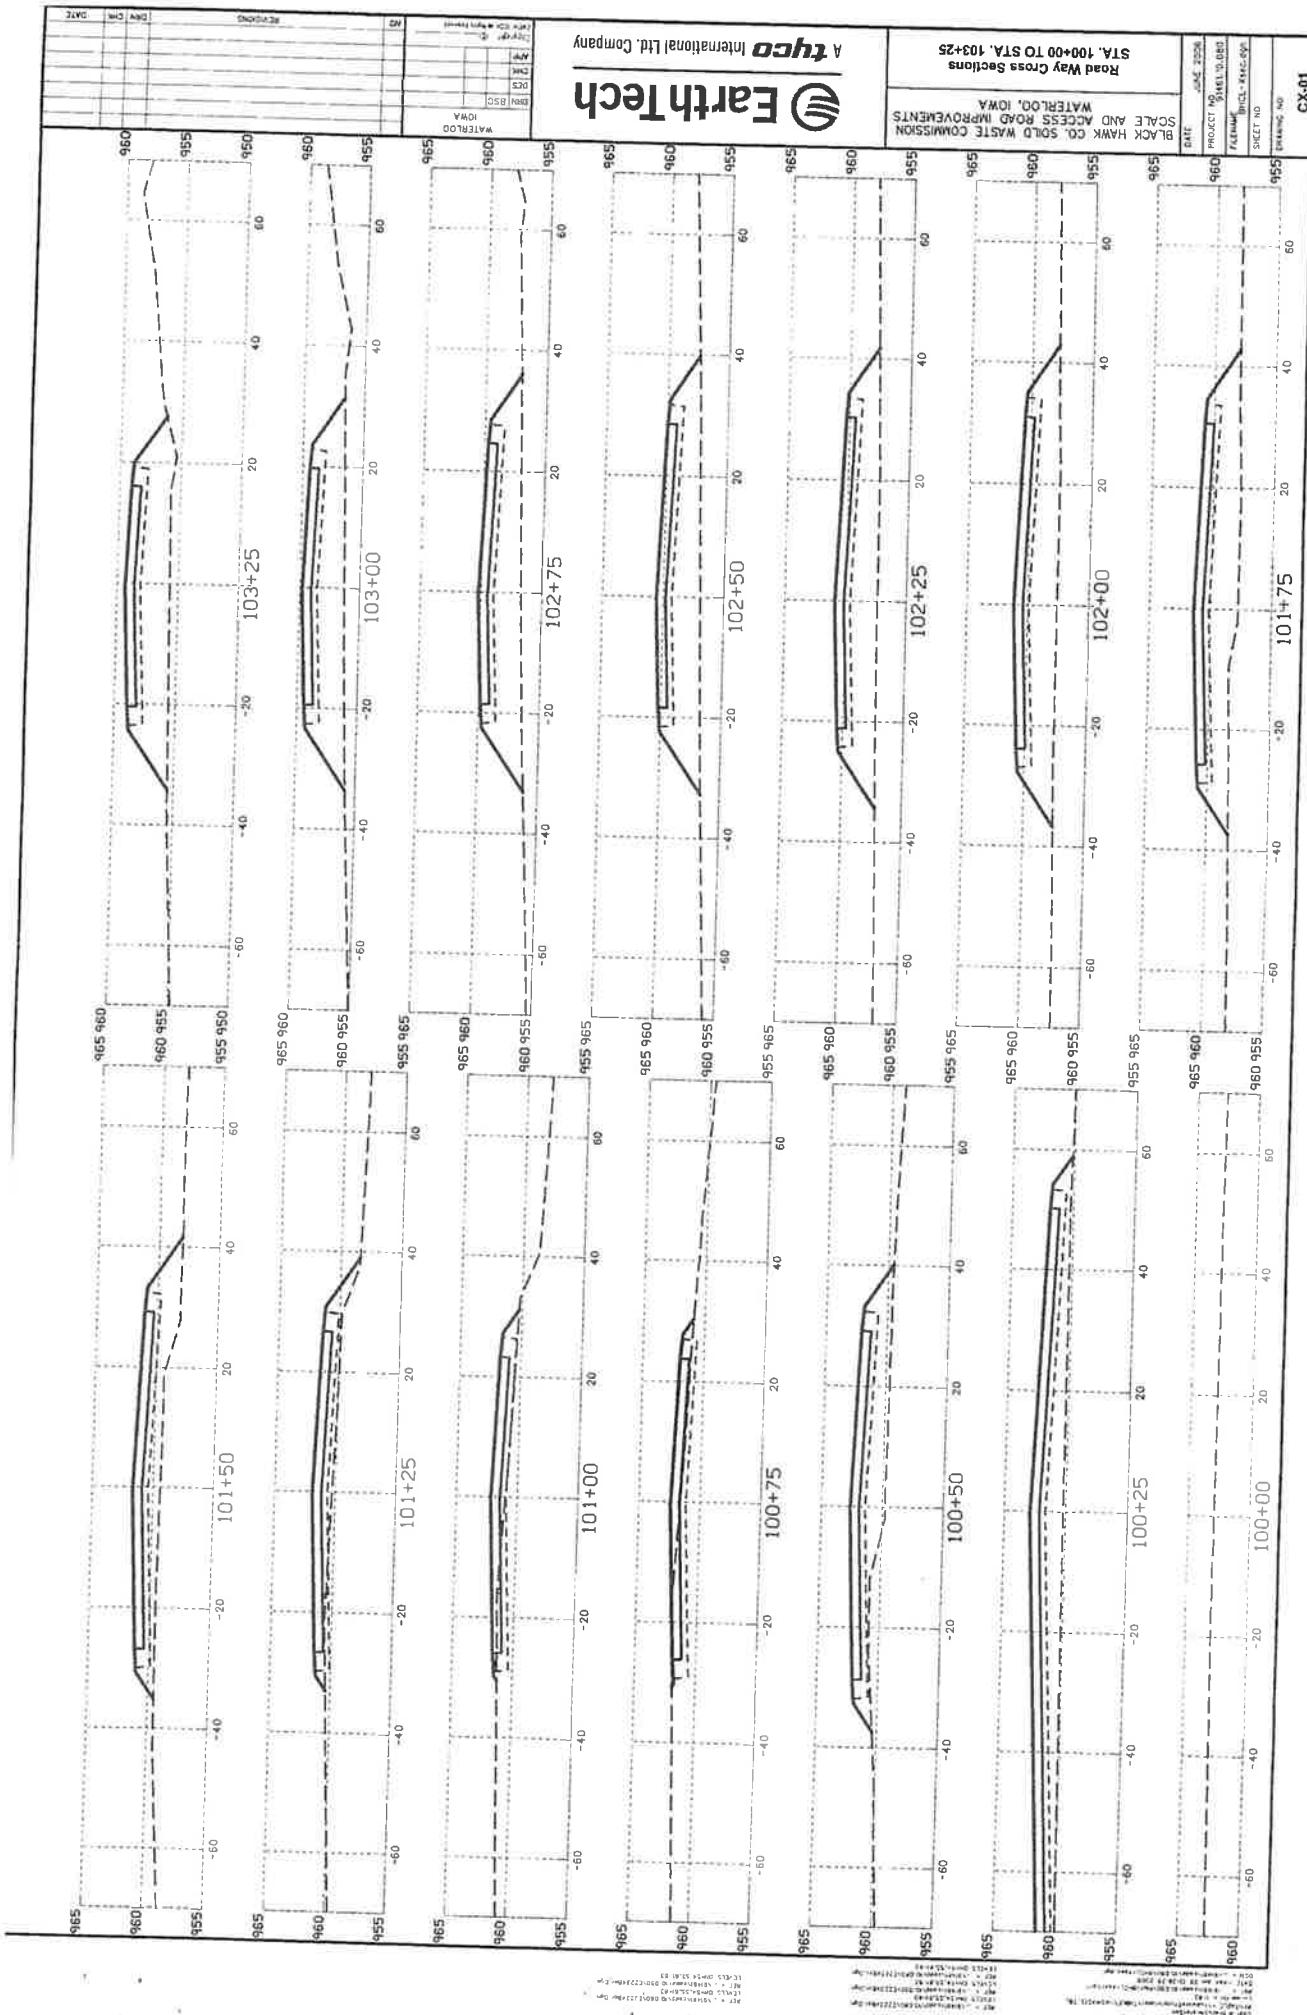


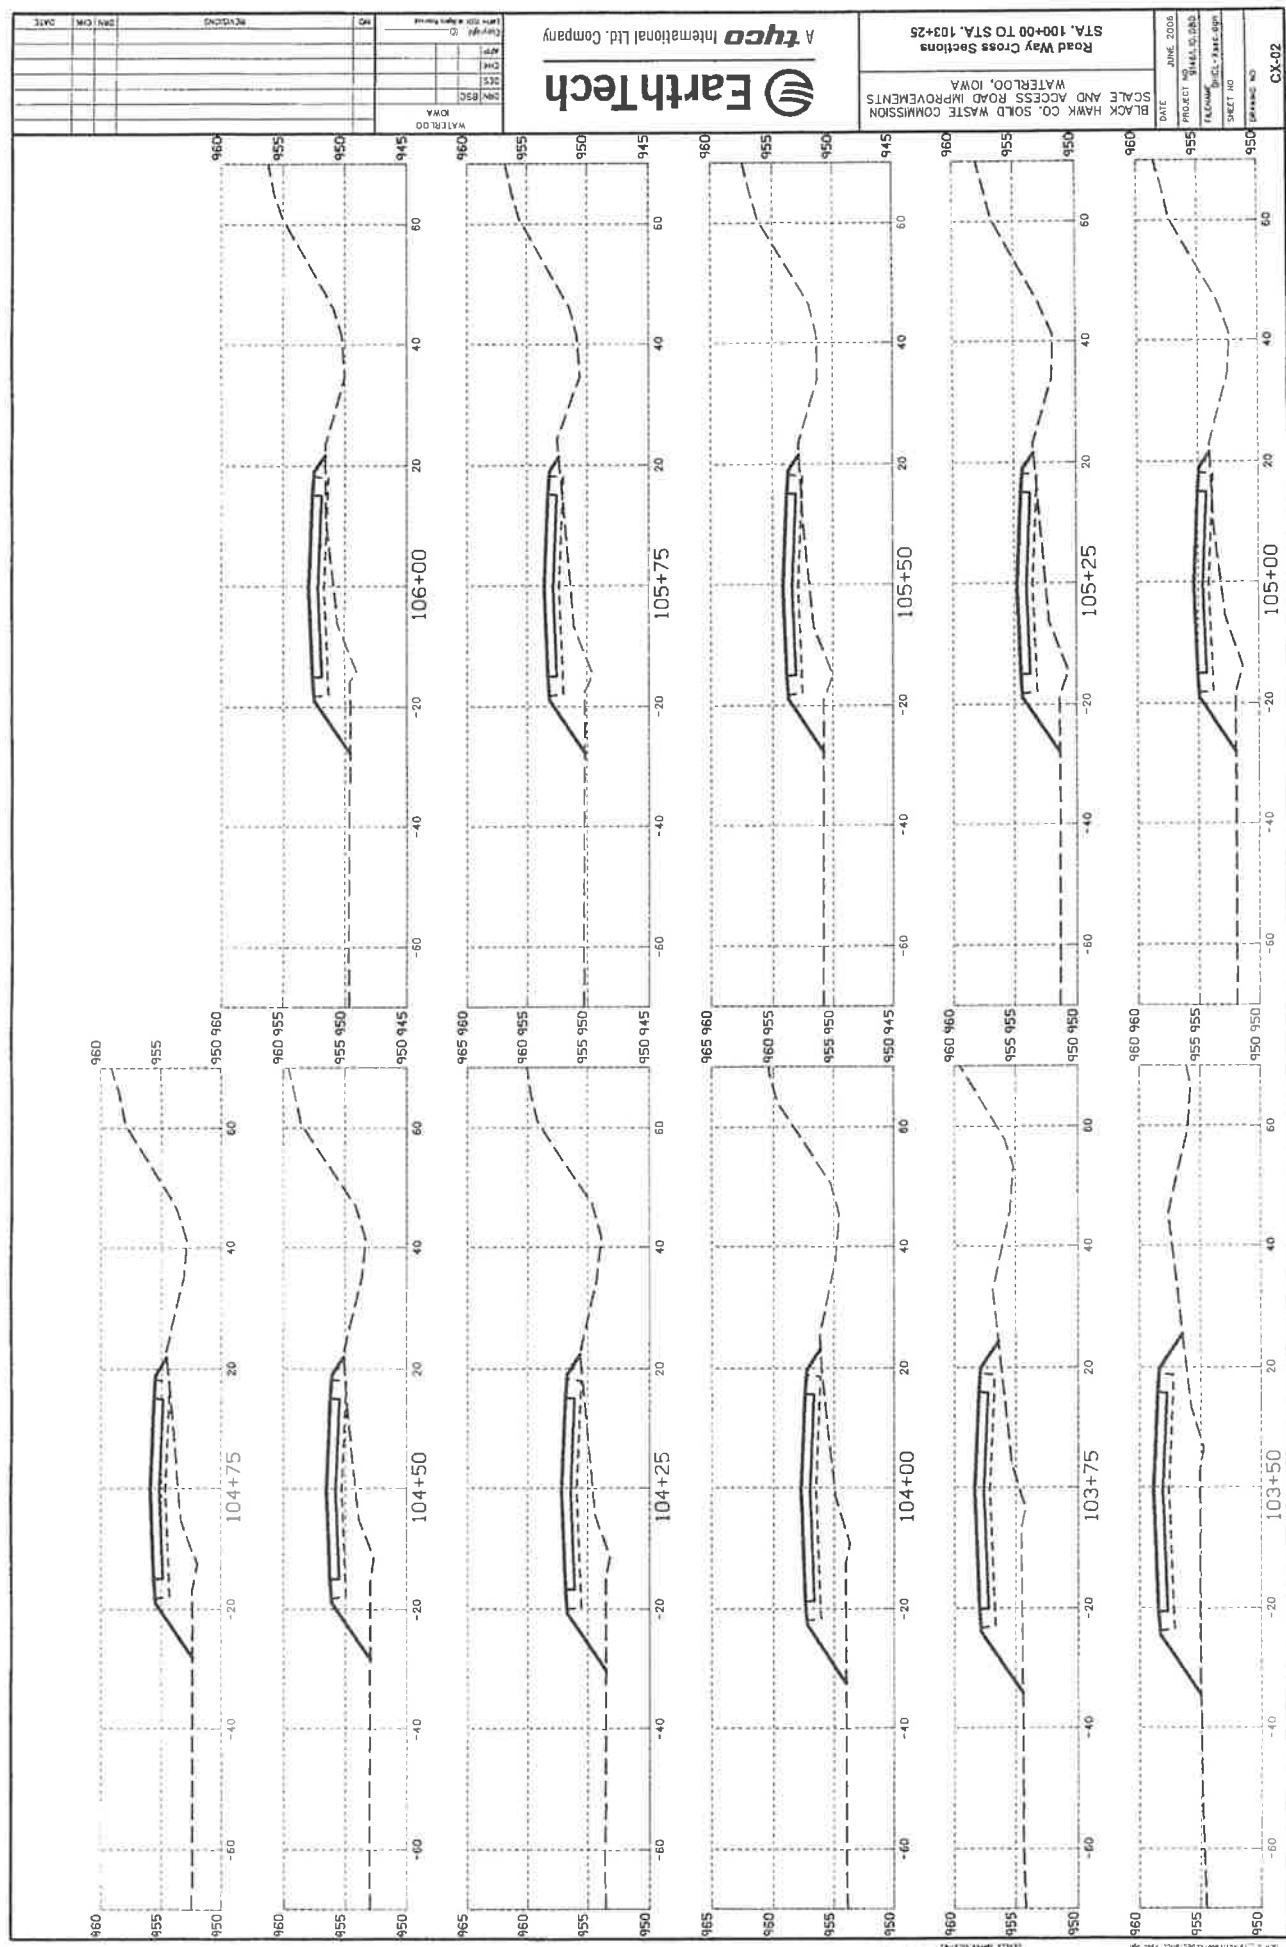


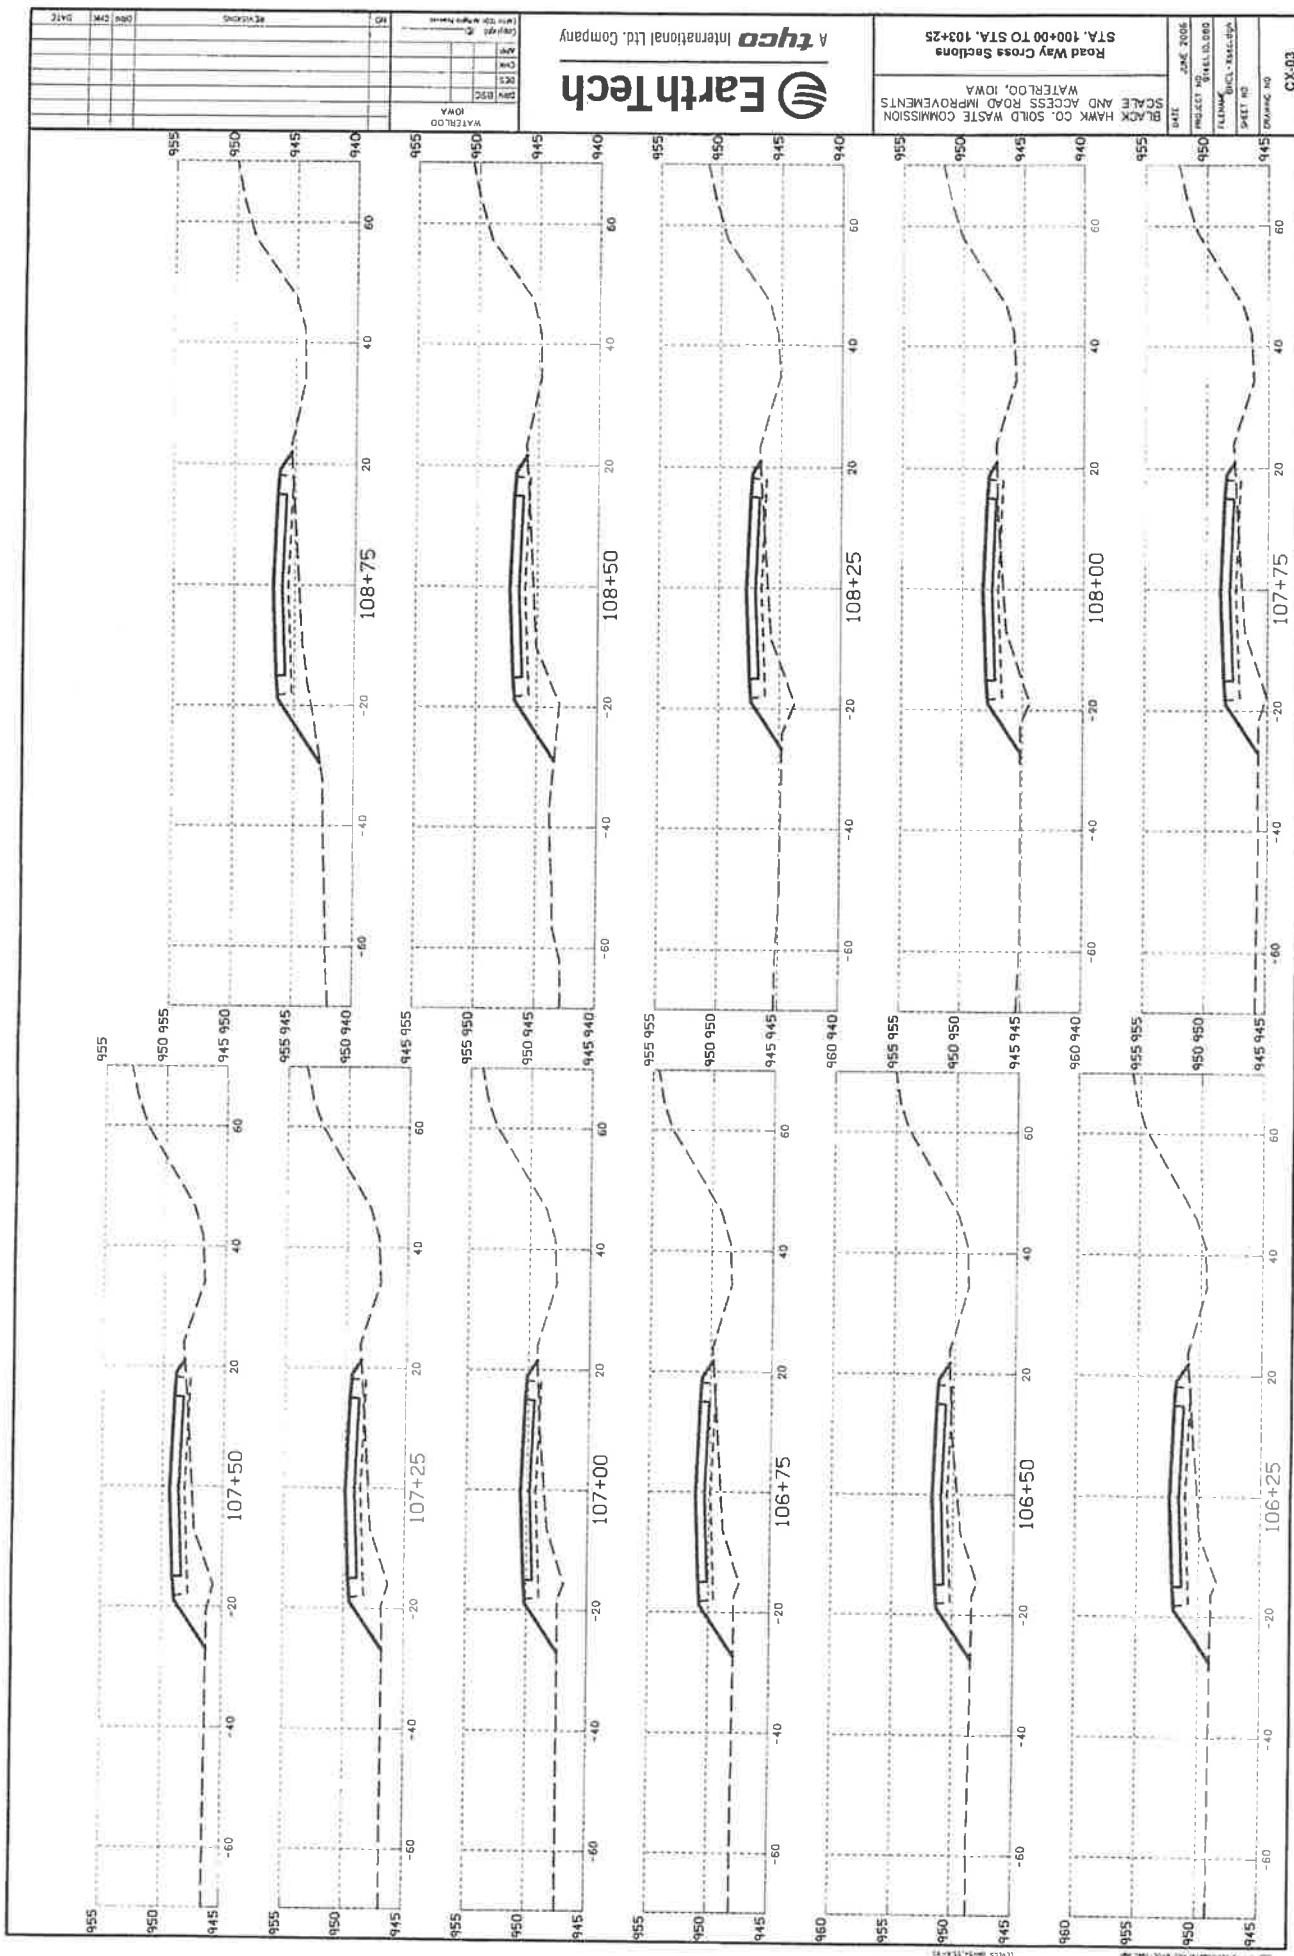


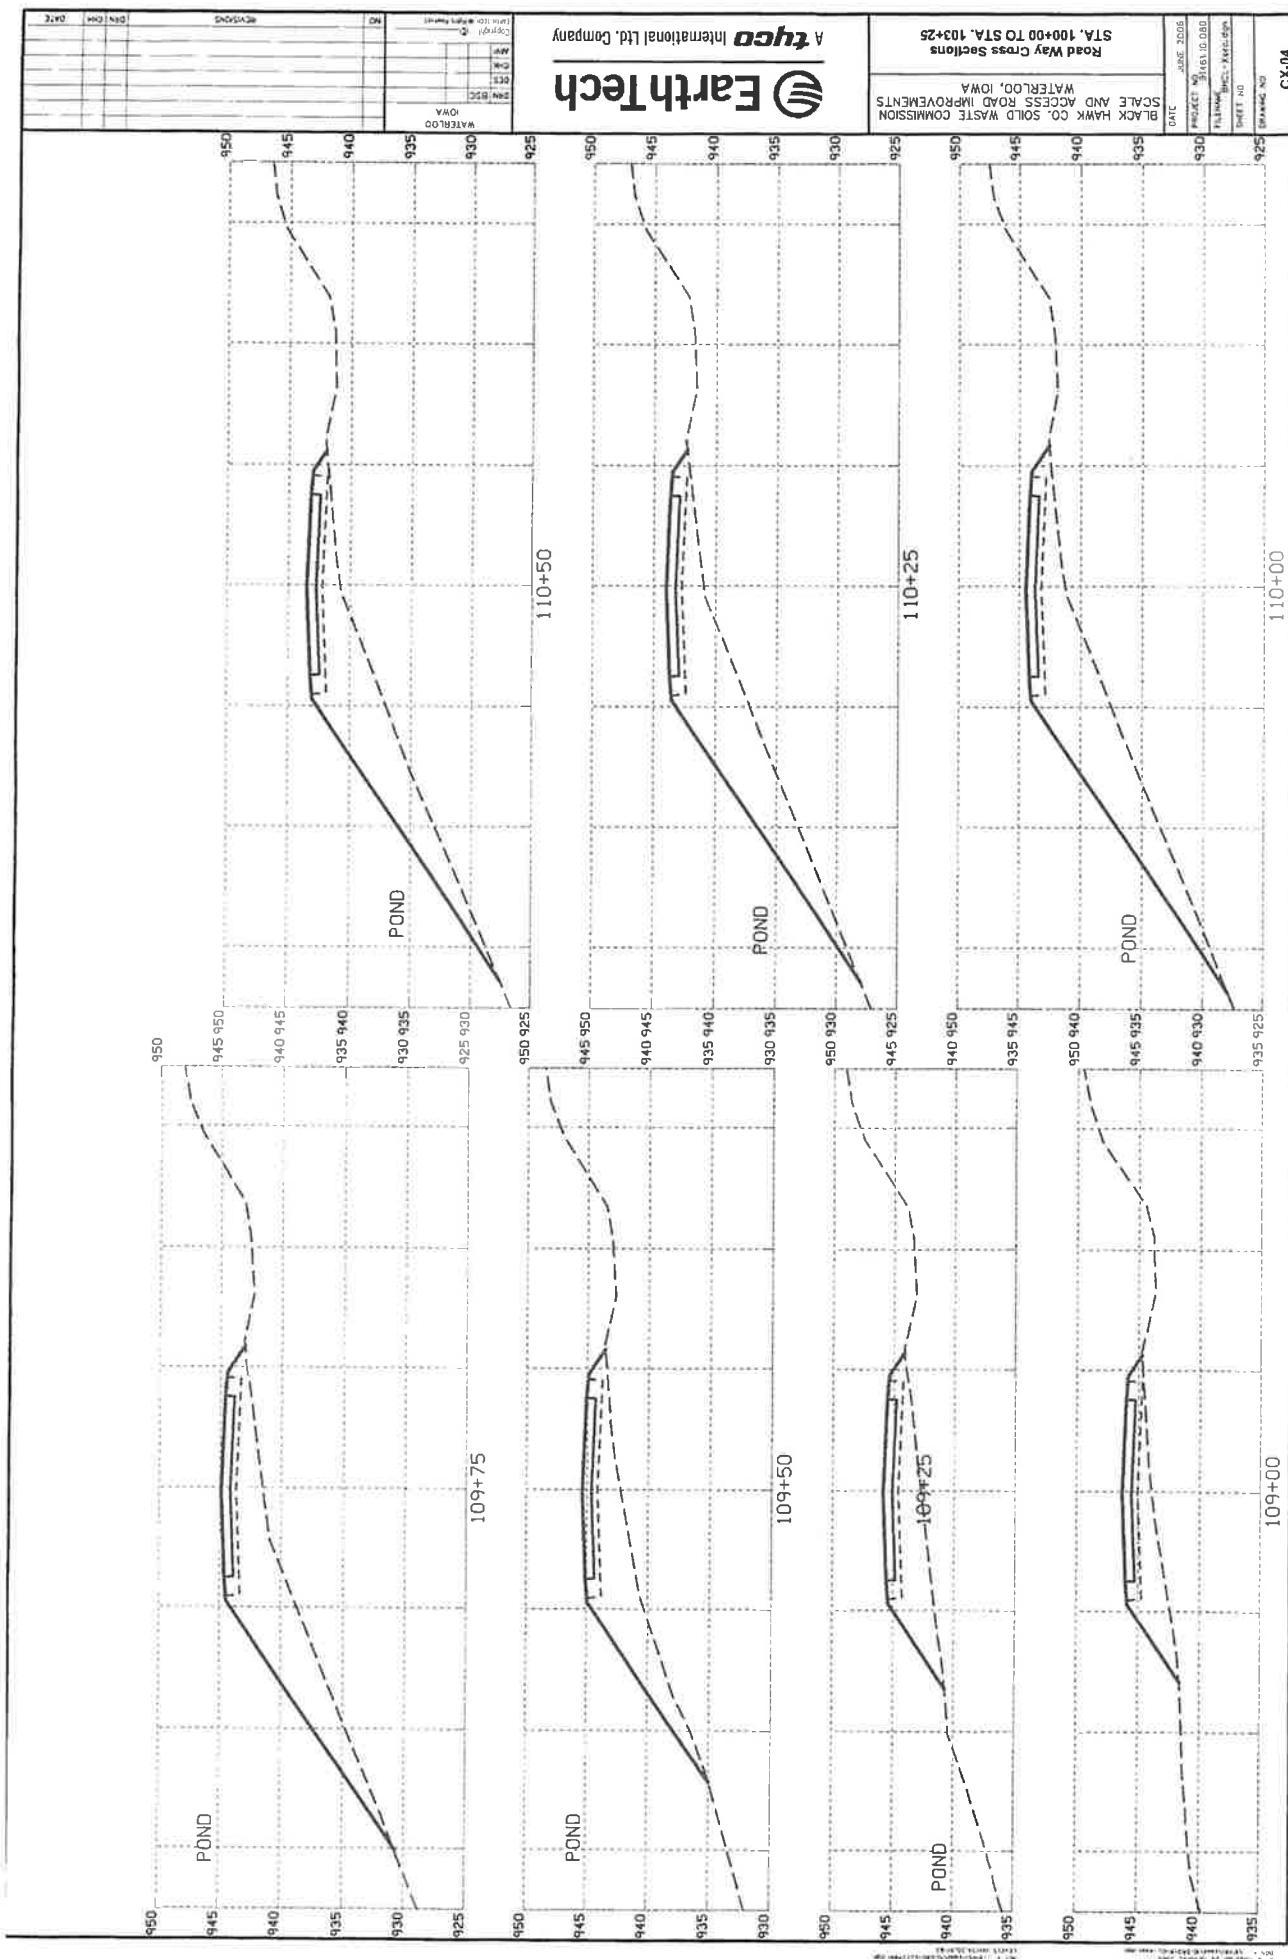


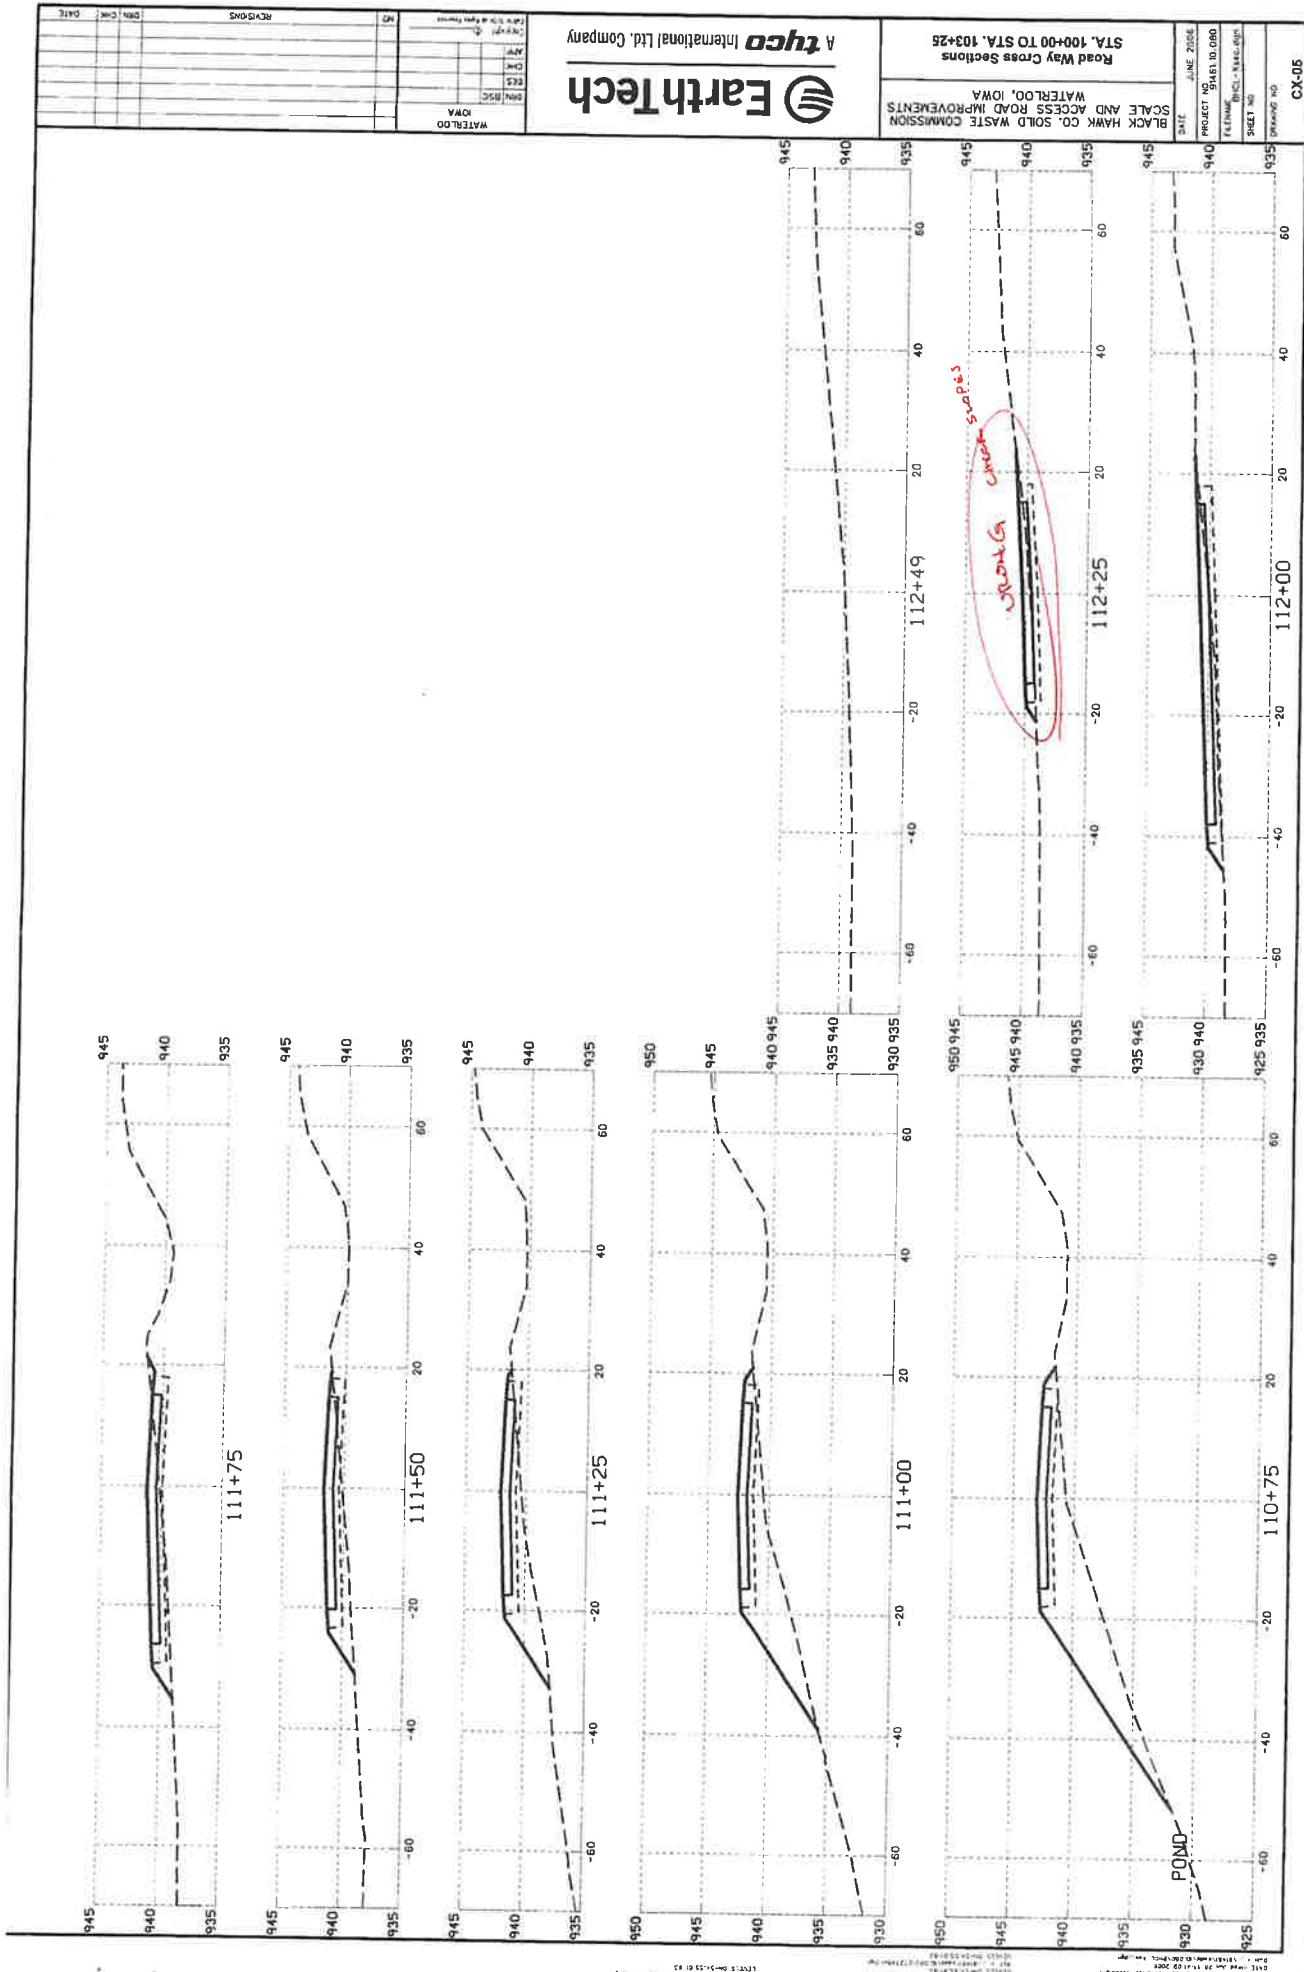


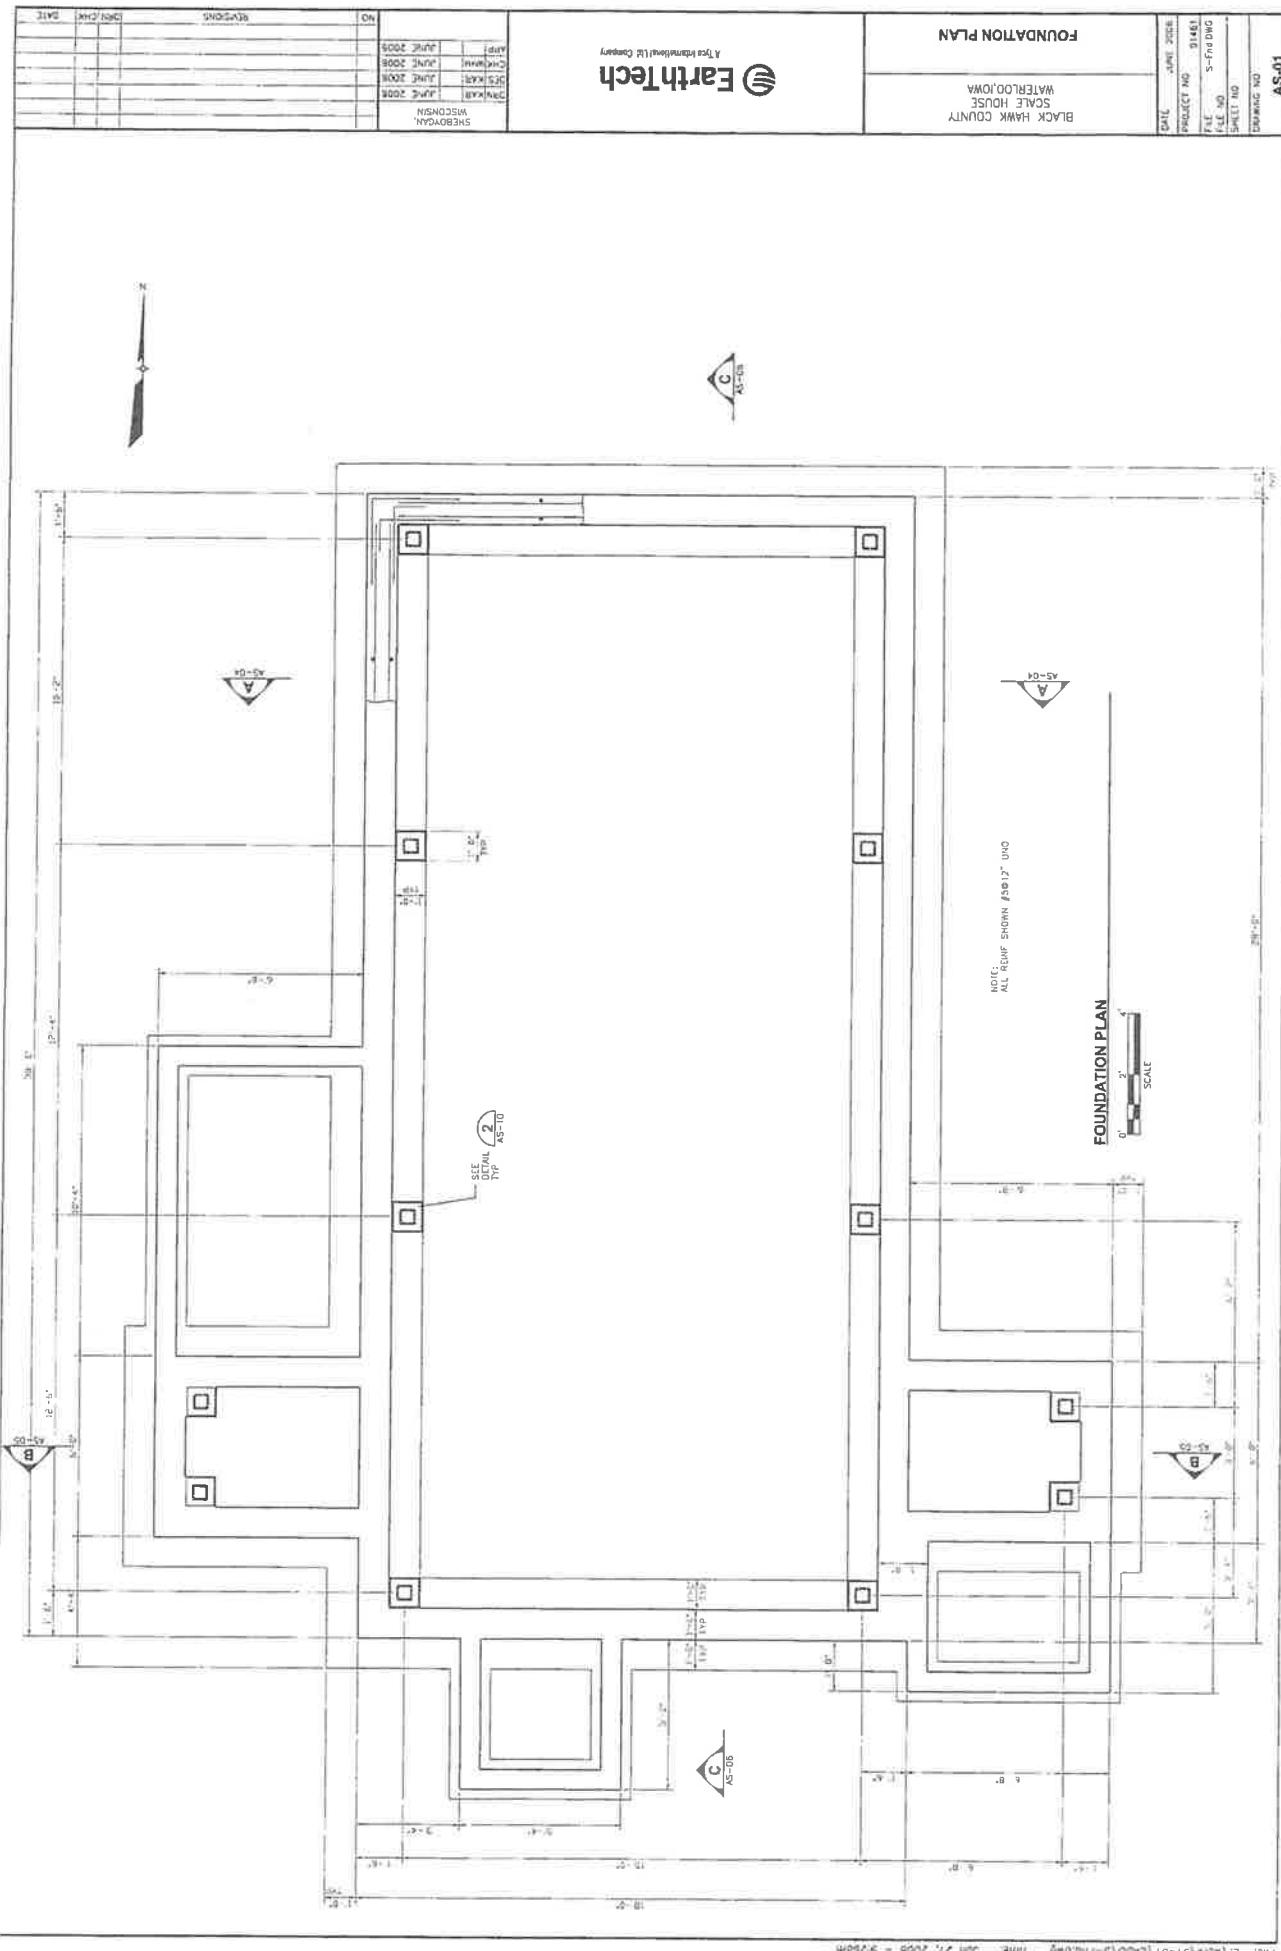


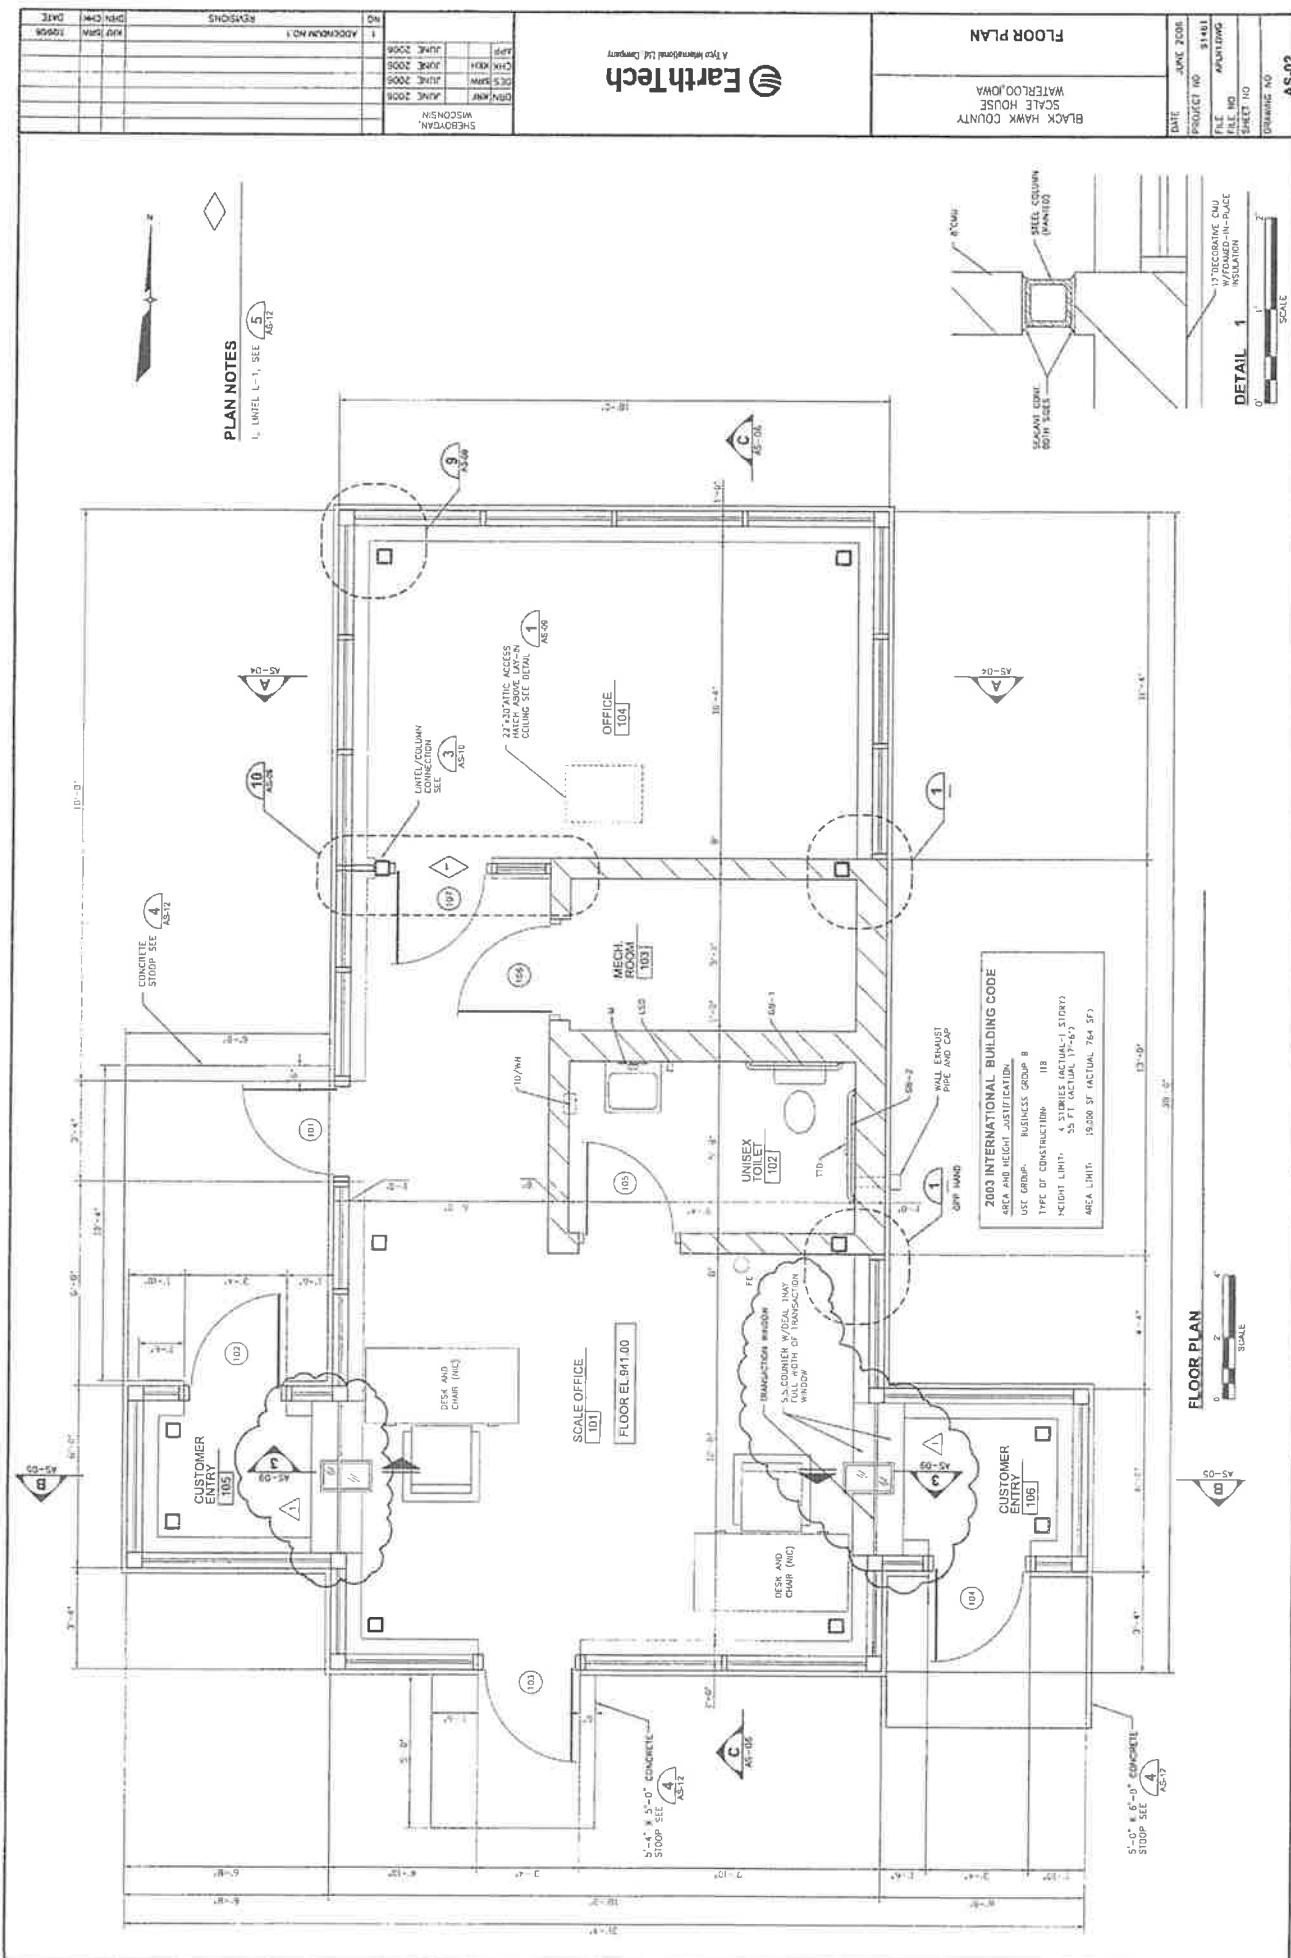


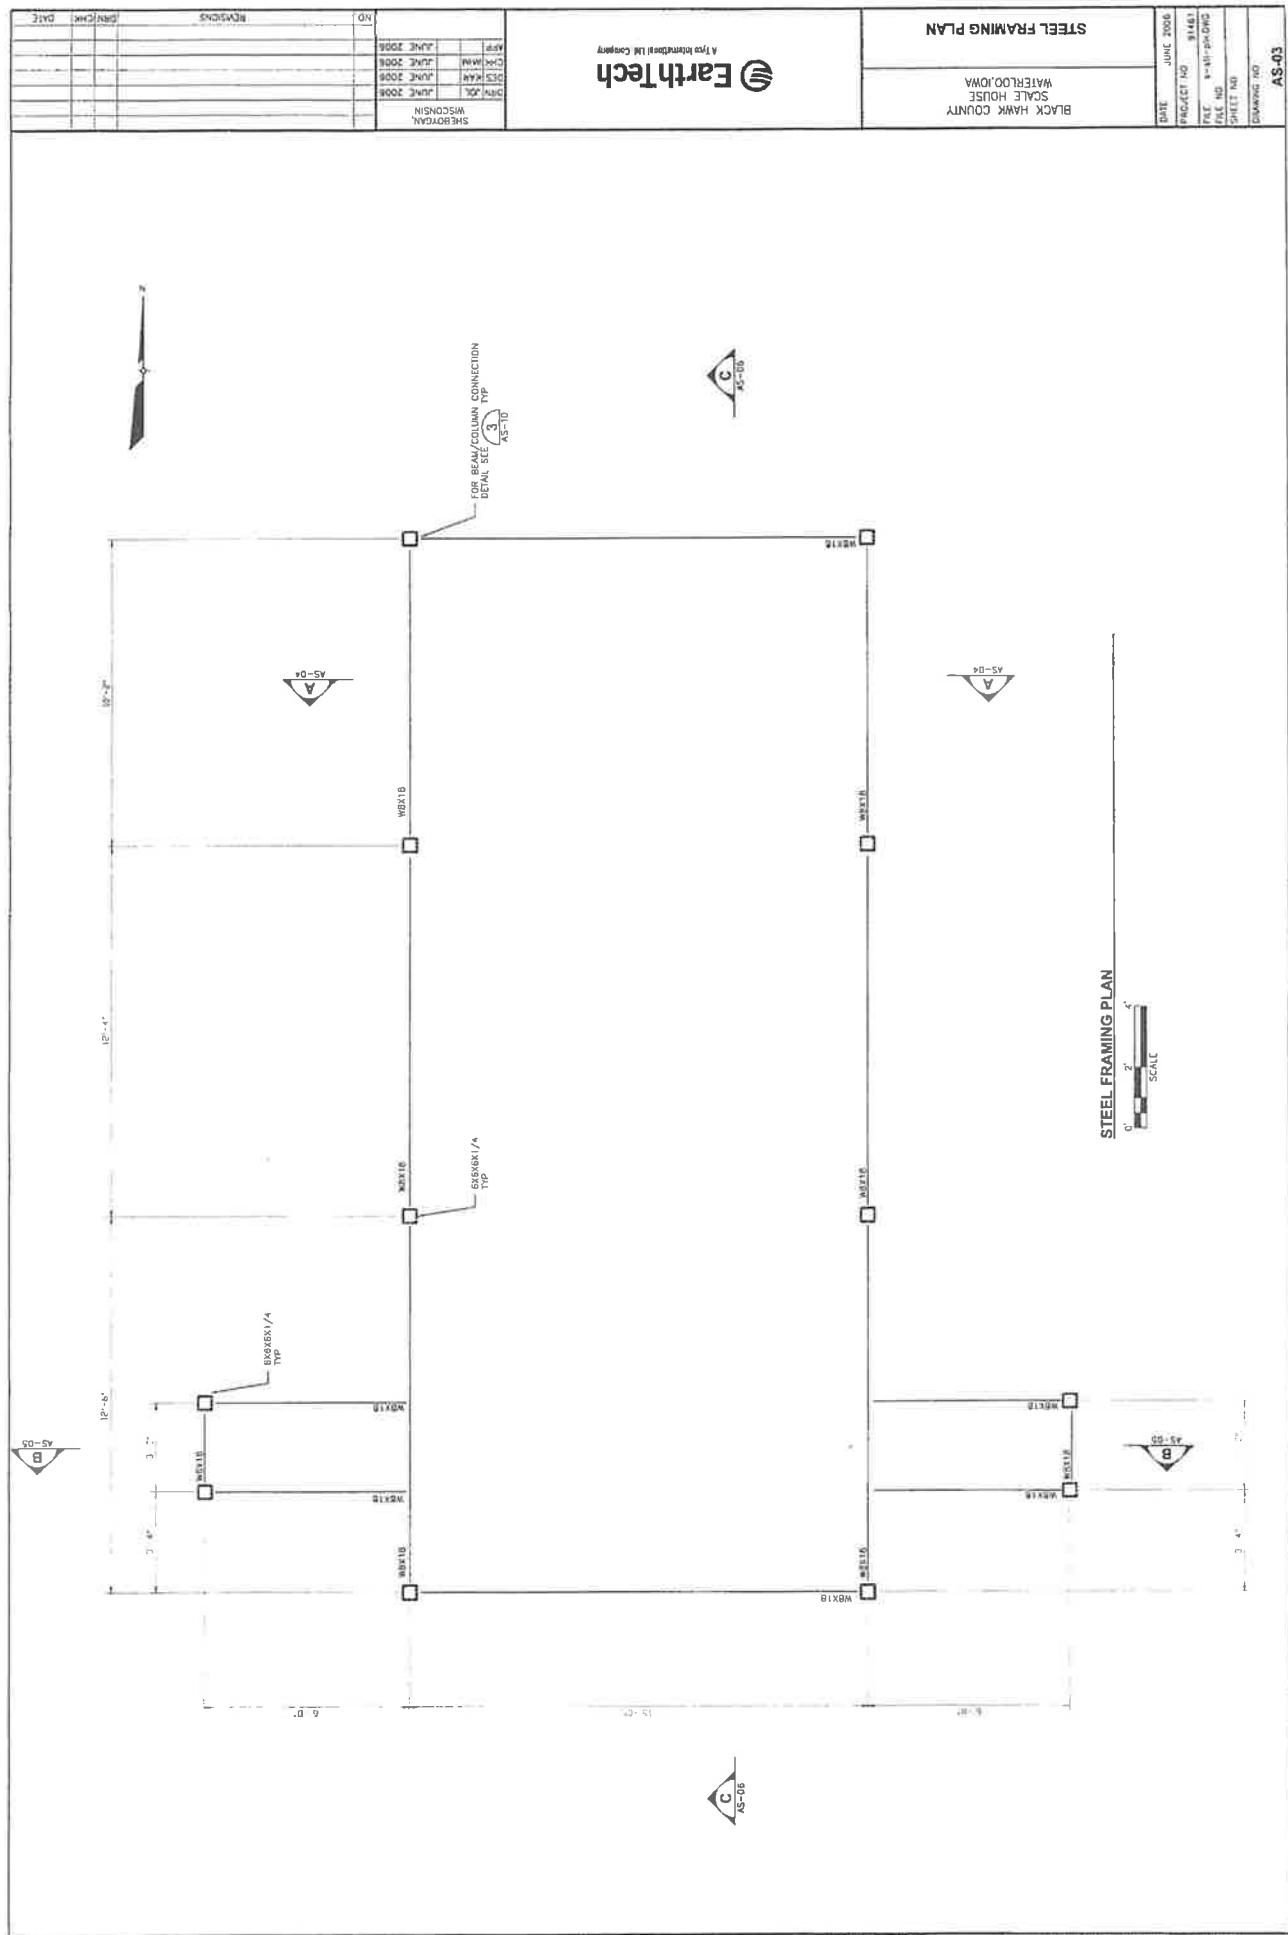

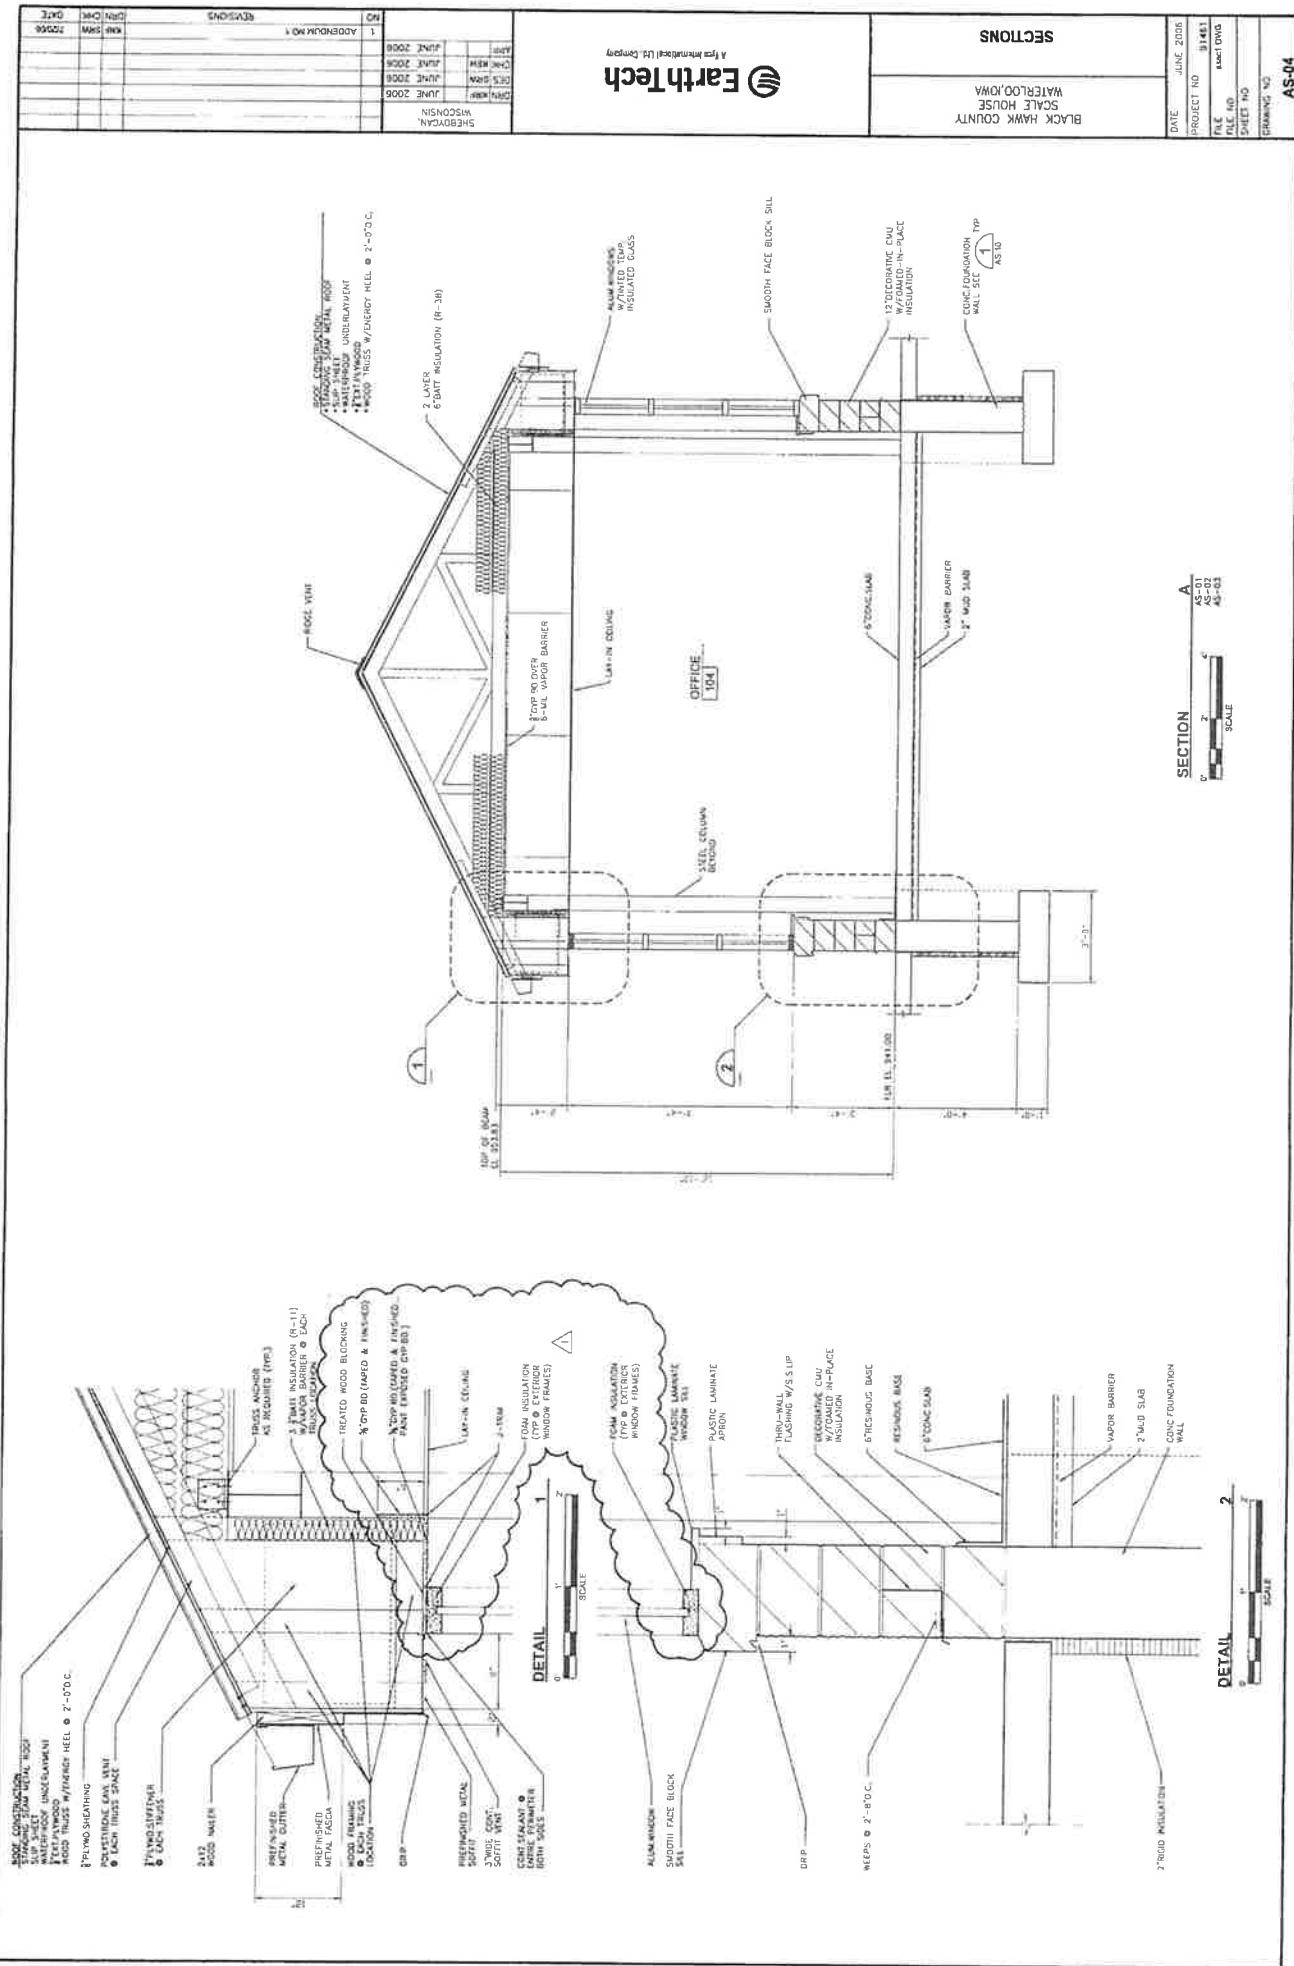


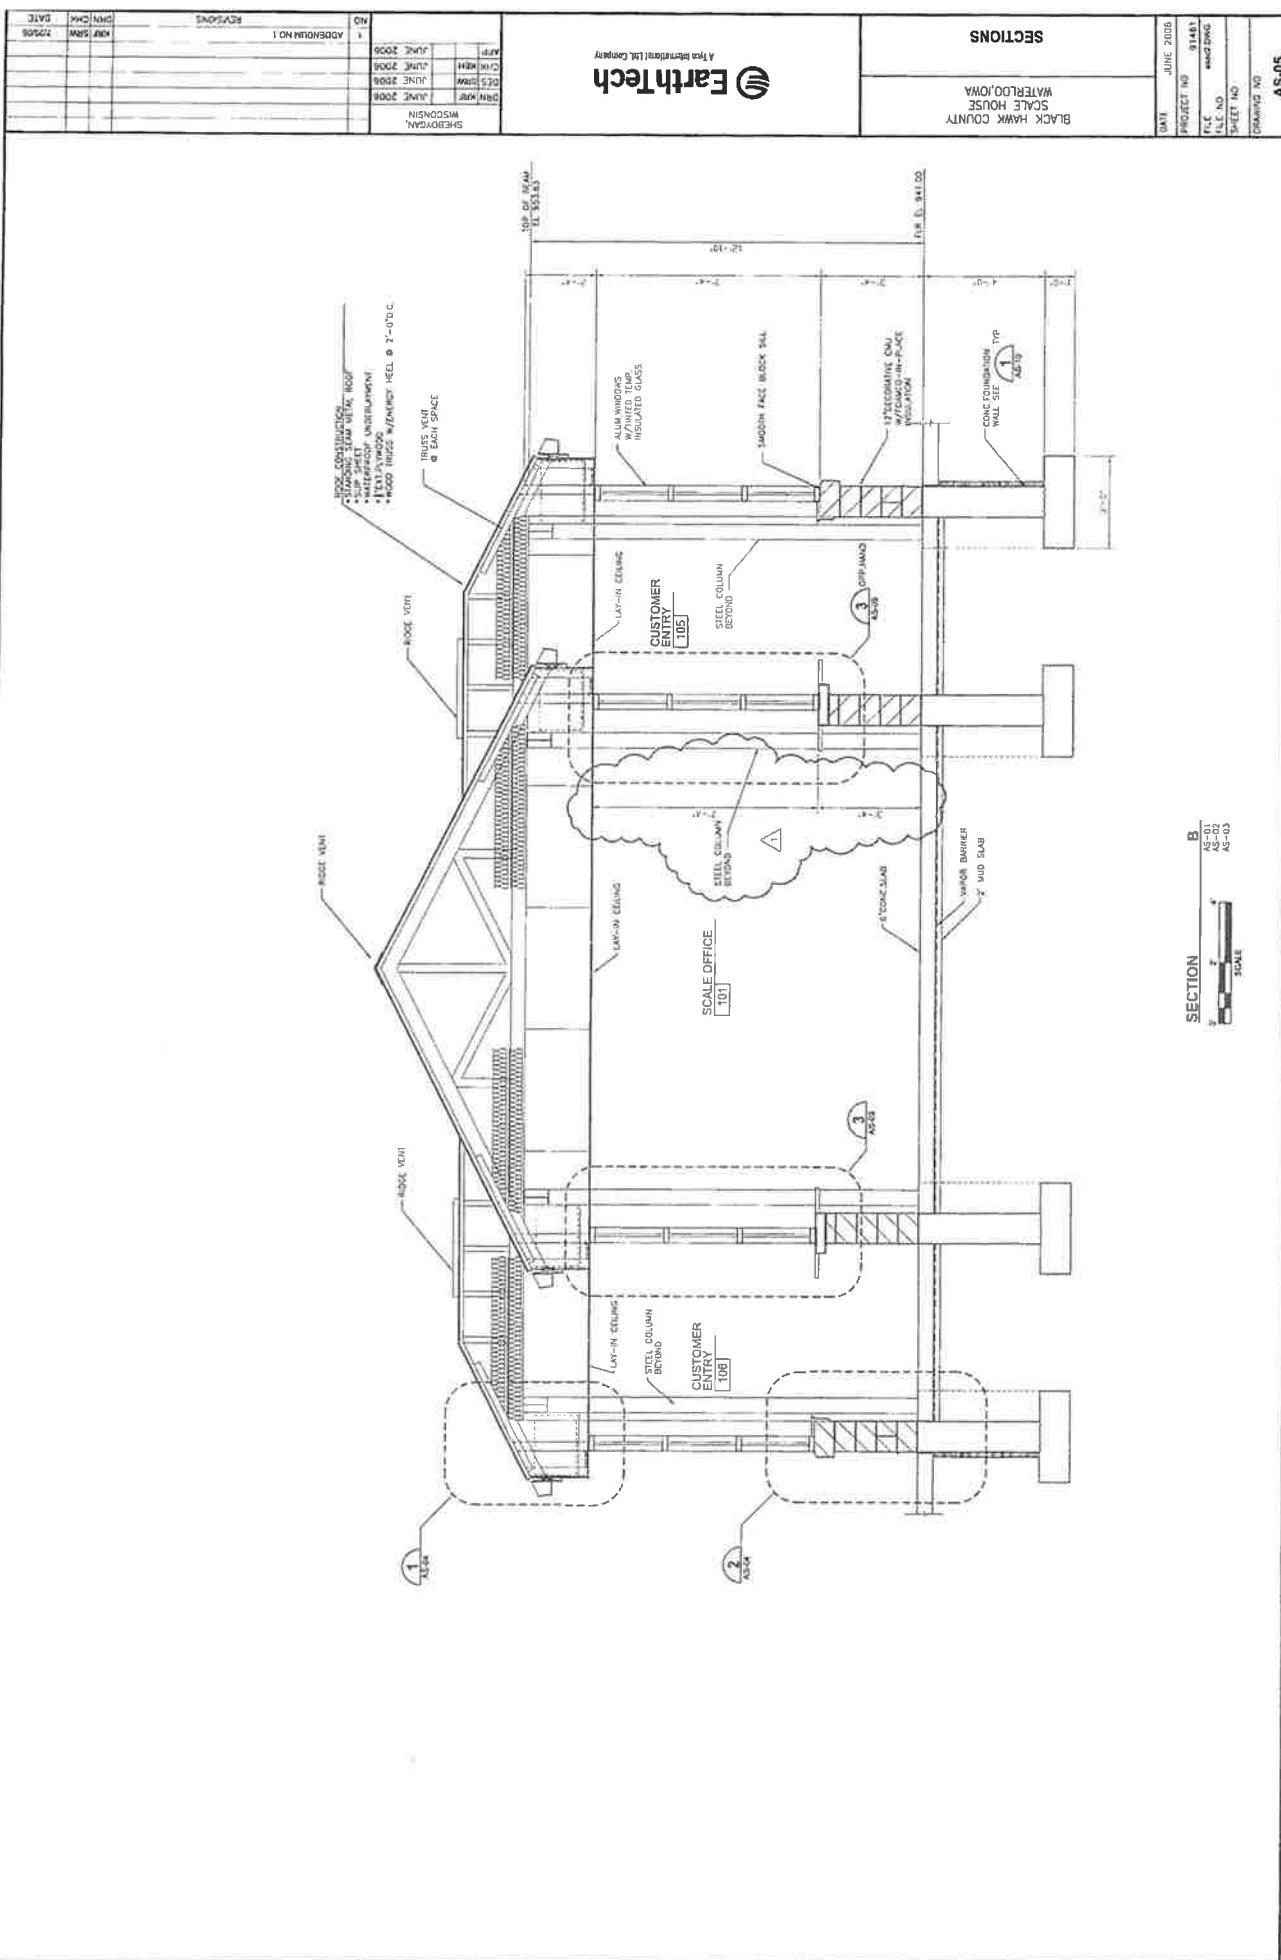


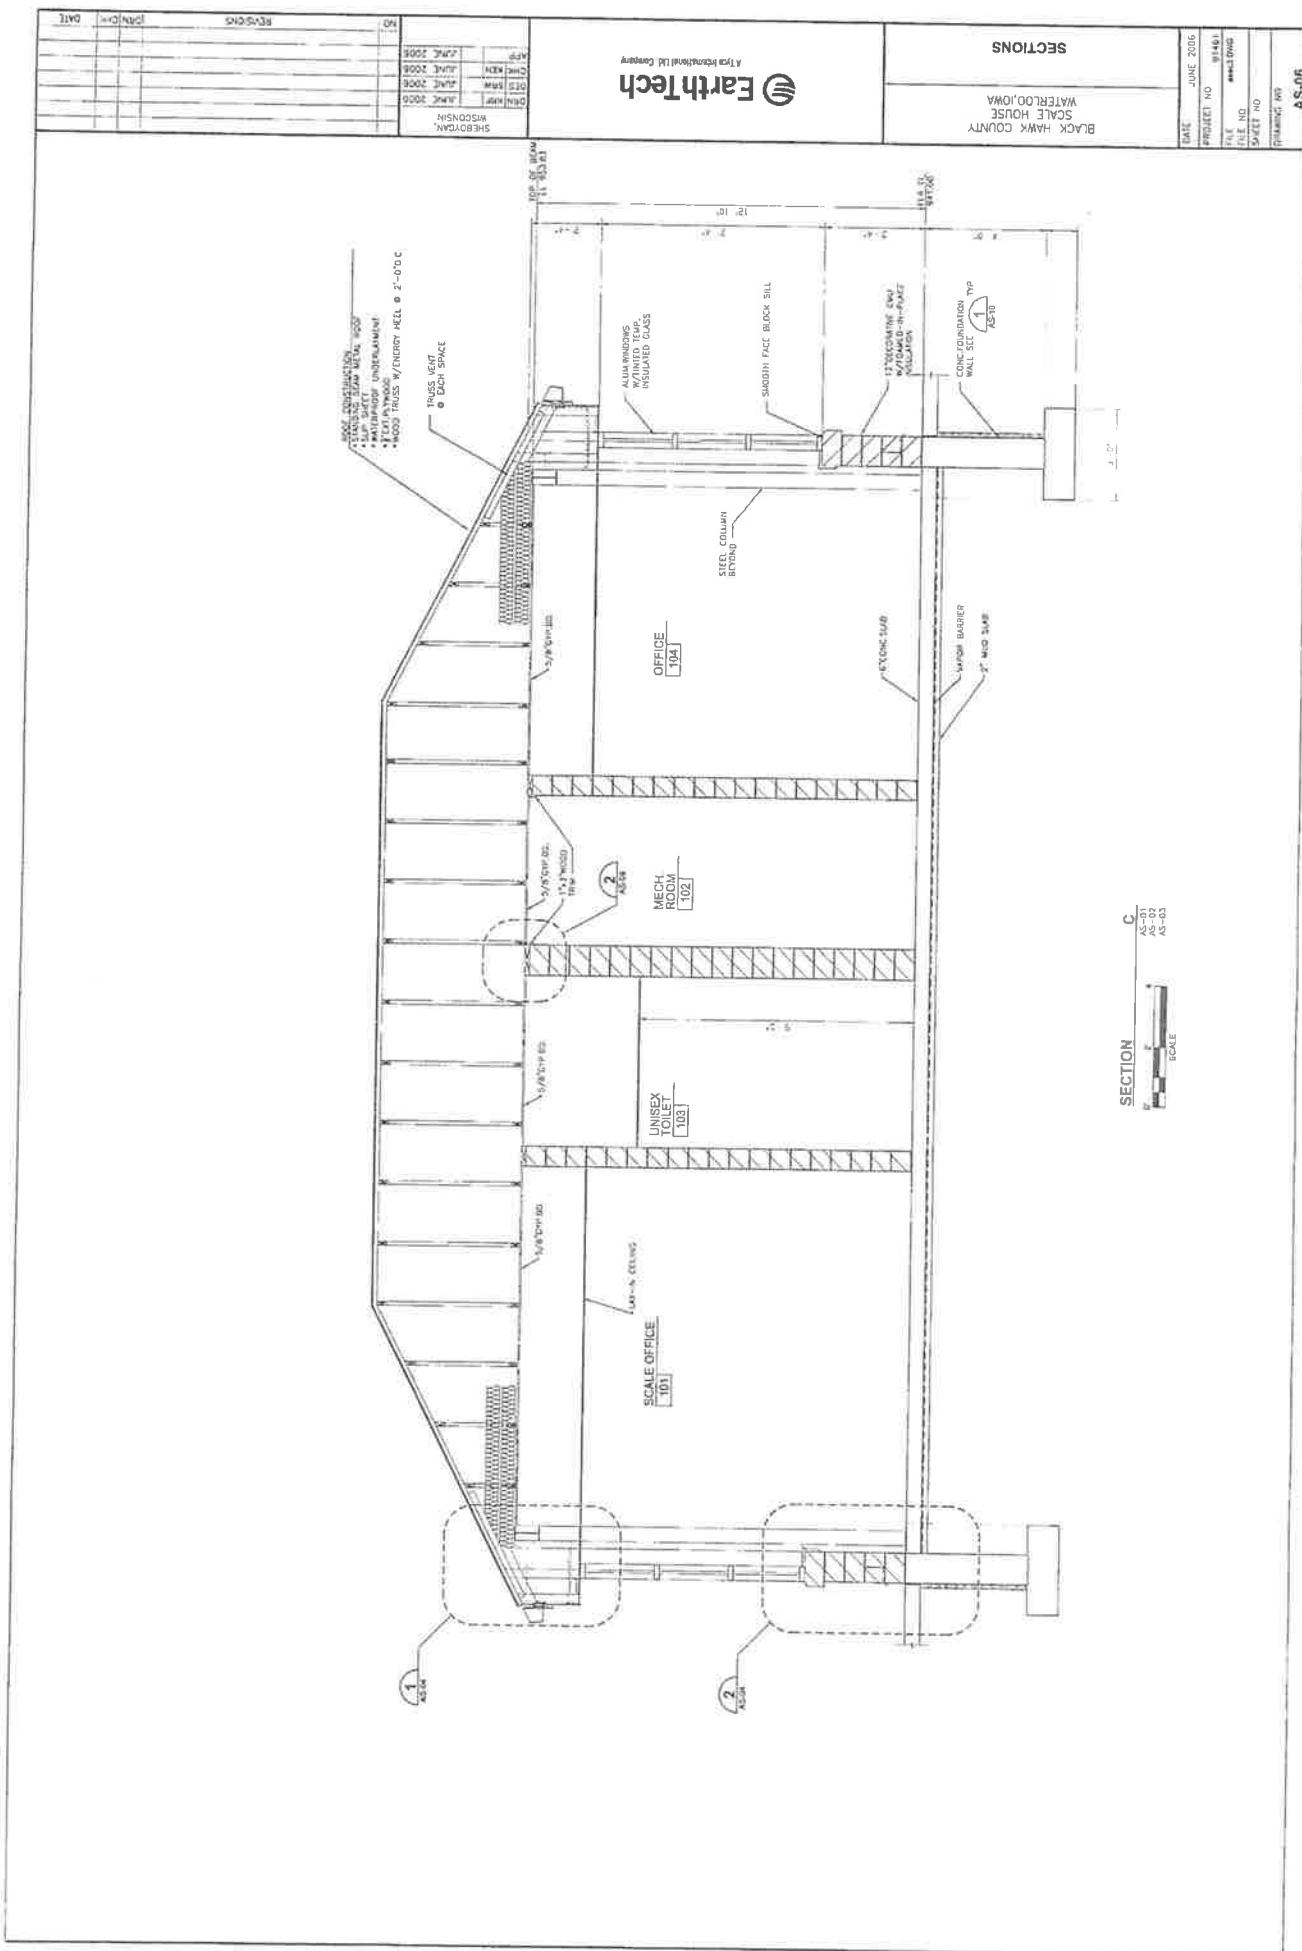


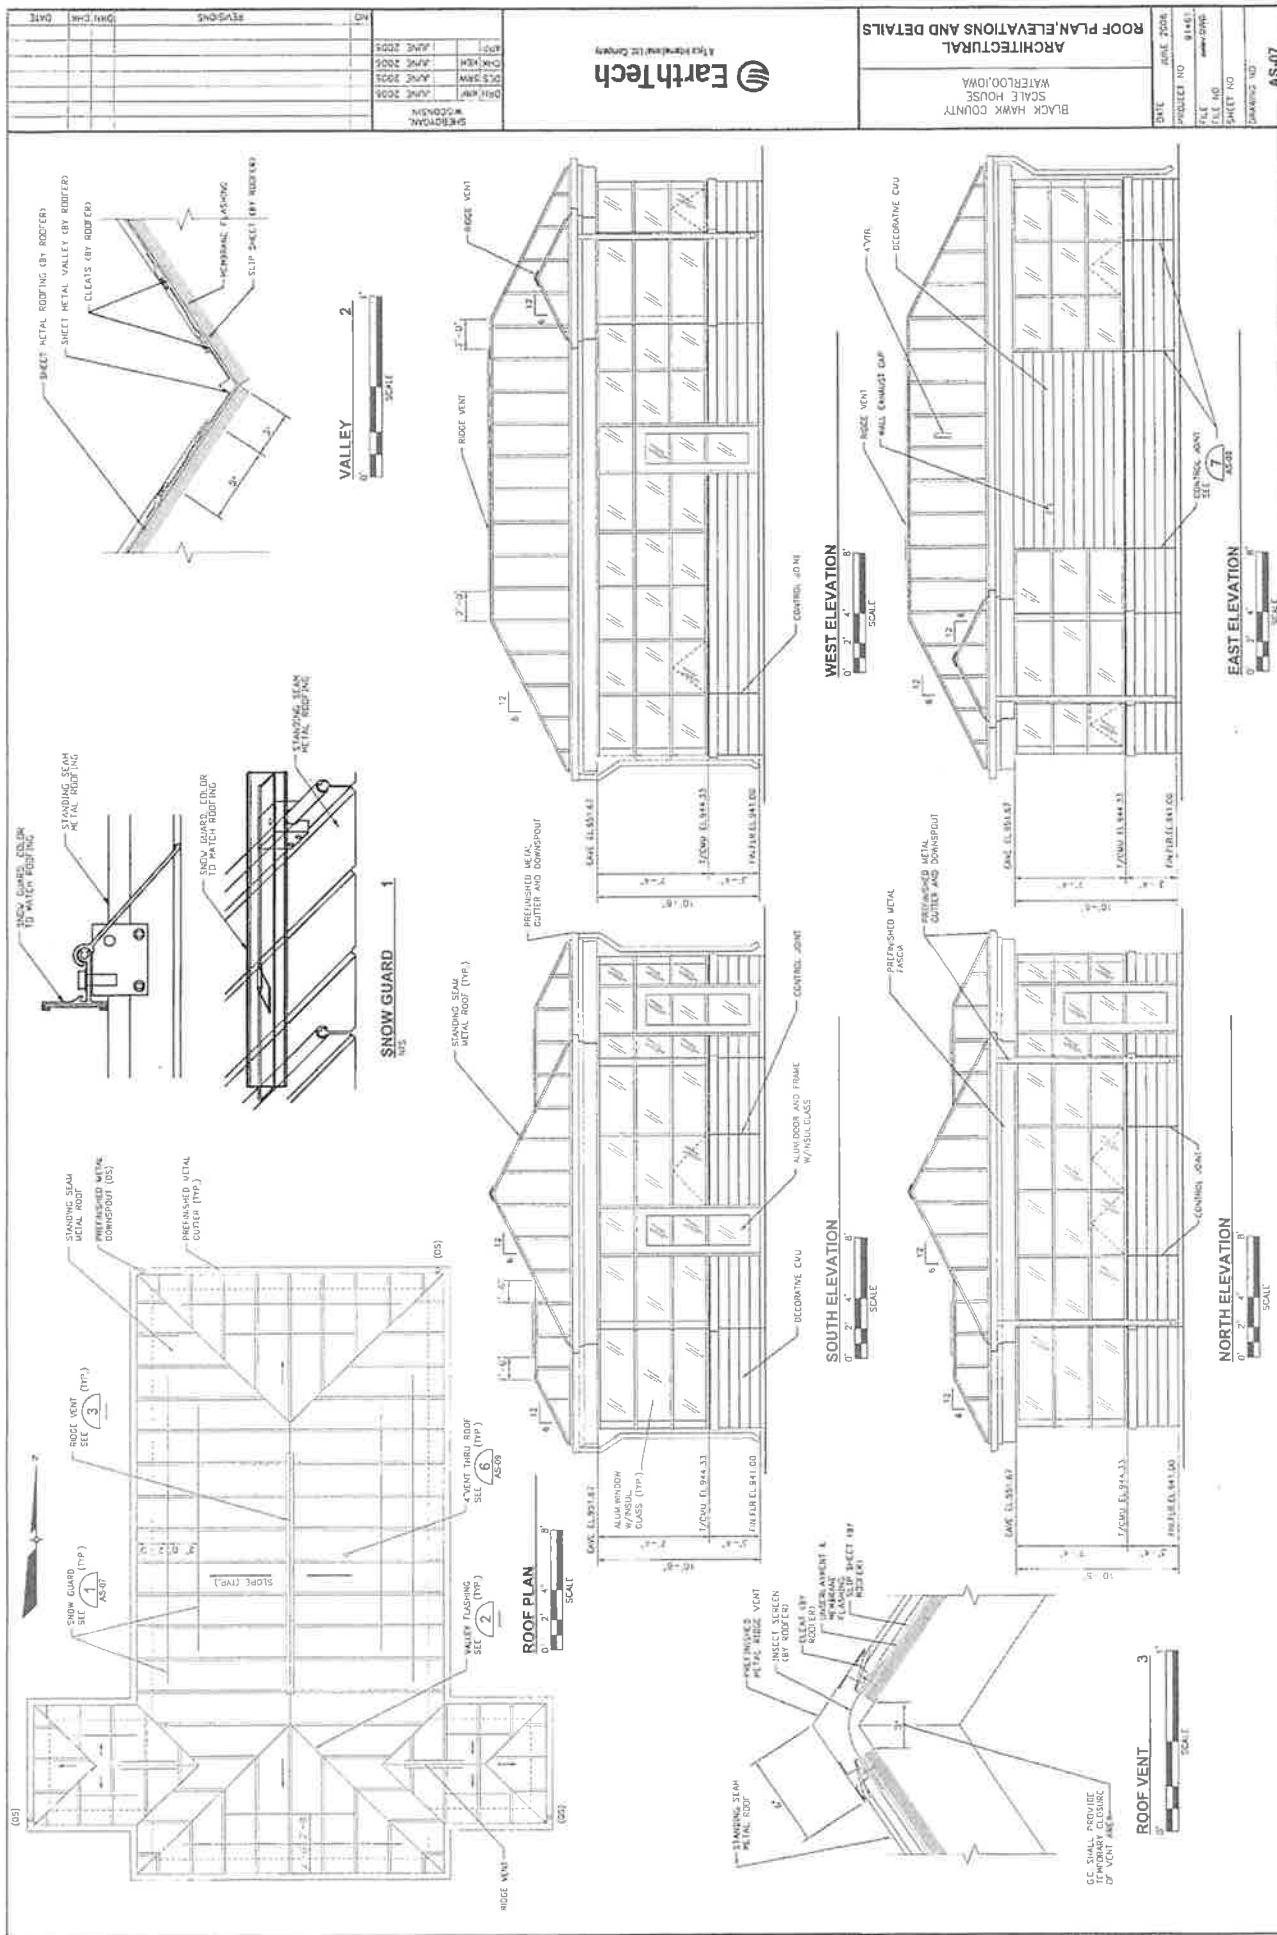


DATE	REVISIONS	LAST DRAWN NO	SHEET NO												
PROJECT NO	FILE NO.	DRAWING NO	AS-BD												
JUL 19, 2006	1471	1471													
2006	1471	1471													
DOOR, FRAME AND HARDWARE SCHEDULE															
(0308)	DOOR	DOOR HEIGHT	CLOSER (LCN)												
	LEAF	WIDHT	LOCKSET (HARDWARE)												
101	1	2'-0"	F-1												
102	1	3'-0"	F-1												
103	1	3'-0"	F-1												
104	1	3'-0"	F-1												
105	1	3'-0"	F-1												
106	1	3'-0"	F-1												
107	1	3'-0"	F-1												
ABBRIVIATONS															
GLR	GALVANIZED HOLLOW METAL														
SL	STEEL - INSULATED														
AI	ALUMINUM INSULATED														
B-1	DOOR TYPES														
E-1	FRAME TYPES														
E-2	FR-E-1														
B-2	DOOR TYPES														
FINISH SCHEDULE															
ROOM NUMBER	ROOM NAME	FLOOR	BASE	WALLS	CEILING	FLOOR	WALL	CEILING	FLOOR	WALL	CEILING				
BUILDING NO. 256 - MAINTENANCE GARAGE				FINISH				FINISH							
101	TOILET	1		1	1	1	1	1	1	1	1				
102	TOILET	1		1	1	1	1	1	1	1	1				
103	MECHANICAL ROOM	1		1	1	1	1	1	1	1	1				
104	OFFICE	1		1	1	1	1	1	1	1	1				
105	CUSTOMER ENTRY	1		1	1	1	1	1	1	1	1				
106	CUSTOMER ENTRY	1		1	1	1	1	1	1	1	1				
SIGNAGE				FINISH				FINISH							
1 - CLOSER TAILET															
2 - MECHANICAL ROOM															
3 - OFFICE															
EXTERIOR FINISH SCHEDULE				MATERIAL OF FINISH				EXTERIOR FINISH SCHEDULE							
TYPE	FINISH	DESCRIPTION	FINISH	TYPE	FINISH	DESCRIPTION	FINISH	TYPE	FINISH	DESCRIPTION	FINISH				
WALL ROOF PANELS	PAINTED	1. PAINTED	WALL ROOF PANELS	PAINTED	PAINTED	2. PAINTED	WALL ROOF PANELS	PAINTED	PAINTED	3. PAINTED	WALL ROOF PANELS	PAINTED			
ALUMINUM FRAMES	PAINTED	4. PAINTED	ALUMINUM FRAMES	PAINTED	PAINTED	5. PAINTED	ALUMINUM FRAMES	PAINTED	PAINTED	6. PAINTED	ALUMINUM FRAMES	PAINTED			
MISCELLANEOUS	PAINTED	7. PAINTED	MISCELLANEOUS	PAINTED	PAINTED	8. PAINTED	MISCELLANEOUS	PAINTED	PAINTED	9. PAINTED	MISCELLANEOUS	PAINTED			
STRUCTURE	PAINTED	10. PAINTED	STRUCTURE	PAINTED	PAINTED	11. PAINTED	STRUCTURE	PAINTED	PAINTED	12. PAINTED	STRUCTURE	PAINTED			
HOLLOW STEEL	PAINTED	13. PAINTED	HOLLOW STEEL	PAINTED	PAINTED	14. PAINTED	HOLLOW STEEL	PAINTED	PAINTED	15. PAINTED	HOLLOW STEEL	PAINTED			
HOLLOW METAL DOORS AND FRAMES	PAINTED	16. PAINTED	HOLLOW METAL DOORS AND FRAMES	PAINTED	PAINTED	17. PAINTED	HOLLOW METAL DOORS AND FRAMES	PAINTED	PAINTED	18. PAINTED	HOLLOW METAL DOORS AND FRAMES	PAINTED			
D-OPEN BOND	PAINTED	19. PAINTED	D-OPEN BOND	PAINTED	PAINTED	20. PAINTED	D-OPEN BOND	PAINTED	PAINTED	21. PAINTED	D-OPEN BOND	PAINTED			
GENERAL NOTES				GENERAL NOTES				GENERAL NOTES							
				LETTER IN UPRIGHT SHAPES INDICATE NUMBER INDICES COPPER RADIUS MATERIAL ON TRIM - NUMBER IN CIRCLE - NUMBER IN TRIANGLE - NUMBER IN ELLIPSE - NUMBER IN FISHBONE								FOOTNOTES			
				NOTE: ALL INTERIOR GLASS SHALL BE 1/4" CLEAR TEMPERED GLASS								O			
INTERIOR ALUM. FRAME				INTERIOR ALUM. FRAME				INTERIOR ALUM. FRAME				INTERIOR ALUM. FRAME			
WEST WINDOW ELEVATION				EAST WINDOW ELEVATION				WEST WINDOW ELEVATION				EAST WINDOW ELEVATION			
DOOR TYPES				DOOR TYPES				DOOR TYPES				DOOR TYPES			
WINDOW TYPES				WINDOW TYPES				WINDOW TYPES				WINDOW TYPES			
ARCHITECTURAL DETAILS				ARCHITECTURAL DETAILS				ARCHITECTURAL DETAILS				ARCHITECTURAL DETAILS			
SCHEDULES AND DETAILS				SCHEDULES AND DETAILS				SCHEDULES AND DETAILS				SCHEDULES AND DETAILS			

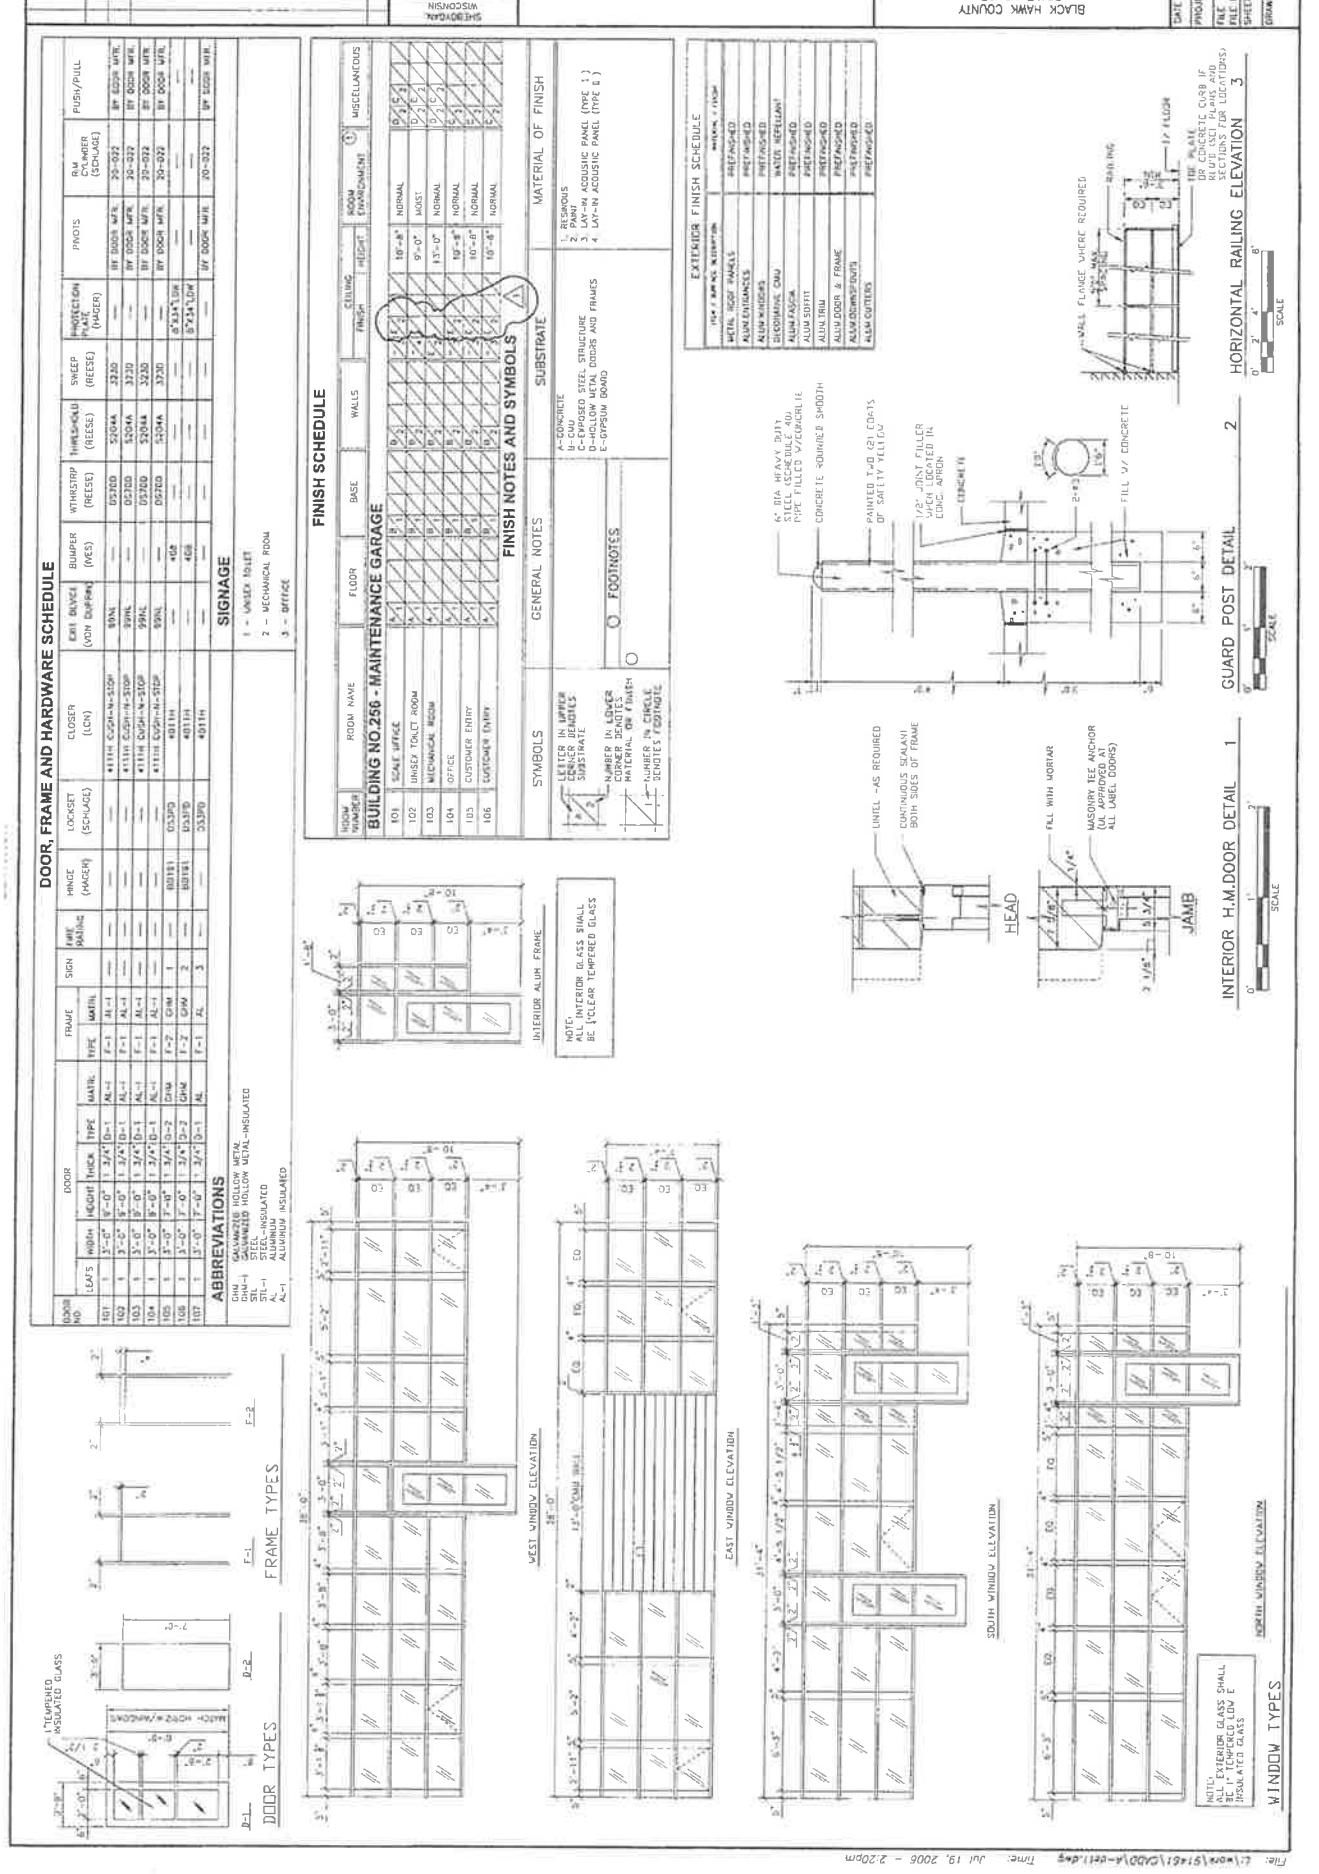


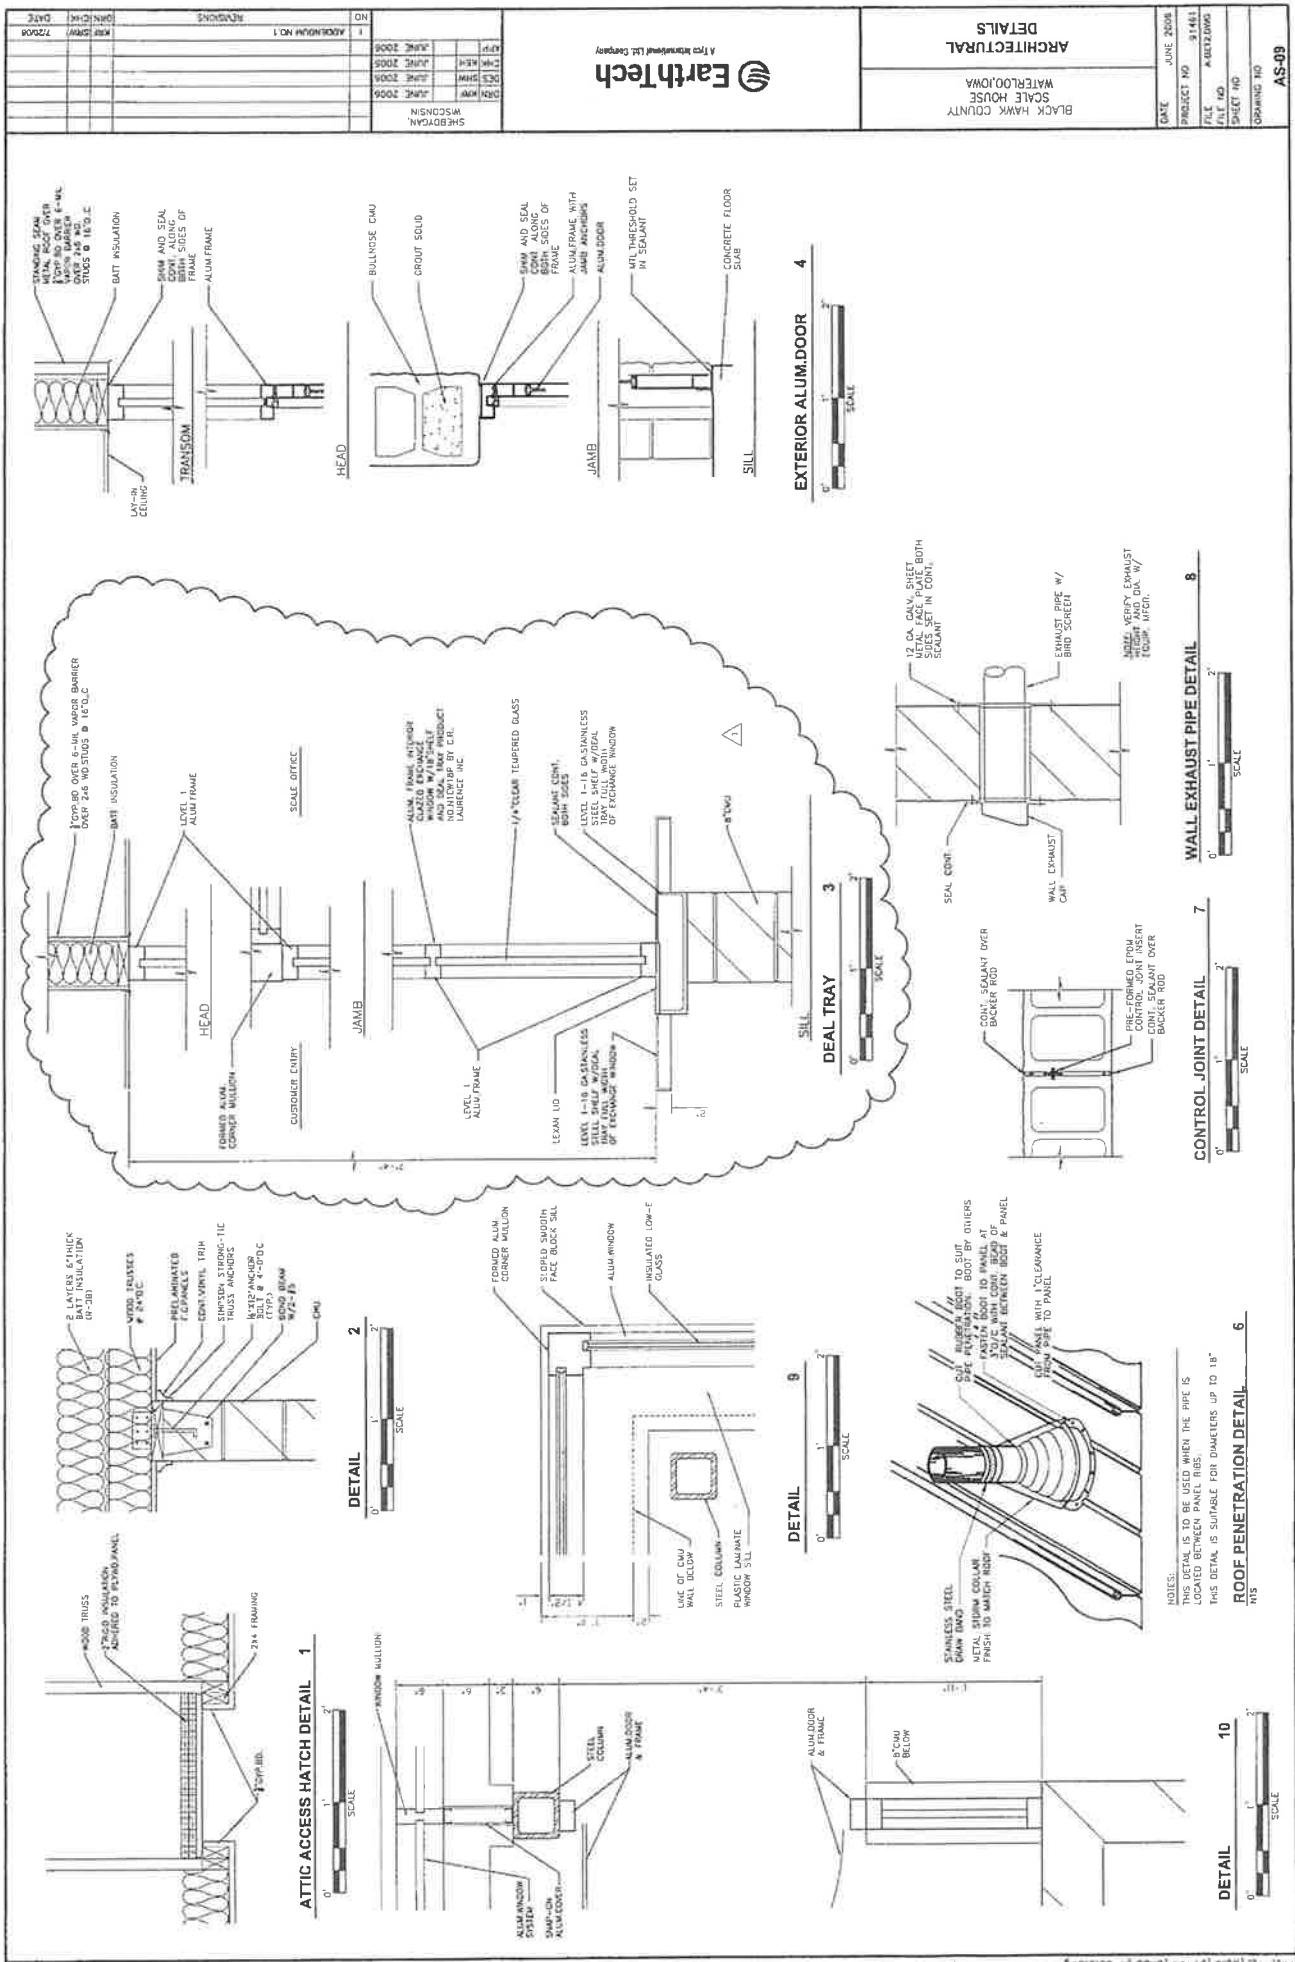

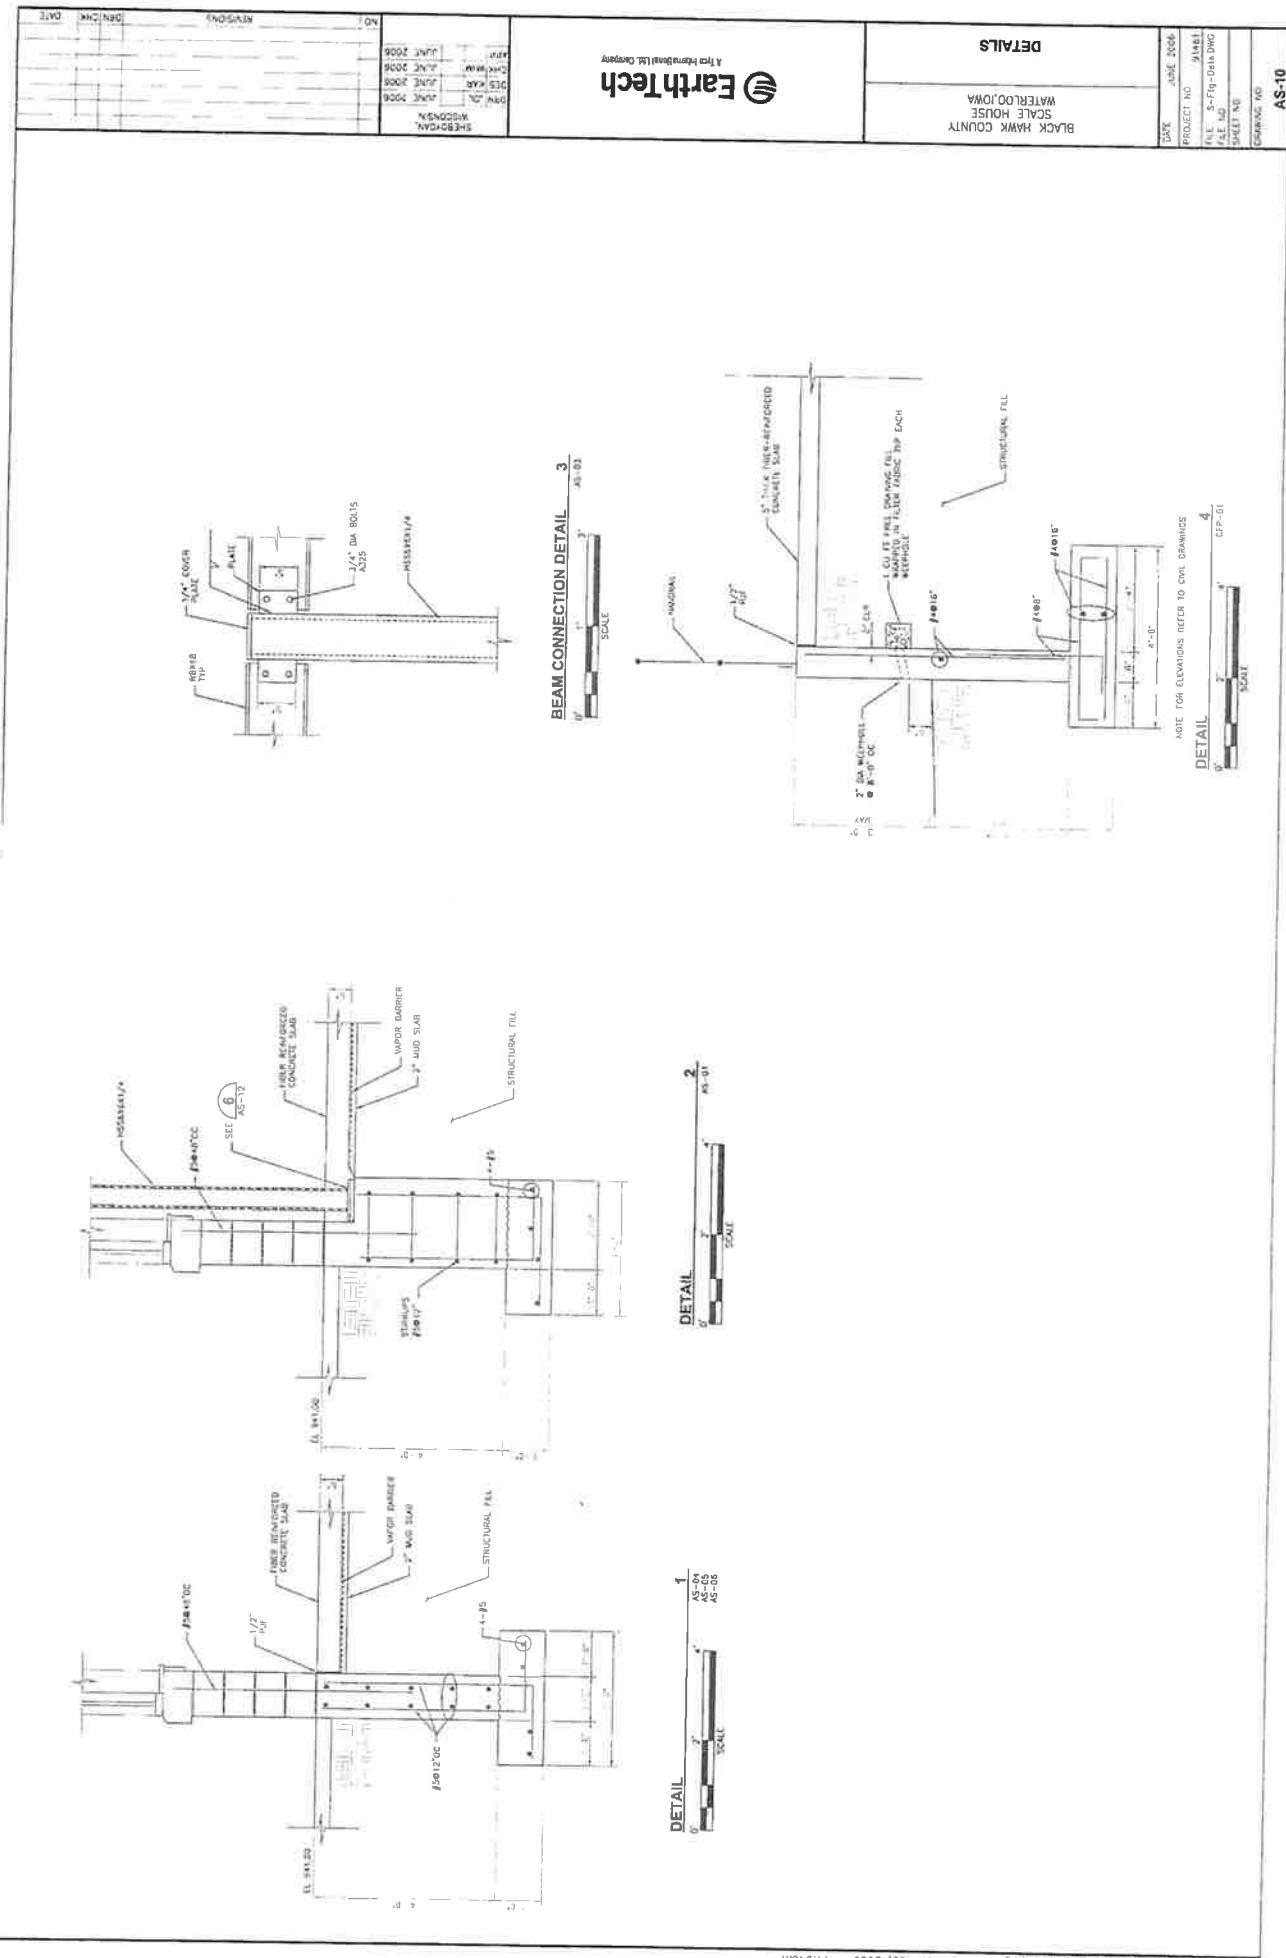

GENERAL STRUCTURAL NOTES		PLAN																																																																																					
<p>GENERAL</p> <p>1. THE GENERAL STRUCTURAL NOTES AND STANDARD STRUCTURAL DETAILS APPLY TO THE ENTIRE PROJECT UNLESS SPECIFICALLY STATED OTHERWISE.</p> <p>DESIGN CRITERIA</p> <p>1. DESIGN AND CONSTRUCT IN CONFORMANCE WITH THE INTERNATIONAL BUILDING CODE, 2003 EDITION</p> <p>2. SUPERIMPOSED DESIGN LOADS.</p> <p>A. ROOF LIVE LOAD: 20 PSF</p> <p>B. ROOF DEAD LOAD: 15 PSF</p> <p>C. MECHANICAL EQUIPMENT: VERIFY WITH EQUIPMENT SUPPLIER. (SEE EQUIPMENT SCHEDULES)</p> <p>D. STAIRS & WALKWAY:</p> <p>E. ROOF SNOW LOAD: 100 PSF FOR CONCENTRATED 1000 LBS CONCENTRATED</p> <p>F. GROUND SNOW LOAD: P_g</p> <p>G. FLAT FLOOR KNOW DRAFT: P_f</p> <p>H. SNOW LOAD CAPACITY FACTOR, C_s</p> <p>I. SNOW LOAD ACHORAGE FACTOR, C_a</p> <p>J. THERMAL FACTOR, C_t</p> <p>K. WIND LOAD:</p> <ul style="list-style-type: none"> 1. BASIC WIND SPEED, V_w 2. IMPORTANCE FACTOR, I_w 3. BUILDING CATEGORY, I_b 4. WIND EXPOSURE <p>L. SEISMIC DESIGN DATA:</p> <ul style="list-style-type: none"> A. SEISMIC USE GROUP B. IMPORTANCE FACTOR C. SPECTRAL RESPONSE COEFFICIENTS 1. SDS 2. SDI D. SITE CLASS E. SEISMIC DESIGN CATEGORY 		<p>7. BEFORE CONCRETE IS PLACED, CONSTRUCTION JOINTS SHALL BE CLEANED AND LATICE REMOVED AND SURFACE WETTED. STANDING WATER SHALL BE REMOVED.</p> <p>8. CONSTRUCTION JOINTS SHALL HAVE KEYS OR BOUNCHED SURFACES. CERENE ROUNCHED SURFACE IS USED, THE SURFACE SHALL HAVE AN AMPLITUDE OF $1/4"$ MM.</p> <p>9. PITCH ALL FLOORS TO FLOOR DRAINS AND CUTTERS. A MINIMUM OF $1/8"$ INCHES THICKNESS IS SHOWN ON THE DRAWINGS. MINIMUM THICKNESS OF SLAB AND DECK IF BEAMS SHALL BE AS INDICATED ON THE DRAWINGS. PITCH THE BOTTOM OF THE SLAB TO WATCH THAT THE TOP SLOPE OF THE SLAB TO MAINTAIN THE SLAB MAY BE POURED LEVEL PROVIDED THAT THE MINIMUM THICKNESS OR DEPTH IS MAINTAINED.</p> <p>10. CHAMFER EXPOSED EDGES OF CONCRETE $3/4"$ UNLESS OTHERWISE NOTED.</p> <p>11. EQUIPMENT PAD AND CURB LOCATIONS, DIMENSIONS AND HEIGHTS TO BE COORDINATED BY CONTRACTOR. VERIFY WITH EQUIPMENT MANUFACTURERS REQUIREMENTS.</p> <p>12. TOP BARS ARE HORIZONTAL BARS SO PLACED THAT MORE THAN 12" OF CONCRETE CAST IN THE MEMBER BELOW THE BAR ARE PROVIDED LESS THAN 4" BAR DIAMETERS. DO NOT EXCEED 12" OF CONCRETE.</p> <p>13. WHEN LAPPING TWO DIFFERENT SIZE BARS USE THE APP LENGTH OF THE SMALLER BAR UNLESS NOTED OTHERWISE.</p> <p>4. DEVELOPMENT LENGTH IS MINIMUM LENGTH OF EMBEDMENT FOR STRAIGHT BARS WHERE END HOOK IS NOT SHOWN, UNLESS OTHERWISE NOTED.</p> <p>5. COMPRESSION APP LENGTH FOR VERTICAL COLUMN BARS ONLY.</p> <p>6. HOOKS SHALL BE ACT STANDARD UNLESS OTHERWISE NOTED.</p> <p>MASONRY</p> <p>I. MASONRY OPENINGS LESS THAN 4'-0" IN WIDTH THAT DO NOT HAVE A LINTEL SCHEDULED SHALL HAVE A BOND BEAM WITH 2 #5 BARS OR DOUBLE STEEL ANGLE LINTEL WITH A TOTAL WIDTH OF HORIZONTAL LEGS APPROXIMATELY $1^{\prime}-0"$ LESS THAN WALL THICKNESS.</p> <p>2. PROVIDE A MINIMUM OF 8° BEARING AT EACH END FOR STEEL BEAM LINTELS AND BOND BEAM LINTELS AND 6° BEARING AT EACH END FOR ANGLE LINTELS UNLESS NOTED OTHERWISE.</p> <p>3. PROVIDE HORIZONTAL MASONRY REINFORCEMENT IN WALLS AT 16" O.C.</p> <p>4. FILL JAMB CORES OF OPENINGS OVER 3'-0" WIDE WITH MASONRY GROUP MAXIMUM UNLESS OTHERWISE NOTED.</p> <p>FROM BOTTOM OF LINTEL TO BOTTOM OF WALL, REINFORCE CORES WHERE NOTED.</p>																																																																																					
		<p>MINIMUM REINFORCEMENT BAR SPLICE AND ANCHORAGE LENGTH (INCHES)</p> <table border="1"> <thead> <tr> <th rowspan="2">BAR SIZE IN. - POUND</th> <th rowspan="2">EAR SIZE MM</th> <th rowspan="2">METRIC SIZE MM</th> <th colspan="4">DEVELOPMENT LENGTH</th> <th rowspan="2">STANDARD HOOK LENGTH</th> </tr> <tr> <th>TOP BARS</th> <th>OTHERS</th> <th>TOP BARS</th> <th>OTHERS</th> </tr> </thead> <tbody> <tr> <td>3</td> <td>10</td> <td>21</td> <td>16</td> <td>16</td> <td>17</td> <td>6</td> <td>12</td> </tr> <tr> <td>4</td> <td>13</td> <td>21</td> <td>16</td> <td>16</td> <td>17</td> <td>7</td> <td>15</td> </tr> <tr> <td>5</td> <td>16</td> <td>29</td> <td>23</td> <td>23</td> <td>17</td> <td>9</td> <td>19</td> </tr> <tr> <td>6</td> <td>19</td> <td>40</td> <td>31</td> <td>31</td> <td>24</td> <td>10</td> <td>25</td> </tr> <tr> <td>7</td> <td>22</td> <td>52</td> <td>40</td> <td>40</td> <td>31</td> <td>12</td> <td>27</td> </tr> <tr> <td>8</td> <td>25</td> <td>61</td> <td>47</td> <td>47</td> <td>36</td> <td>14</td> <td>30</td> </tr> <tr> <td>9</td> <td>29</td> <td>74</td> <td>57</td> <td>57</td> <td>44</td> <td>15</td> <td>34</td> </tr> <tr> <td>10</td> <td>32</td> <td>89</td> <td>68</td> <td>68</td> <td>53</td> <td>18</td> <td>38</td> </tr> <tr> <td>11</td> <td>36</td> <td>104</td> <td>90</td> <td>90</td> <td>62</td> <td>19</td> <td>42</td> </tr> </tbody> </table> <p>NOTES:</p> <ol style="list-style-type: none"> 1- TOP BARS ARE HORIZONTAL BARS SO PLACED THAT MORE THAN 12" OF CONCRETE CAST IN THE MEMBER BELOW THE BAR ARE PROVIDED LESS THAN 4" BAR DIAMETERS. DO NOT EXCEED 12" OF CONCRETE. 2. WHEN LAPPING TWO DIFFERENT SIZE BARS USE THE APP LENGTH OF THE SMALLER BAR UNLESS NOTED OTHERWISE. 3. DEVELOPMENT LENGTH IS MINIMUM LENGTH OF EMBEDMENT FOR STRAIGHT BARS WHERE END HOOK IS NOT SHOWN, UNLESS OTHERWISE NOTED. 4. COMPRESSION APP LENGTH FOR VERTICAL COLUMN BARS ONLY. 5. HOOKS SHALL BE ACT STANDARD UNLESS OTHERWISE NOTED. 6. HOOKS SHALL BE ACT STANDARD UNLESS OTHERWISE NOTED. <p>REINFORCEMENT SCHEDULE DETAIL</p> <p>2</p>		BAR SIZE IN. - POUND	EAR SIZE MM	METRIC SIZE MM	DEVELOPMENT LENGTH				STANDARD HOOK LENGTH	TOP BARS	OTHERS	TOP BARS	OTHERS	3	10	21	16	16	17	6	12	4	13	21	16	16	17	7	15	5	16	29	23	23	17	9	19	6	19	40	31	31	24	10	25	7	22	52	40	40	31	12	27	8	25	61	47	47	36	14	30	9	29	74	57	57	44	15	34	10	32	89	68	68	53	18	38	11	36	104	90	90	62	19	42
BAR SIZE IN. - POUND	EAR SIZE MM	METRIC SIZE MM	DEVELOPMENT LENGTH				STANDARD HOOK LENGTH																																																																																
			TOP BARS	OTHERS	TOP BARS	OTHERS																																																																																	
3	10	21	16	16	17	6	12																																																																																
4	13	21	16	16	17	7	15																																																																																
5	16	29	23	23	17	9	19																																																																																
6	19	40	31	31	24	10	25																																																																																
7	22	52	40	40	31	12	27																																																																																
8	25	61	47	47	36	14	30																																																																																
9	29	74	57	57	44	15	34																																																																																
10	32	89	68	68	53	18	38																																																																																
11	36	104	90	90	62	19	42																																																																																
		<p>STRUCTURAL DETAILS</p> <p>EarthTech</p> <p>A. <i>The information in this document</i></p> <p>BLACK HAWK COUNTY WATERHOUSE</p> <p>STRUCTURAL DETAILS</p> <p>DATE: JUNE 2006</p> <p>PROJECT NO: 91453</p> <p>FILE: 5-GEN-DIG</p> <p>SHEET NO:</p> <p>DRAWN BY:</p>																																																																																					

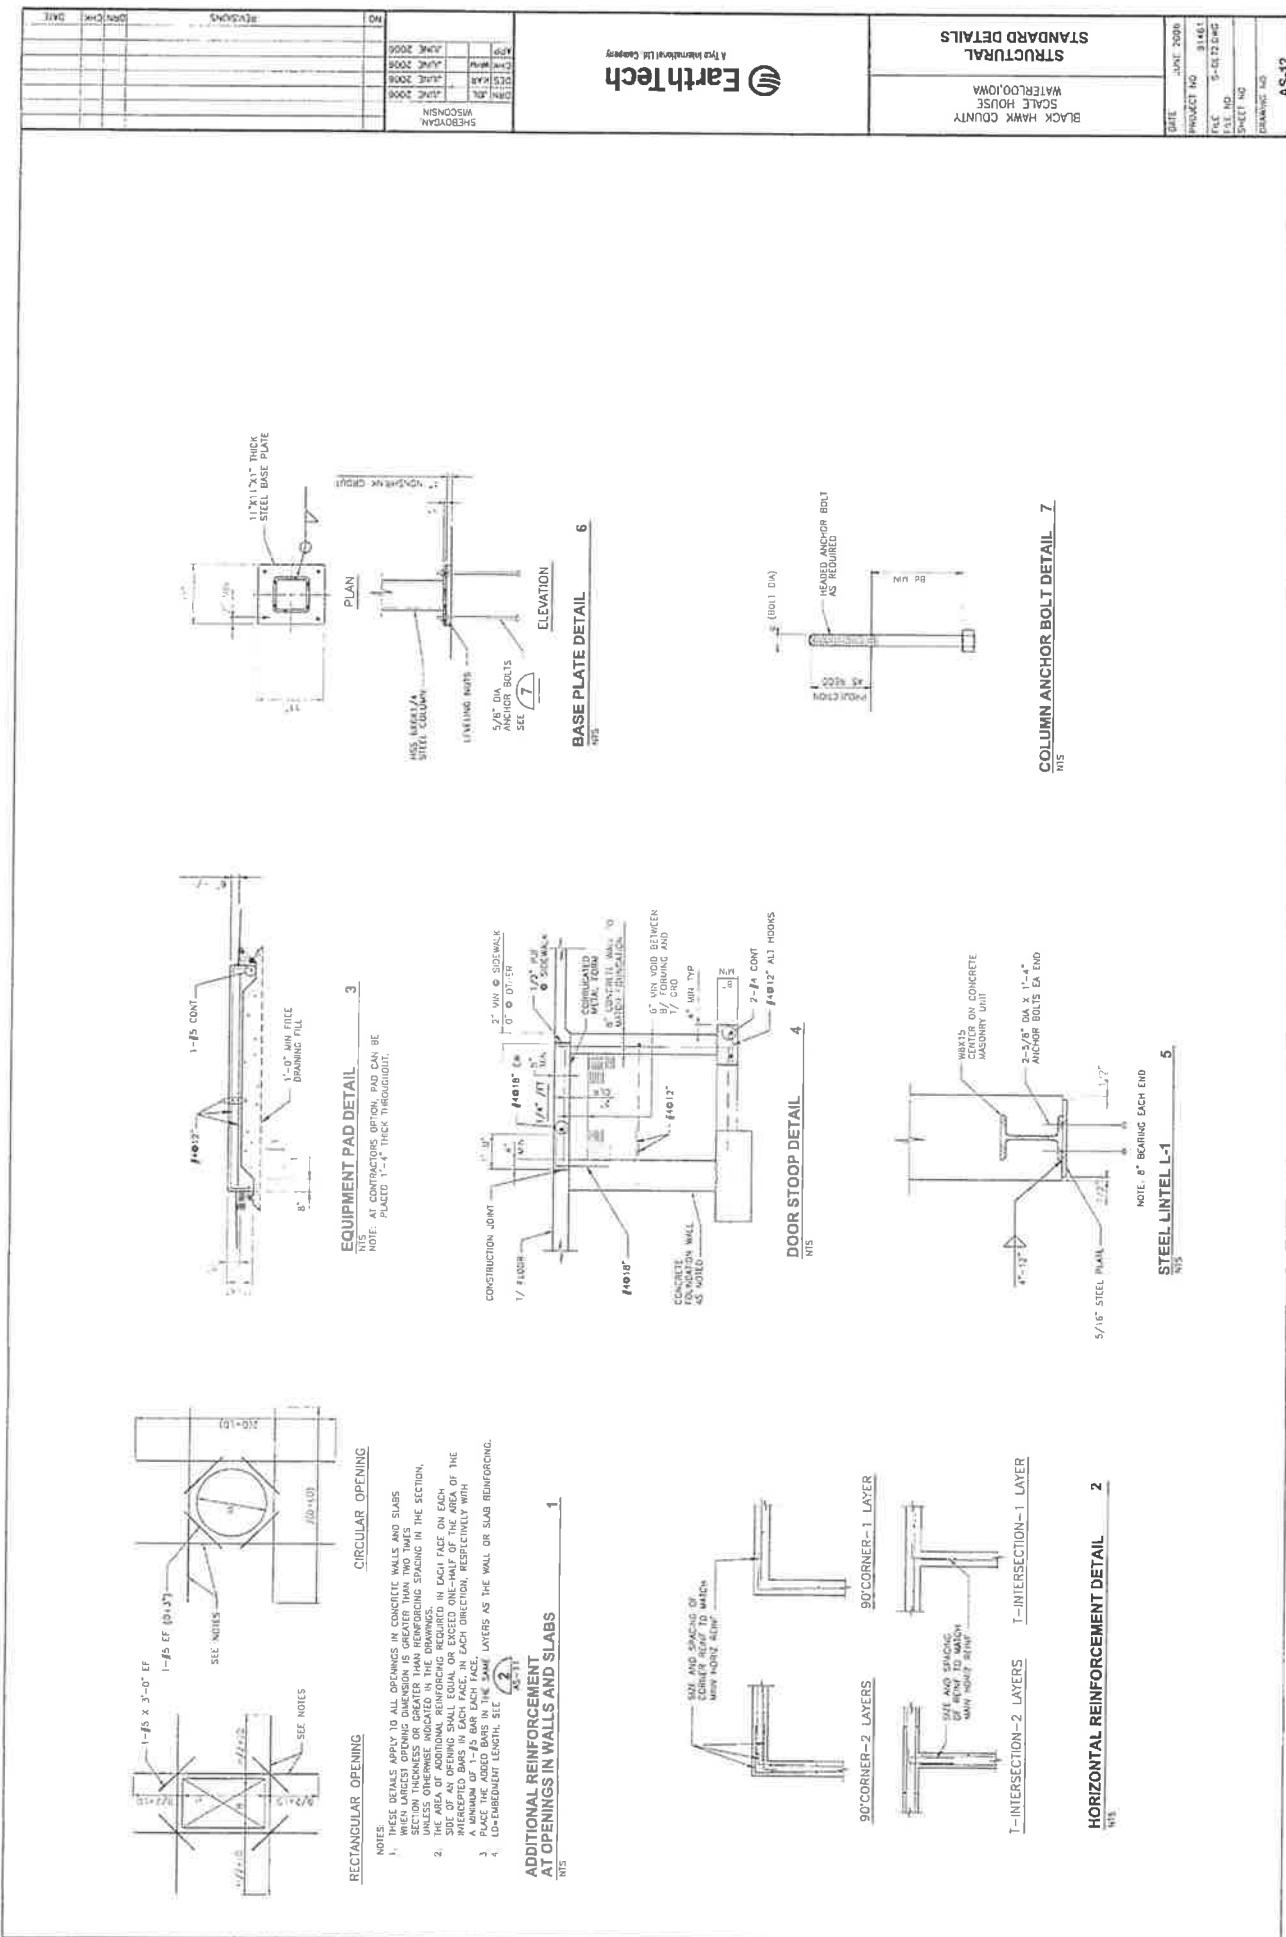

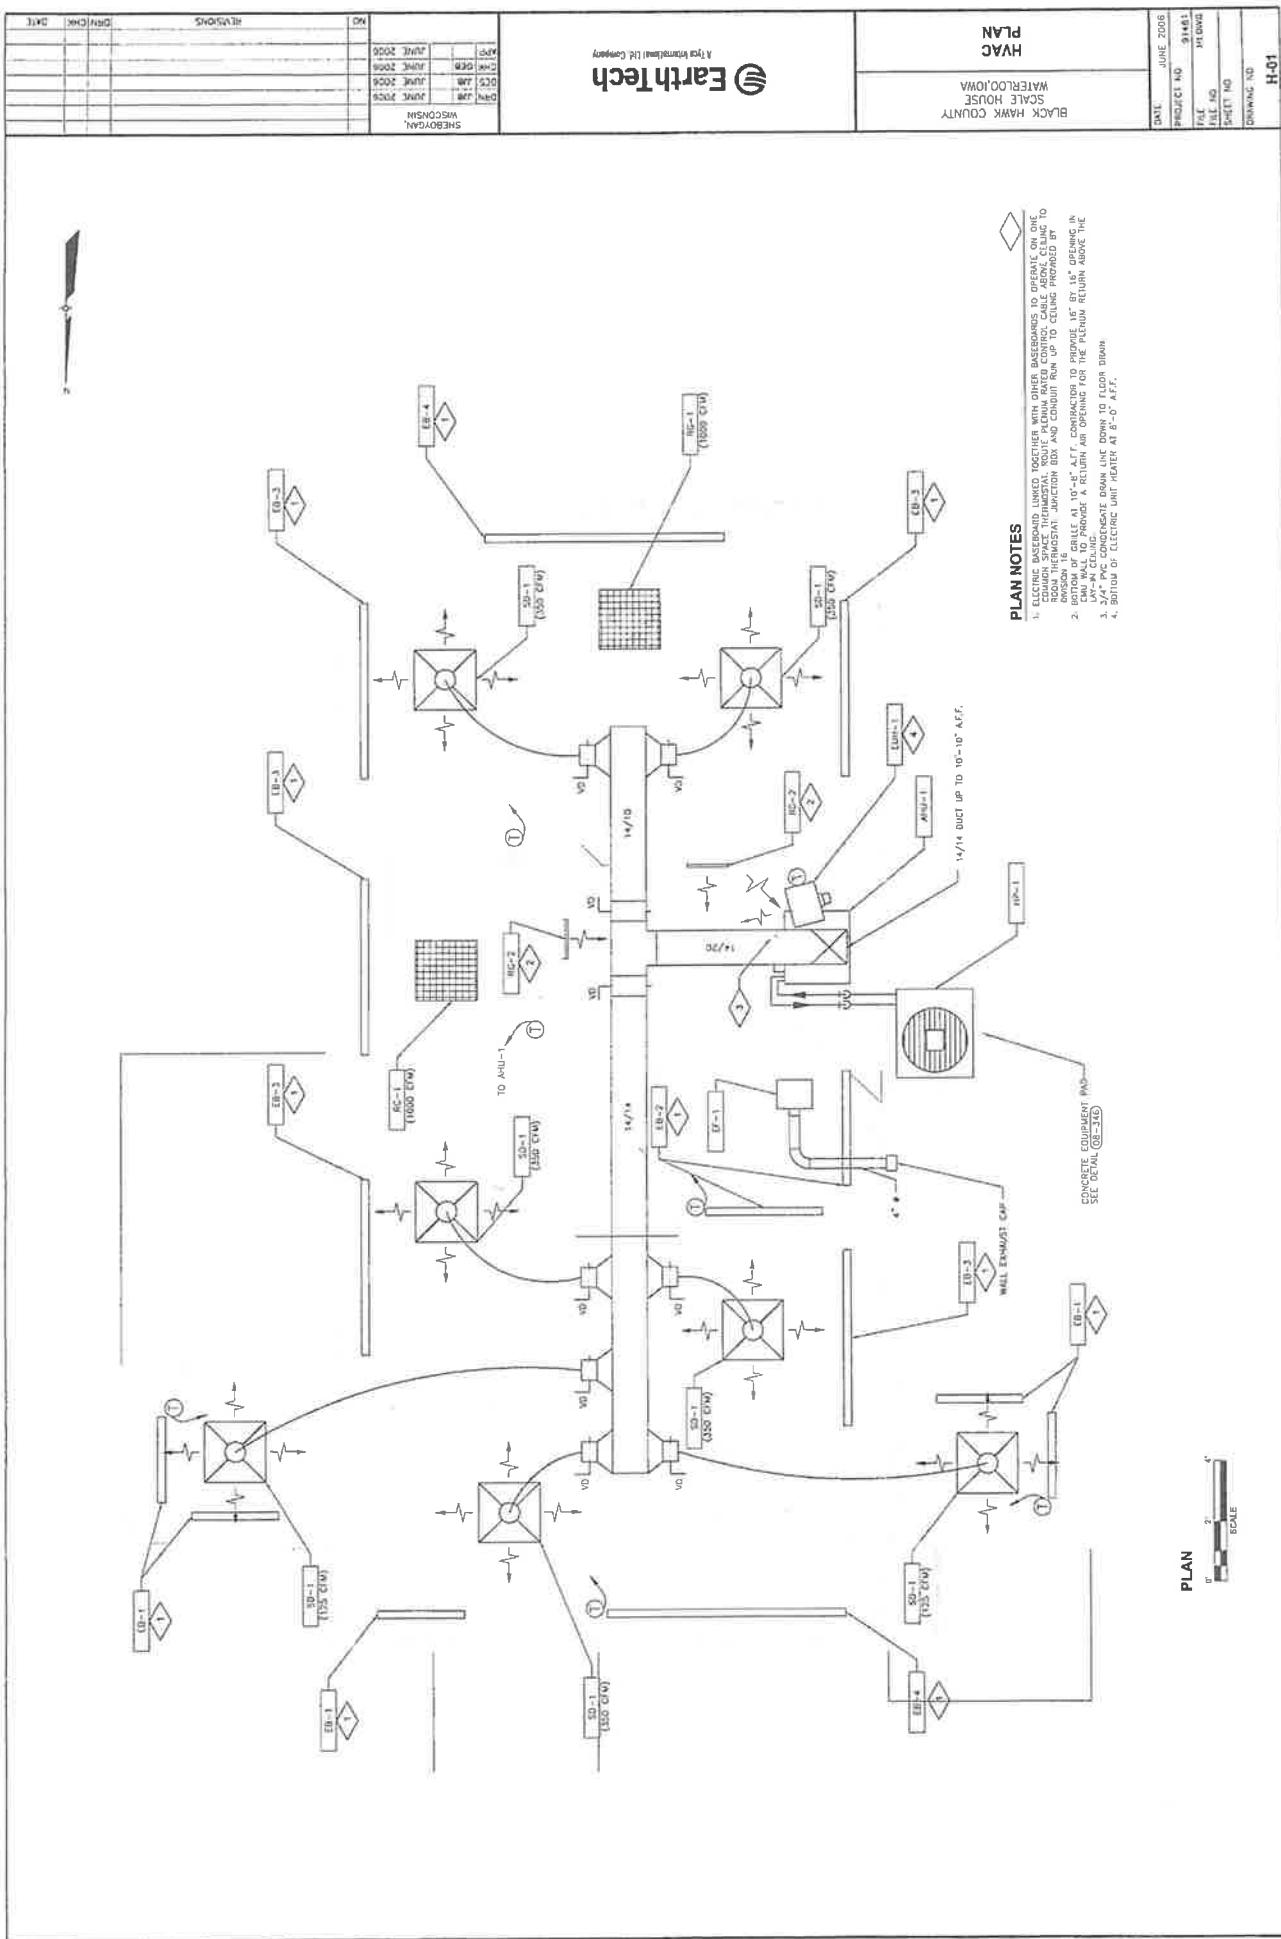

ELECTRIC CONVECTOR AND BASEBOARD SCHEDULE									
TAG NO.	MANUFACTURER MODEL NO. OR EQUAL	TYPE	OUTPUT (WATTS)	KWH	VOLTS	PHASE	AMP	REMARKS	
EB-1	QUARK CBO12A	34" BASEBOARD	750	.15	240	1	.31	LOW VOLTAGE RELAY SECTION, 25A @ 240V, TYP. OF 5	
EB-2	QUARK EBD1204	45" BASEBOARD	1000	.150	240	1	.42	LOW VOLTAGE RELAY SECTION, 25A @ 240V, TYP. OF 2	
EB-3	QUARK CBO1504	70" BASEBOARD	1500	.150	240	1	.63	LOW VOLTAGE RELAY SECTION, 25A @ 240V, TYP. OF 5	
EB-4	QUARK CBO2004	94" BASEBOARD	2000	.200	240	1	.83	LOW VOLTAGE RELAY SECTION, 25A @ 240V, TYP. OF 2	

AIR INLET AND OUTLET SCHEDULE									
TAG NO.	MANUFACTURER MODEL NO. OR EQUAL	SERVICE	MAX APG (in w.c.)	PATTERN	MAX INC.	FINISH	UNIVERSAL	ACCESSORIES	WELLING
RG-1	WILDFIRE SOFFIT	RETURN AIR REFLUX	02	10	EGGCRATE	WHITE	ALUMINUM	FILTER	LAY-IN
SG-1	WILDFIRE SOFFIT	SUPPLY	12	28	ALUMINUM FILTER	WHITE	ALUMINUM	DAMPER	LAI-IN
RG-2	WILDFIRE SOFFIT	RETURN AIR REFLUX	05	15	OF DEFLECTION	WHITE	ALUMINUM		SURFACE

EXHAUST FAN SCHEDULE												
TAG NO.	MANUFACTURER MODEL NO. OR EQUAL	TYPE	AIR DATA	FAN SPD RPM	WATT	VOL	PHASE	FAN DATA	REMARKS			
CE-1	GRESHOCK'S 50-FBEO	CEILING	.76	410	5 WATTS	500	1971	54 WATTS	115	1	900 RPM	DAMPER

BOD = BACKDRAFT DAMPER, WALL EXHAUST HOOD

PT = PROGRAMMABLE THERMOSTAT

AIR COOLED CONDENSING UNIT (HEAT PUMP) SCHEDULE												
TAG NO.	MANUFACTURER MODEL NO. OR EQUAL	CODING/HEATING CAPACITY (BTUH)	NOMINAL TONS	ABSENT WATER TEMP. (°F)	STABILIZED WATER/WATER TEMP. (°F)	UNLOADING TEMP. (°F)	FAN DATA	FAN DATA	REMARKS			
HEU-1	CARRIER MBC-1260	60/724	.5	85/-14	45	16 x 25*	1/4	1.5	60	240	Y	P1, LOW AMBIENT APPLICATION

* BOD = BACKDRAFT DAMPER, WALL EXHAUST HOOD

AIR HANDLING UNIT SCHEDULE																
TAG NO.	MANUFACTURER MODEL NO. OR EQUAL	ENQ DATA	ENQ [CFM (m³/h)]	OUTPUT [CFM (m³/h)]	FILTER DATA	COOL [BTU/H (kW)]	HEAT [BTU/H (kW)]	WASH [BTU/H (kW)]	REMARKS							
AHU-1	MACC AIR 600 ERQ	27000	0.50	0.59	946	7"	PI-LATED	(2) 16" x 25"	0.20	DX	5.1	1	240	1	1725	RETURN AIR PLenum, PLAT FLOOR, CEILING, DUCT

PT = PROGRAMMABLE THERMOSTAT

ELECTRIC UNIT HEATER SCHEDULE																	
TAG NO.	MANUFACTURER MODEL NO. OR EQUAL	ENQ	OUTPUT (Watt)	MOUNT. [FT ²] [m ²]	AIR ENQ	EECM [BTU/H (kW)]	TYPE [A/I]	COOL [BTU/H (kW)]	REMARKS								
EUE-1	QUARK U-524	INDUSTRIAL	17,0	0	270	16	60	5	240	Y	24	6	WATTS	240	8	1440	COMBINATION WALL/CEILING BRACKET


EarthTech


HVAC SCHEDULES & DETAILS

BLACK HAWK COUNTY WATERHOUSE

DATE: JUNE 2006 - 12:00pm

DATE	JUNE 2006
PROJECT NO.	91461
FILE NO.	HZ.DWG
HEET NO.	002
DRAWING NO.	H-02

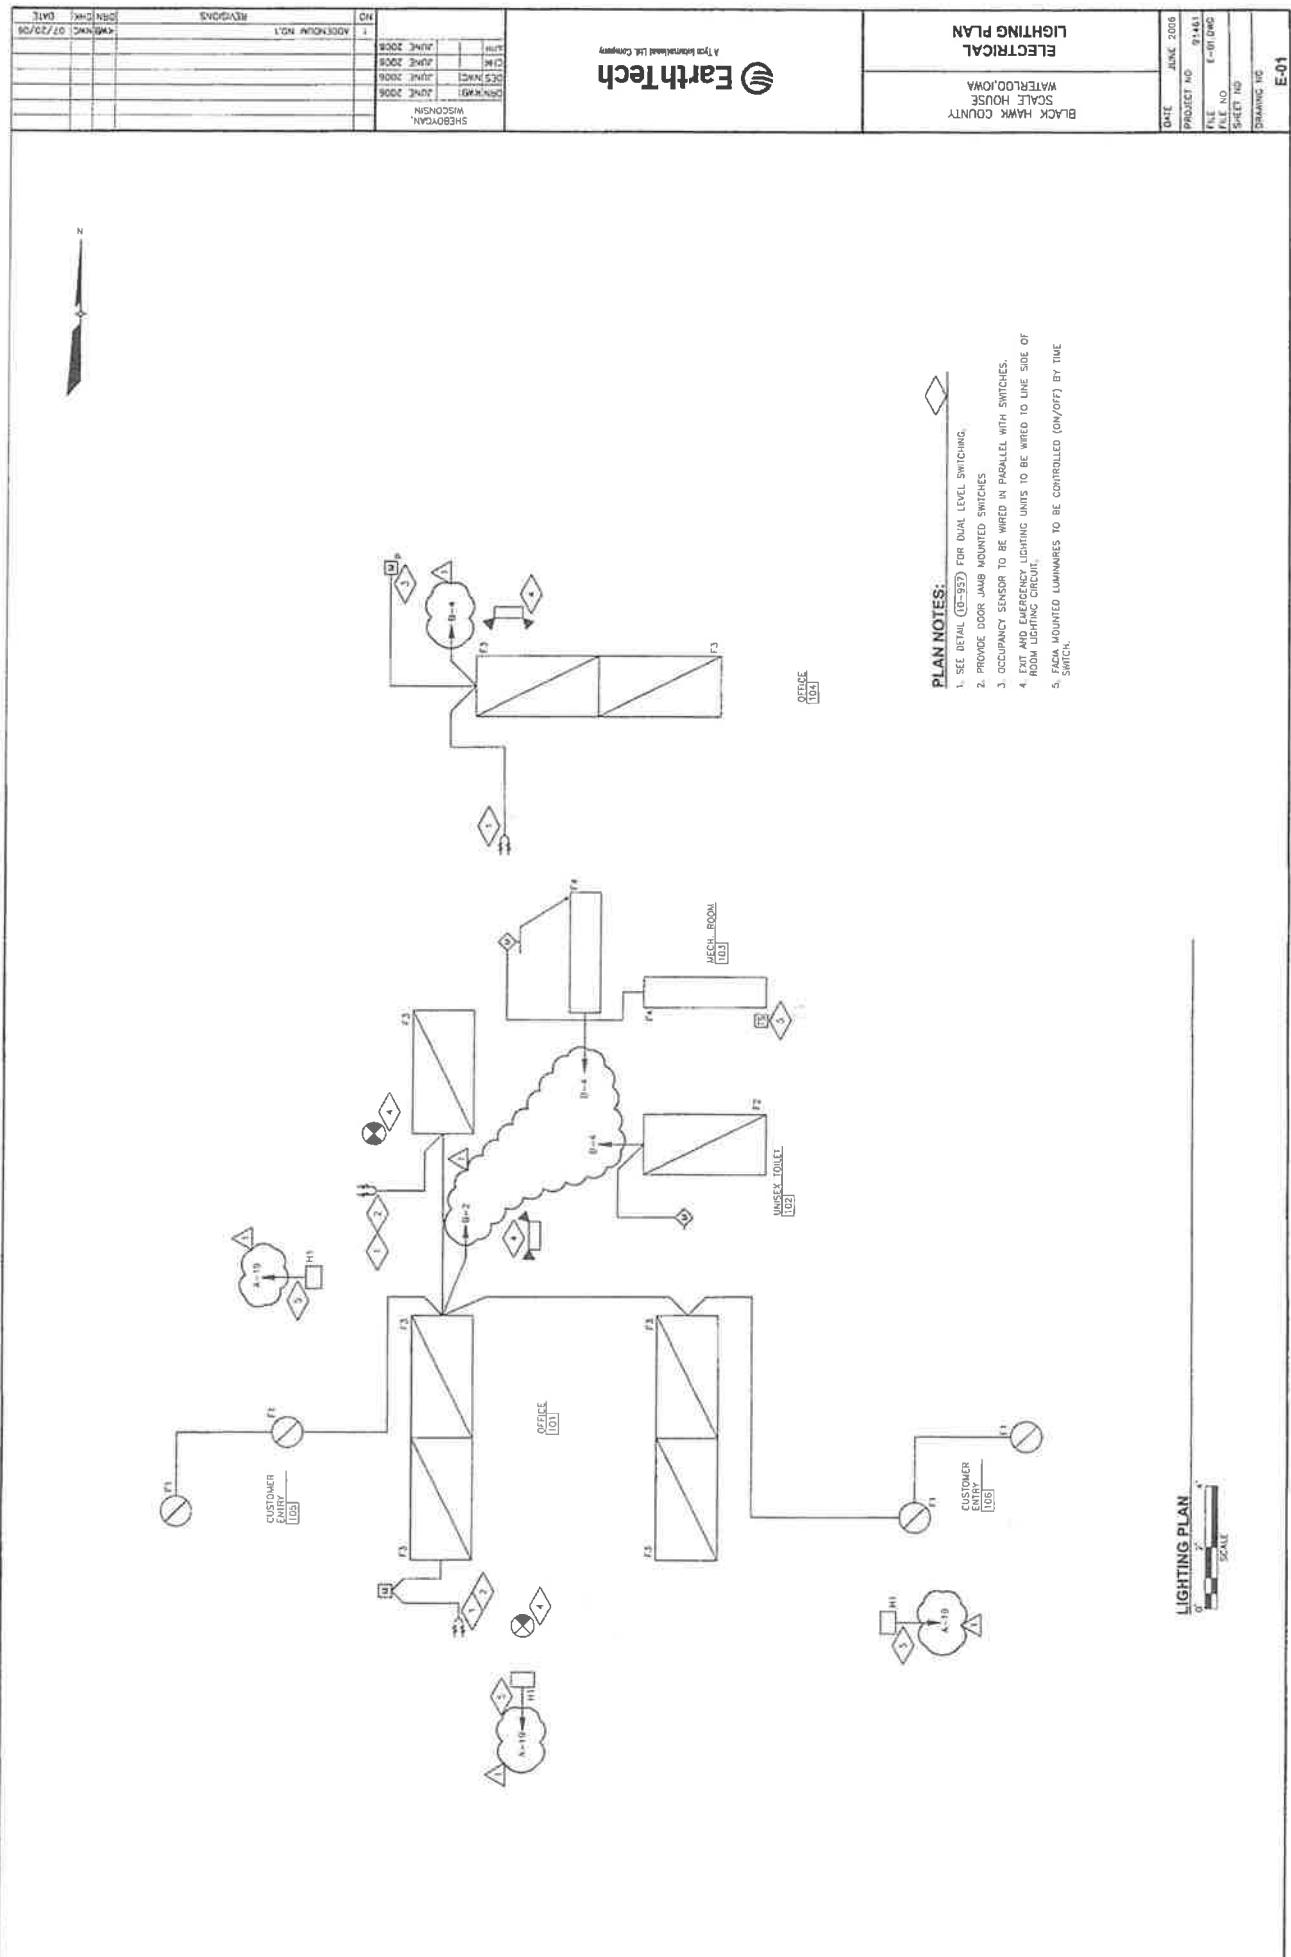

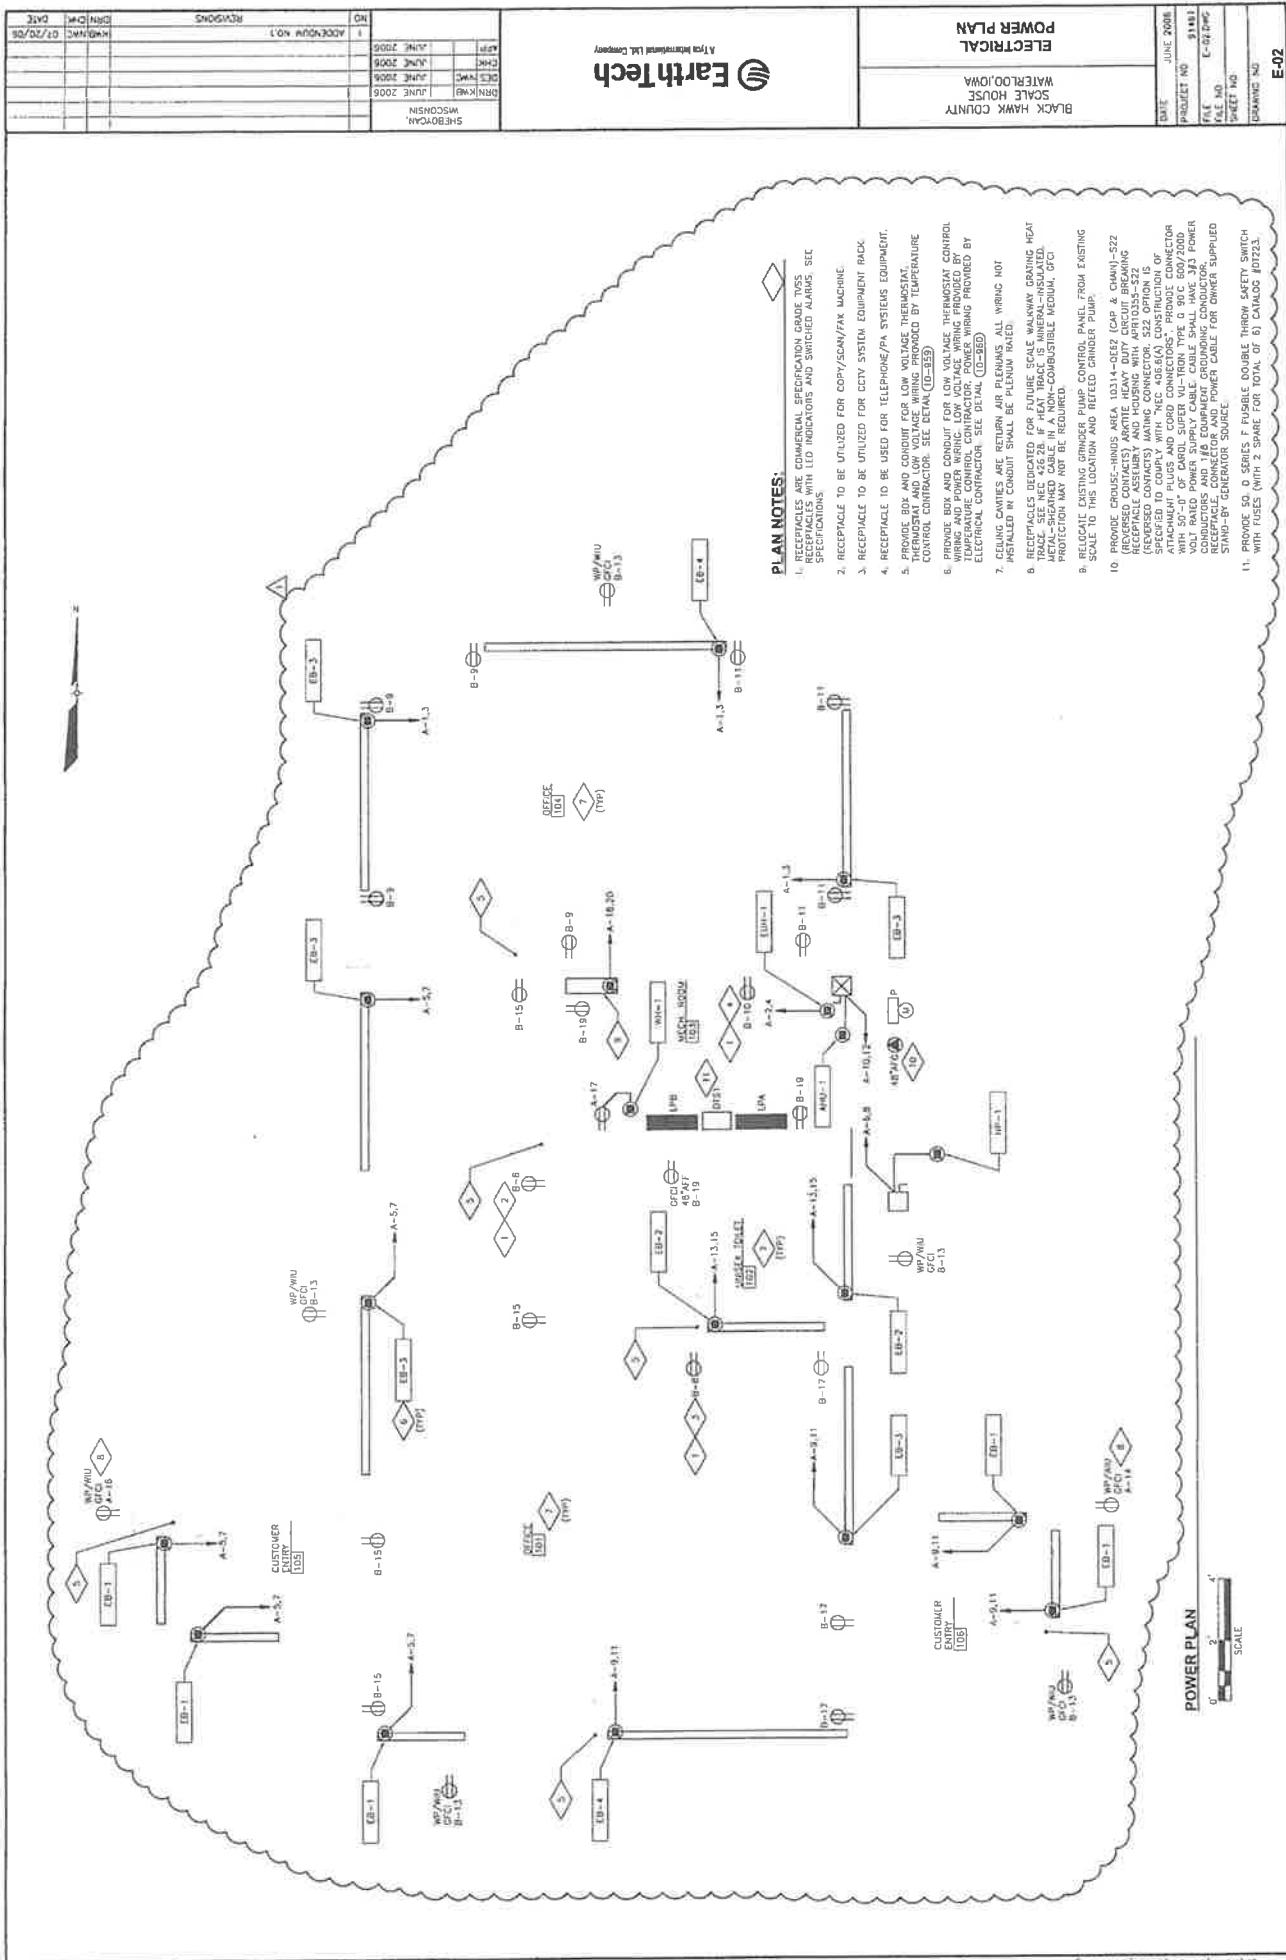

SHEBOYGAN WISCONSIN		TEN KIRK 314th 2006		JUN 2006		APR 2006		JUN 2006		APR 2006		JUN 2006	
BLACK HAWK COUNTY WATERHOUSE		SCALIE HOUSE		DES-NIC									
Attn: [REDACTED] M.L. Department													
EARTHTECH													
SYSTEMS PLAN													
ELECTRICAL													
File: 41-00000-00000000 Date: Jun 26, 2006 - 9:57am													

PLAN NOTES:

1. PROVIDE 3/4" x 10' x 48" Plywood backboard. Paint all surfaces and edges with two coats of gray enamel. Mount to wall with two (2) 7/8" x 5/8" x 4" galvanized U-shaped channels.
2. PROVIDE 2" SCH 40 PVC conduit stubbed out 5'-0" from building for telephone/data service. Conduit to be 30" below finished grade.
3. SEE DETAIL (D-3B) FOR VOICE AND/OR DATA JACK INSTALLATION.
4. VOICE/DATA JACK TO SERVE CCIV EQUIPMENT RACK
5. VOICE/DATA JACK TO SERVE CCIV EQUIPMENT RACK
6. 1/4" x 10' x 48" Plywood backboard
7. PELOCC CIV EQUIPMENT RACK





DATE: JUNE 2006
PRODUCT #: 91461
FILE #: 41-00000-00000000
SHEET NO.: 1
DRAWING NO.: E-03

REVISIONS		E-2006	
DATE		07/03/06	
PROJECT NO.		91451	
FILE NO.		E-C44HC	
DRAWING NO.		E-04	

LIGHTING FIXTURE SCHEDULE					
FIXTURE TYPE	LAMPS	DESCRIPTION	MANUFACTURER / CATALOG NUMBER	NOTES	
F1	120V/CF/PL/BS5	6" COMPACT FLUORESCENT DOWNLIGHT WITH RECESSED PHYSICAL GLASS LENS AND MULTIVOLT ELECTRONIC BALLAST. OR EQUALS BY CAPRI OR HALO.	PHILIPS 470140B-1889-J47W-05SPR		
F2	120V/735	2'x4' STATIC RECESSED TRIMMER SUITABLE FOR SUSPENDED CEILING GRID MOUNTING. LENS IS PATTERN A12, 0.125 THICK. OR EQUAL BY DAY-BRITE OR WILLIAMS	COLUMBIA JIB24-232GC-FSA12-125-EBB-110-PAF		
F3	120V/SP35	F03216/735 OR F3128/SP35	COLUMBIA JIB24-432G-FBB-120	SEC. DETAIL 10-357	
F4	120V/SP35	COMPACT RECESSED TRIMMER SUITABLE FOR SUSPENDED CEILING GRID MOUNTING. LENS IS PATTERN A12, 0.125 THICK. 2 BALLASTS FOR DUAL LIGHTING. OR EQUAL BY DAY-BRITE OR WILLIAMS	COLUMBIA JIB24-342-G-120		
F5	120V/SP35	COMPACT EXTERIOR WALL PACK WITH GLASS REFRACTOR AND HUBBELL SECURITY LIGHTING SPW-70IPS-M17	HUBBELL RMC-3-VIND-25S4B-3 WITH POD, ARM AND PHOTOCONTROL. OR EQUALS BY STREETWORKS OR GE		
H1	120V	DISCAST ALUMINUM HOUSING. COLOR AS SELECTED BY FACTORY	HUBBELL RMC-3-VIND-25S4B-3 WITH POD, ARM AND PHOTOCONTROL. OR EQUALS BY STREETWORKS OR GE		
H2	120V/SP35	CURB TYPE IN ROADWAY LUMINAIRE. MOUNTED ON 25'-0" SQUARE STEEL POLE. WITH SINGLE 6'0" ARM. COLOR GRAY. MULTIPLEX BALAST. PHOTOCONTROL.	HUBBELL RMC-3-VIND-25S4B-3 WITH POD, ARM AND PHOTOCONTROL. OR EQUALS BY STREETWORKS OR GE		
	INCLUDED	EXIT SIGN, 120/277VAC 60Hz AND/OR DOUBLE DUAL LITE/UNIFORMS, LUMINEX TEST, SURGE PROTECTOR AND 6 REVERSING OUTLET LEADS AND SMALL INTERNAL ENERGY BACK-UP. SELF DIAGNOSTIC ELECTRONICS.	SURELITE SERIES E1-21		
	INCLUDED	INCANDESCENT COMPLETION AND MOUNTING PLATE, UL 324 AND NFPA-101. SELF DIAGNOSTIC ELECTRONICS.	EMERGENCY LIGHTED INSTRUMENTATION WITH UNIVERSAL 120/277 VAC		
	INCLUDED	HELIOS LED	TEST, SURGE PROTECTOR AND 6 REVERSING OUTLET LEADS AND SMALL INTERNAL ENERGY BACK-UP. SELF DIAGNOSTIC ELECTRONICS.		

SURFACE MOUNTED NEUTRAL PHASE, 120V/240V, 3 WIRE, 100% A/C		PANEL SCHEDULE LPA	
Ckt No./P/N	Description	Phase	Notes
1	OFFICE 10A BASEBOARD ELECTRIC HEATERS	A	
3	OFFICE 10A CUSTOMER ENTRY (105)	A	Mechanical Roda (105)
5	OFFICE 10A BASEBOARD ELECTRIC HEATERS	A	ELECTRONIC UNIT HEATER
7	OFFICE 10A BASEBOARD ELECTRIC HEATERS	B	
8	OFFICE 10A CUSTOMER ENTRY (106)	B	AIR COUPLED CONDENSING UNIT
9	OFFICE 10A BASEBOARD ELECTRIC HEATERS	B	HP-1
10	OFFICE 10A BASEBOARD ELECTRIC HEATERS	B	AIR HANDLING UNIT AND -1
12	UNBAL. TO E. (102)	B	REPLACEABLE FOR FUTURE HEAT TRACE
13	UNBAL. TO E. (102)	B	REPLACEABLE FOR FUTURE HEAT TRACE
15	POINT-OF-USE ELECTRIC WATER HEATER (W1-1)	B	EXISTING CRINGER PUMP
17	POINT-OF-USE ELECTRIC WATER HEATER (W1-1)	B	
19	20/1 EXTERIOR/MAIN WALL PLUGS	B	SPACE
21	20/1 SPARE	B	
23	20/1 SPARE	B	RE-FEED OF EXISTING SCALE HOUSE
25	20/1 SPARE	B	
27	20/1 SPARE	B	FEEDER TO DSU/A/PB
29	20/1 SPARE	B	

SURFACE MOUNTED NEUTRAL PHASE, 120V/240V, 3 WIRE, 100% A/C		PANEL SCHEDULE LPA	
Ckt No./P/N	Description	Phase	Notes
1	BARBER GATE DRIVE MOTOR & HUB	A	MAIN LUCAS ONLY
2	BARBER GATE DRIVE MOTOR & HUB	A	
3	BARBER GATE DRIVE MOTOR & HUB	A	
4	BARBER GATE DRIVE MOTOR & HUB	A	
5	BARBER GATE DRIVE MOTOR & HUB	A	
6	TVS RECEPABLE FOR COV RACK	A	
7	20/1 BARBER GATE DRIVE MOTOR & HUB	A	
9	20/1 EXTERIOR/MAIN WALL PLUGS	A	OFFICE 101, CUSTOMER ENTRY, ETC. (105)
11	20/1 OFFICE 10A CUSTOMER ENTRY (106)	A	PHONE JACK (105)
13	20/1 GATE MOUNT MACHINES	A	PHONE JACK (105)
15	20/1 GATE MOUNT MACHINES	A	PHONE JACK (105)
17	20/1 SCAFFOLDING RECEPABLES	A	
18	20/1 OFFICE 10A CUSTOMER ENTRY (106)	A	
19	20/1 SCAFFOLDING RECEPABLES	A	
			SPARE
			SPARE
			SPARE

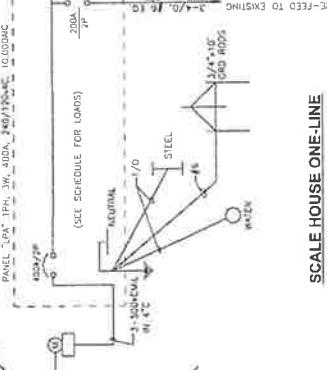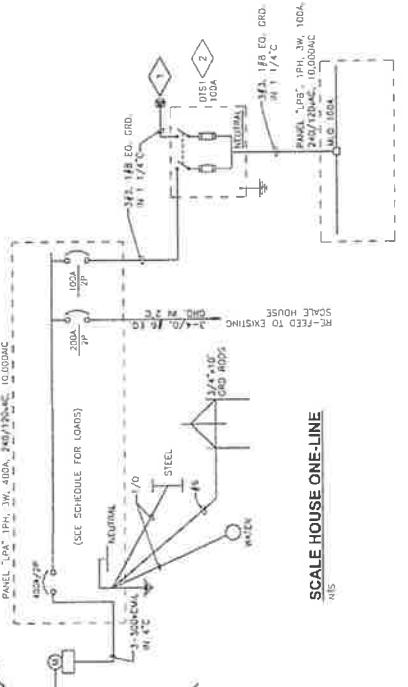

BLACK HAWK COUNTY WATER TOWER


EARTHTECH
ELECTRICAL SCHEDULES


DATE: JUNE 2006
PROJECT NO: 91451
FILE NO: E-C44HC
SHEET NO: E-04
DRAWING NO: E-04

EARTHTECH

MAIN BREAKER
400A
MAIN BUS
600A
GND. BUS

TRIP / P/T NO.

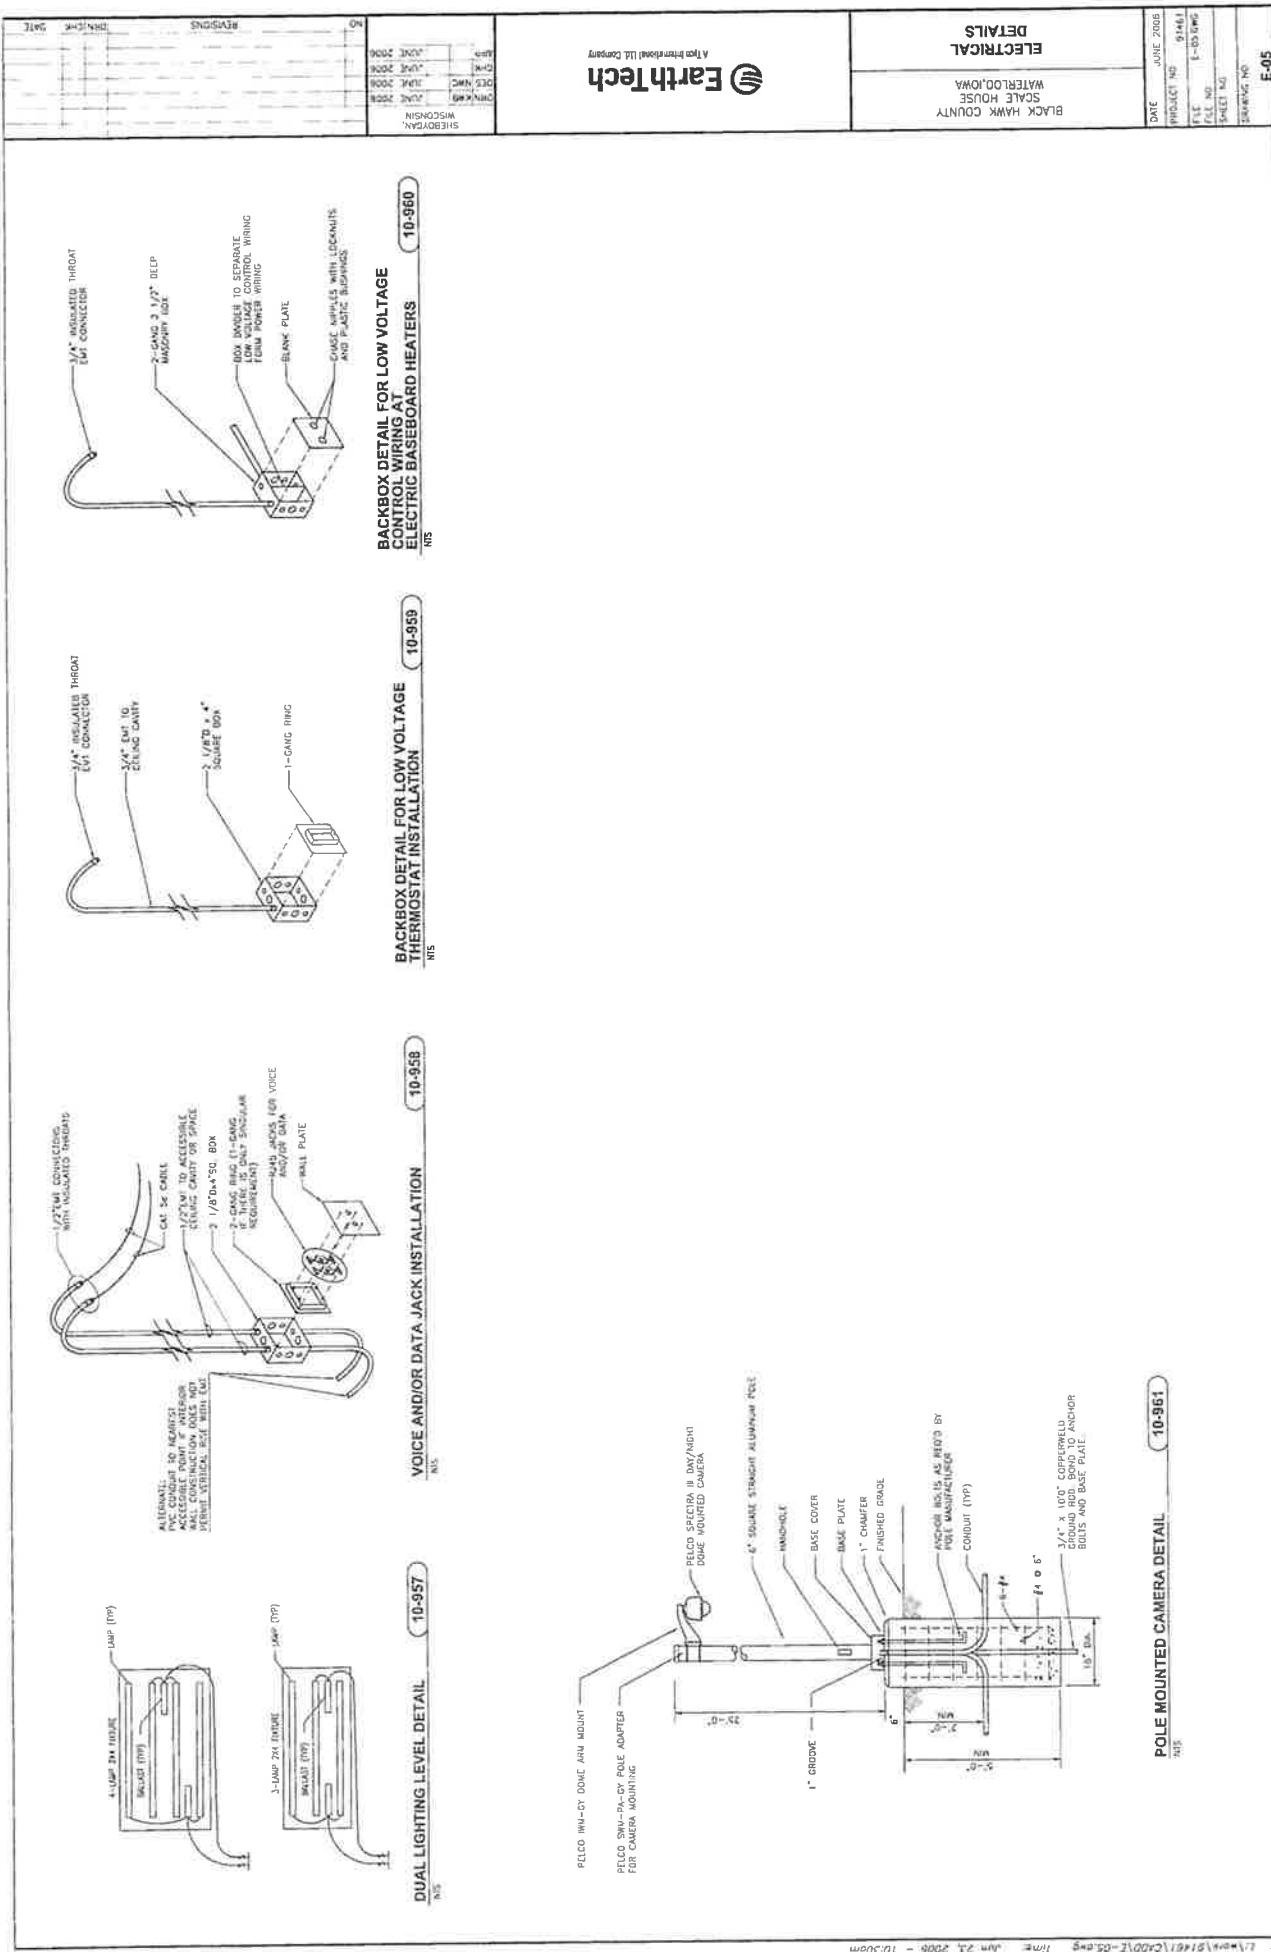

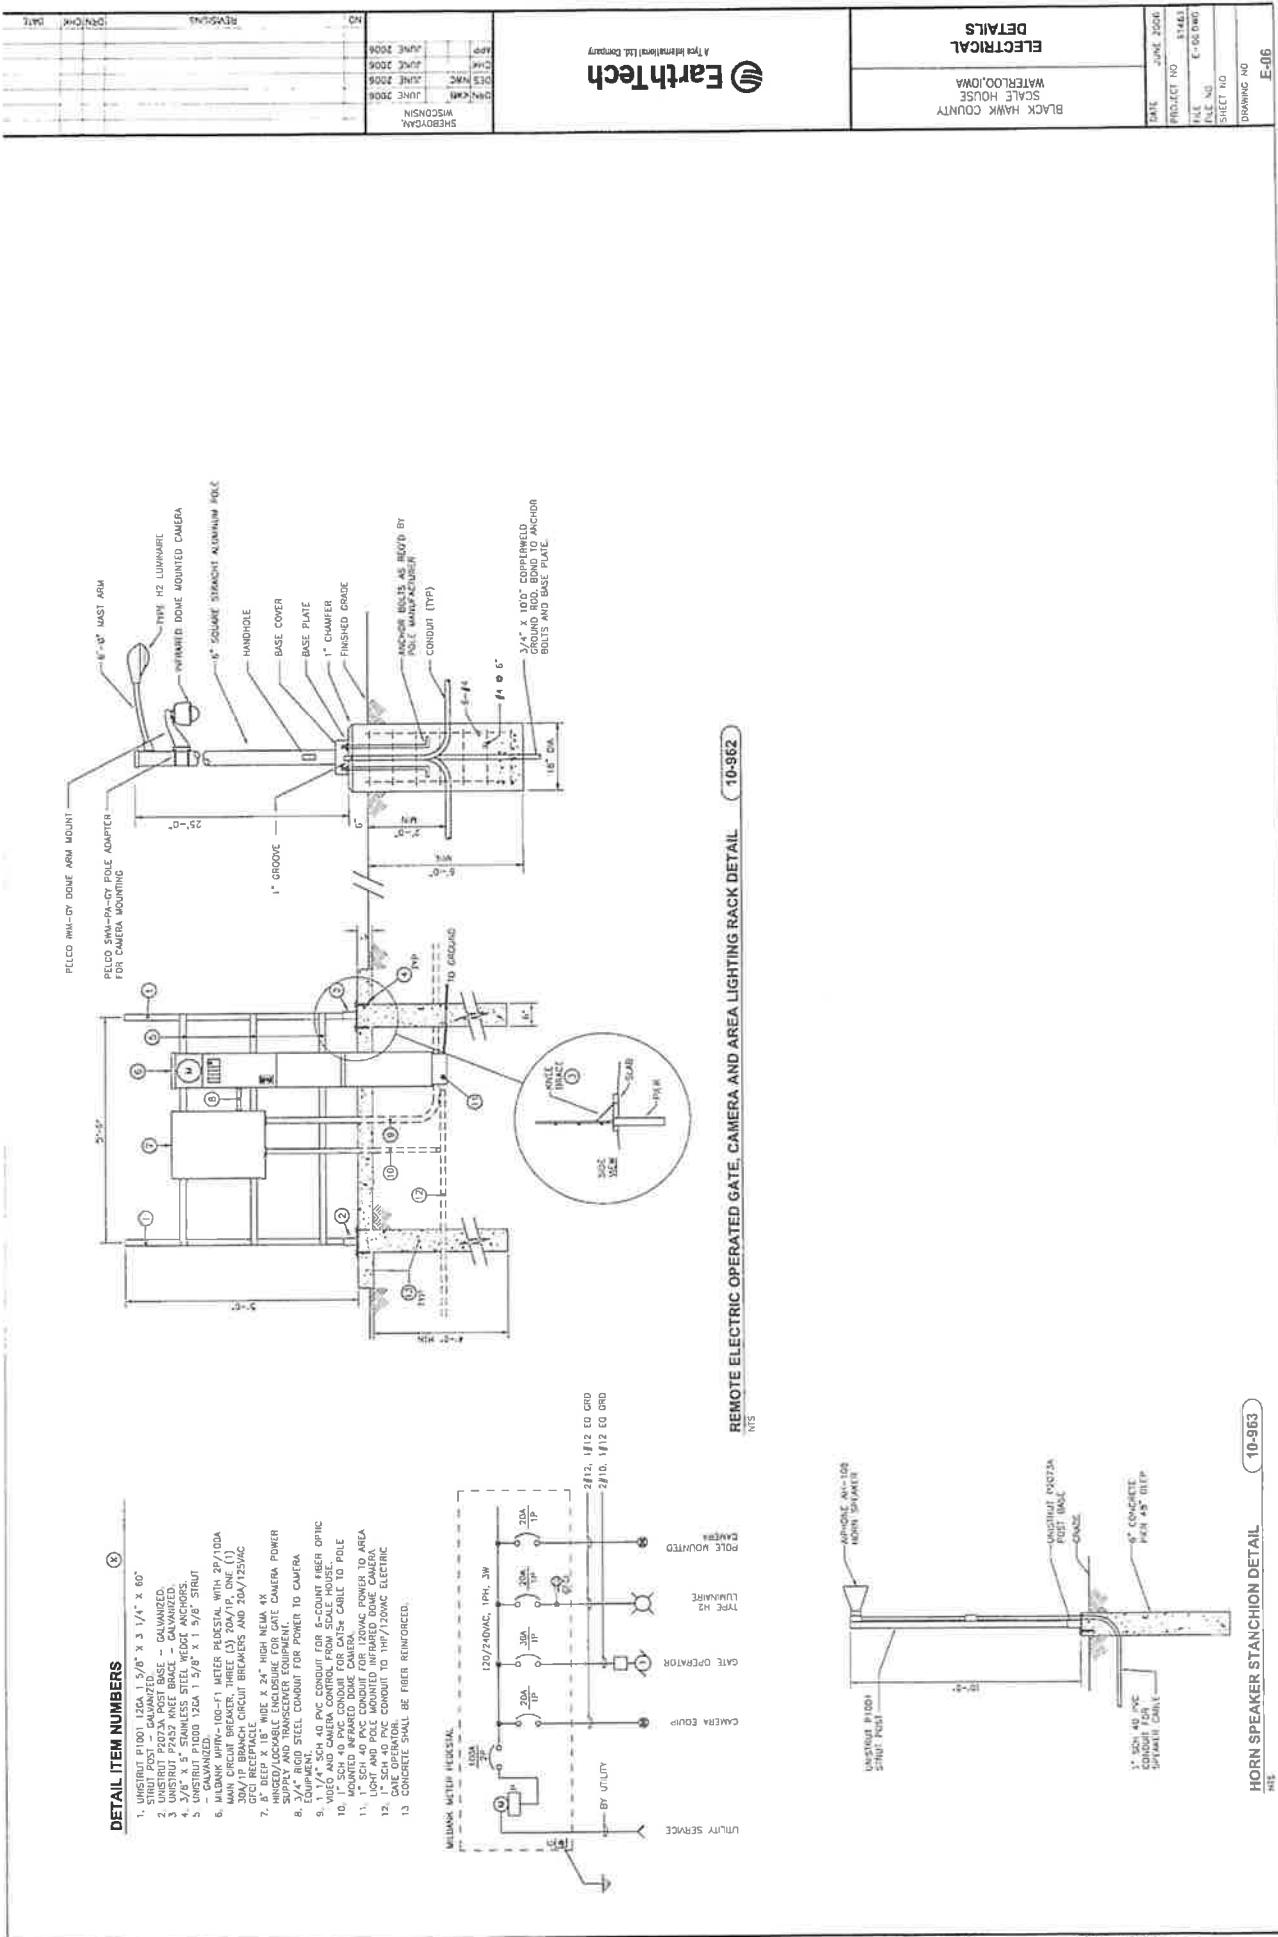


Plans for the construction of

SCALE AND SMALL LOADS FACILITY BLACK HAWK COUNTY SOLID WASTE COMMISSION

WATERLOO, IOWA

SYMBOLS LEGEND

Evergreen Tree	8	Fire Hydrant	8
Deciduous Tree	8	Luminaire	8
Fruit Tree	8	Traffic Signal	8
Shrub (Bushes)	8	Power Pole with Light	8
Tree	8	Electrical Highline Tower	8
Hedge	8	Hand Hole	8
Shrub	8	Electrical Pedestal	8
Shrub	8	Telephone Pedestal	8
Bird Nest Fence	8	Telephone Pole	8
Chain Link Fence	8	Telephone Pole	8
Existing Under Line	8	Telegraph Pole	8
Existing Sanitary Sewer Line	8	Satellite TV Dish	8
Existing Telephone Line	8	Telephone Booth	8
Existing Fiber Optic Telephone Line	8	Hand Post	8
Existing Storm Sewer Line	8	Gate Post	8
Existing Gas Line	8	Guaranteed Water Control	8
Existing Power Line	8	AV	8
Cable Television Line	8	IV	8
Railroad	8	Water Valve	8
Railroad	8	High Pressure Piping	8
Railroad Signal	8	Sign	8
Railroad Signal	8	Right of Way Rail	8
Railroad Box	8	Concrete Monument	8
Station Corner	8	Mail	8
Demarcation Line	8	Barometric Intake	8
Demarcation Line	8	Existing Intake	8
Dike	8	Proposed Intake	8
Terrace	8	Existing Monolith	8
Earth Dike or Dike (Existing)	8	Proposed Monolith	8
Earth Dike or Dike (Proposed)	8	Root Drain	8
Tile Outlet	8	OPP	8
Edge of Water	8	Day Valve	8
Existing Drivage	8	OPV	8
Proposed Drivage	8	Day Valve	8

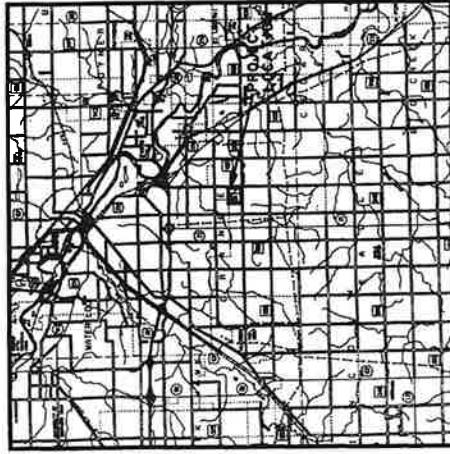

REVISED TO CONFORM TO
CONSTRUCTION RECORDS
PROVIDED BY CONTRACTOR.

8/11/04
RUST Environment & Infrastructure

INDEX OF SHEETS	
NO.	DESCRIPTIONS
1	TITLE SHEET, LOCATION MAP, INDEX OF DRAWINGS
2	FACILITIES PLAN, GENERAL NOTES AND QUANTITIES
3	GRADE PLAN - ENTREPRENEURIAL
4	GRADING PLAN - SMALL LOADS
5	SCALE AND SCALE DETAILS
6	ALTERNATE SCALE HOUSE
7	ALTERNATE SCALE HOUSE
8	ELECTRICAL DETAILS
9	MISCELLANEOUS DETAILS
10	PIPE MAIN AND DETAILS



Con 12-1-1

Doc # 8267

PLANS FOR THE INDICATIONS	
TO THE STATE OF IOWA RE: Scale and Small Loads Facility IOWA DEPARTMENT OF NATURAL RESOURCES ENVIRONMENTAL PROTECTION DIVISION 1117 LOCUST STREET WATERLOO, IOWA	
Planner:	Reed J. Bell
Supervisor:	Reed J. Bell
Date:	8/11/04
Regulation:	8/11/04
Comments:	None

Sheet 1 of 1


RUST ENVIRONMENT & INFRASTRUCTURE

PROJECT NUMBER	8267	DATE	8/11/04
NAME	Reed J. Bell	REG. NO.	8267
PHONE	(515) 232-2277	MAILING ADDRESS	1117 Locust Street Waterloo, IA 50701
EMAIL	rbell@rustenv.com	FILE NUMBER	8267

Sheet 1 of 1

by registration record date 8/11/2004


This drawing, sheet 1 of 1 provided by the Engineer, shall be the original and the copies shall be deemed to be the same in all respects.

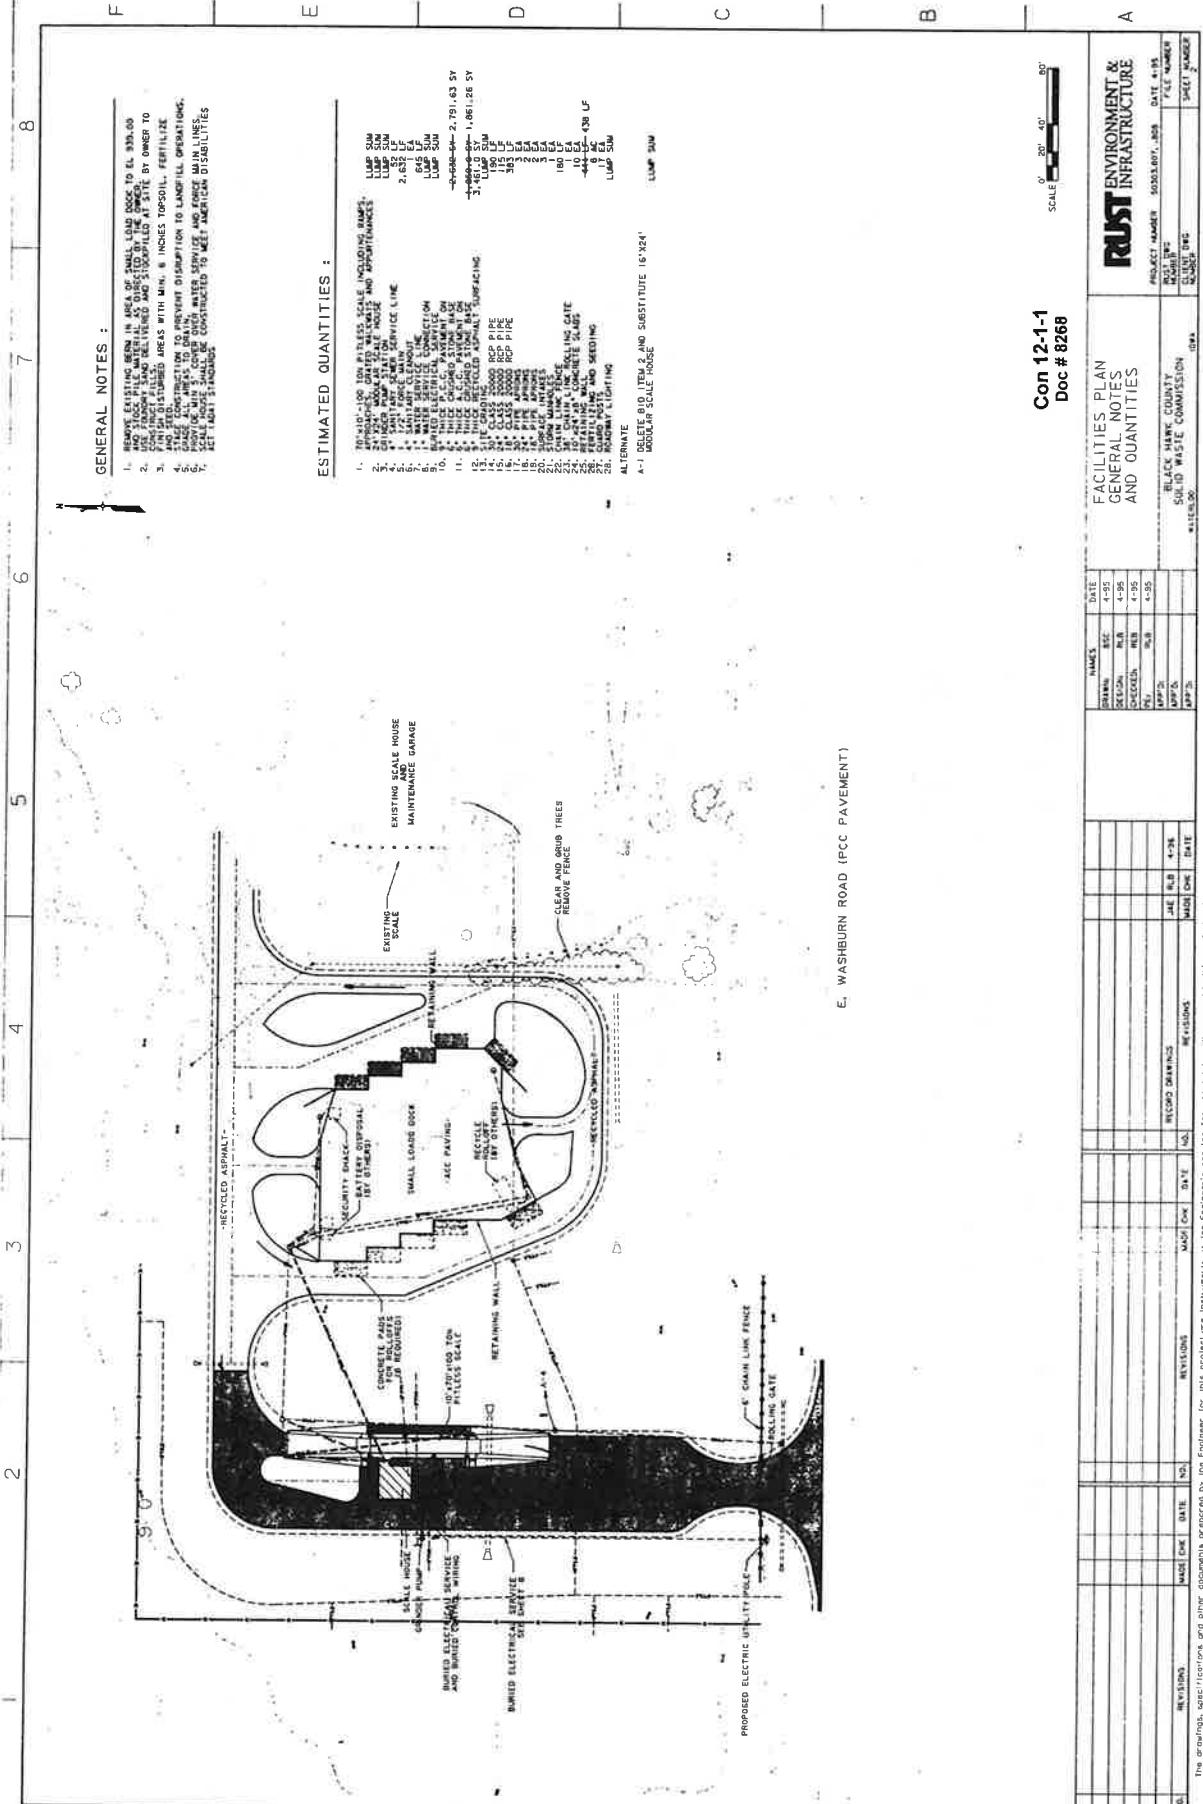


Con 12-1-1
Doc # 8268

ENVIRONMENT & INFRASTRUCTURE		
FACILITIES PLAN		
GENERAL NOTES AND QUANTITIES		
NAME'S	DATE	
DRAWN BY:	4-95	
DESIGN:	MLR	
CHECKED:	MLR	
PLT:	4-95	
APPR'D:	MLR	
APPROVED:	MLR	
SUPERVISOR:	MLR	
MANAGER:	MLR	
GENERAL COMMISSION:	MLR	
WEATHER:	MLR	
DATE:	4-95	
TIME:	4-95	
WEEK:	4-95	
YEAR:	4-95	
SUPERVISOR SIGNATURE:	MLR	
GENERAL COMMISSION SIGNATURE:	MLR	
RECEIVED : THIS APR 25 1995 BY	4-95	
PRINT : 50303405/5030405/REC'D DATE : APR 25 1995	4-95	
FILE : 50303405/5030405/REC'D DATE : APR 25 1995	4-95	

The engineer, contractor, and other interests preparing or participating in this project or in any way related to it, shall be bound by the terms and conditions of the contract, specification and general conditions of the Engineer's service and shall be liable for all damages resulting from their failure to observe and perform the same, notwithstanding any provision to the contrary.

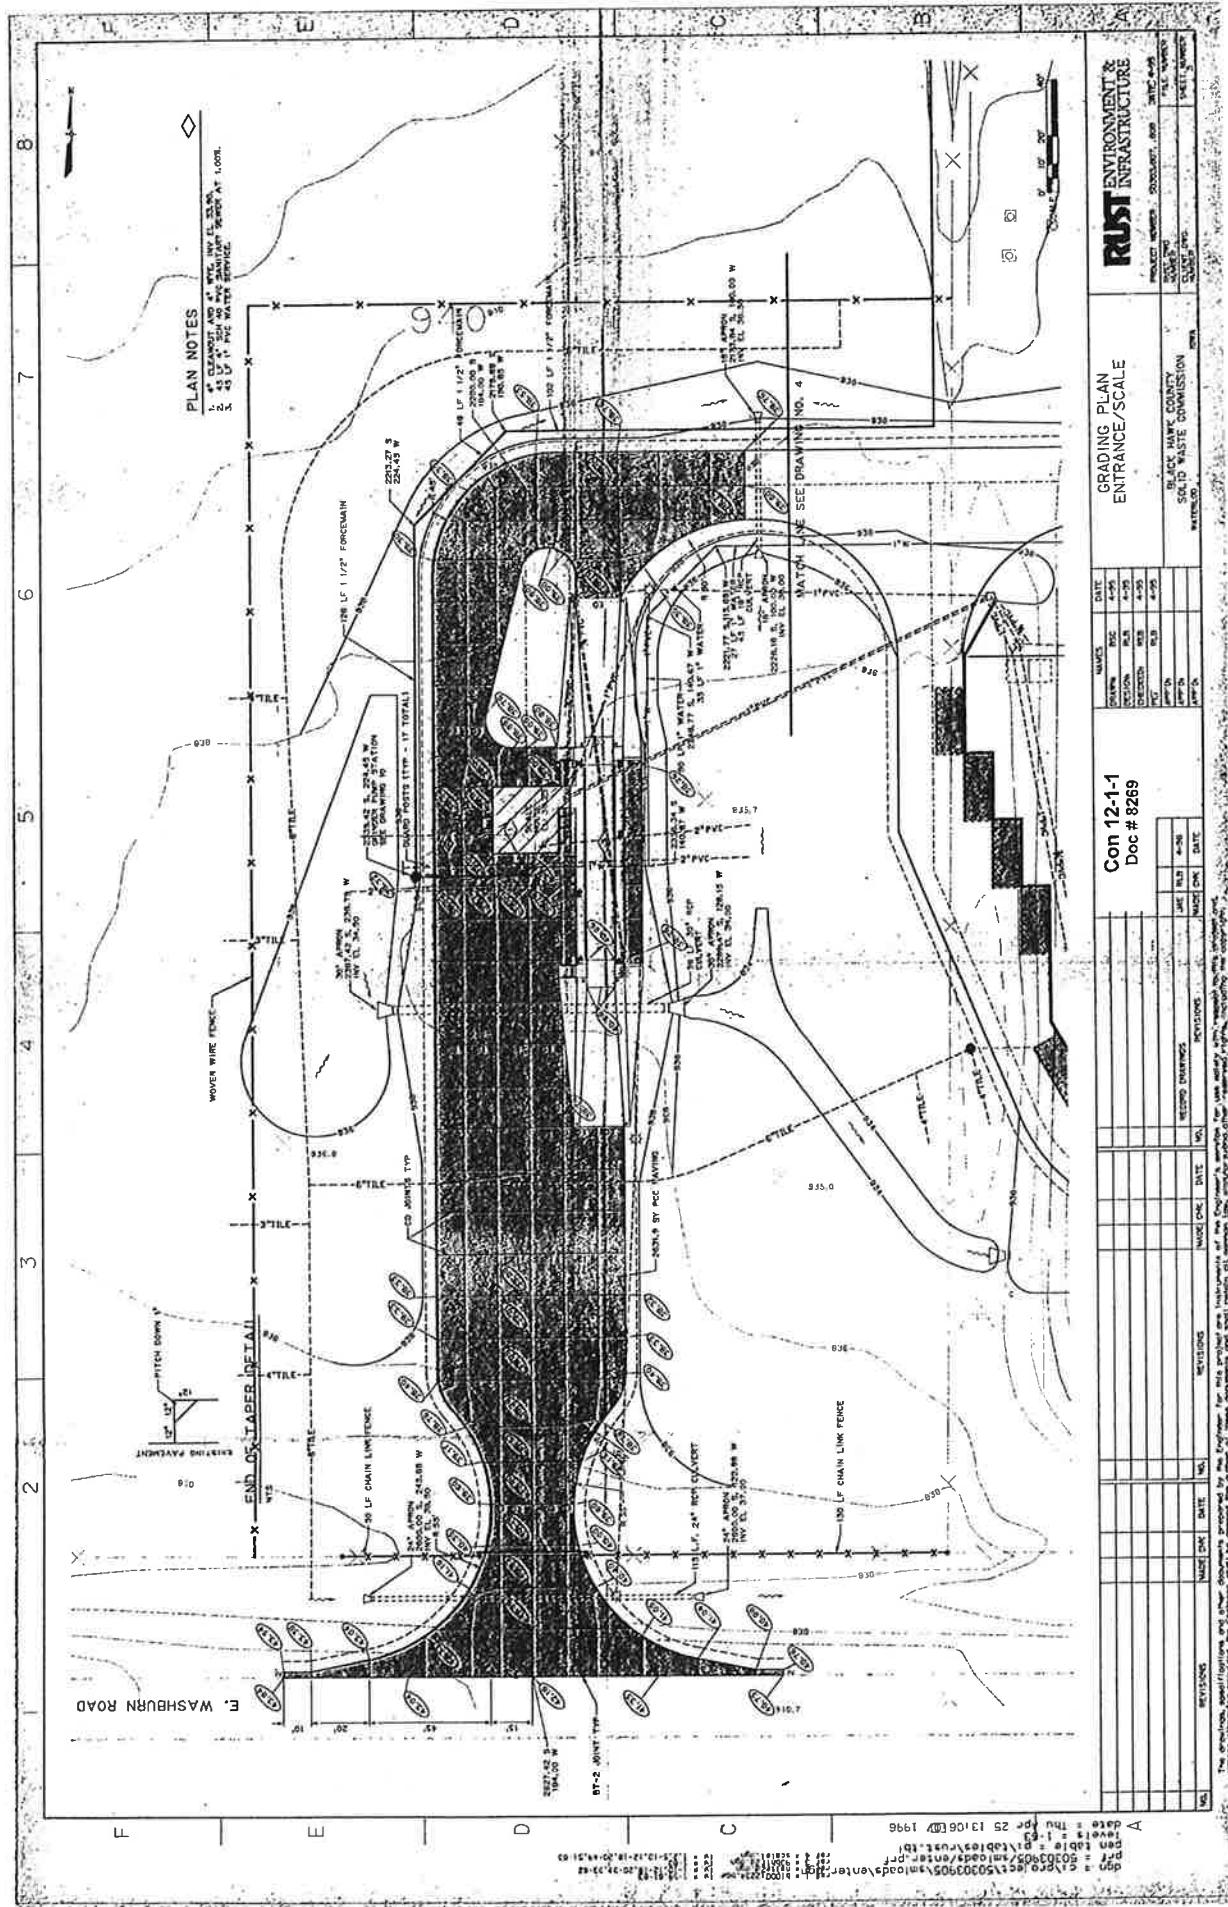


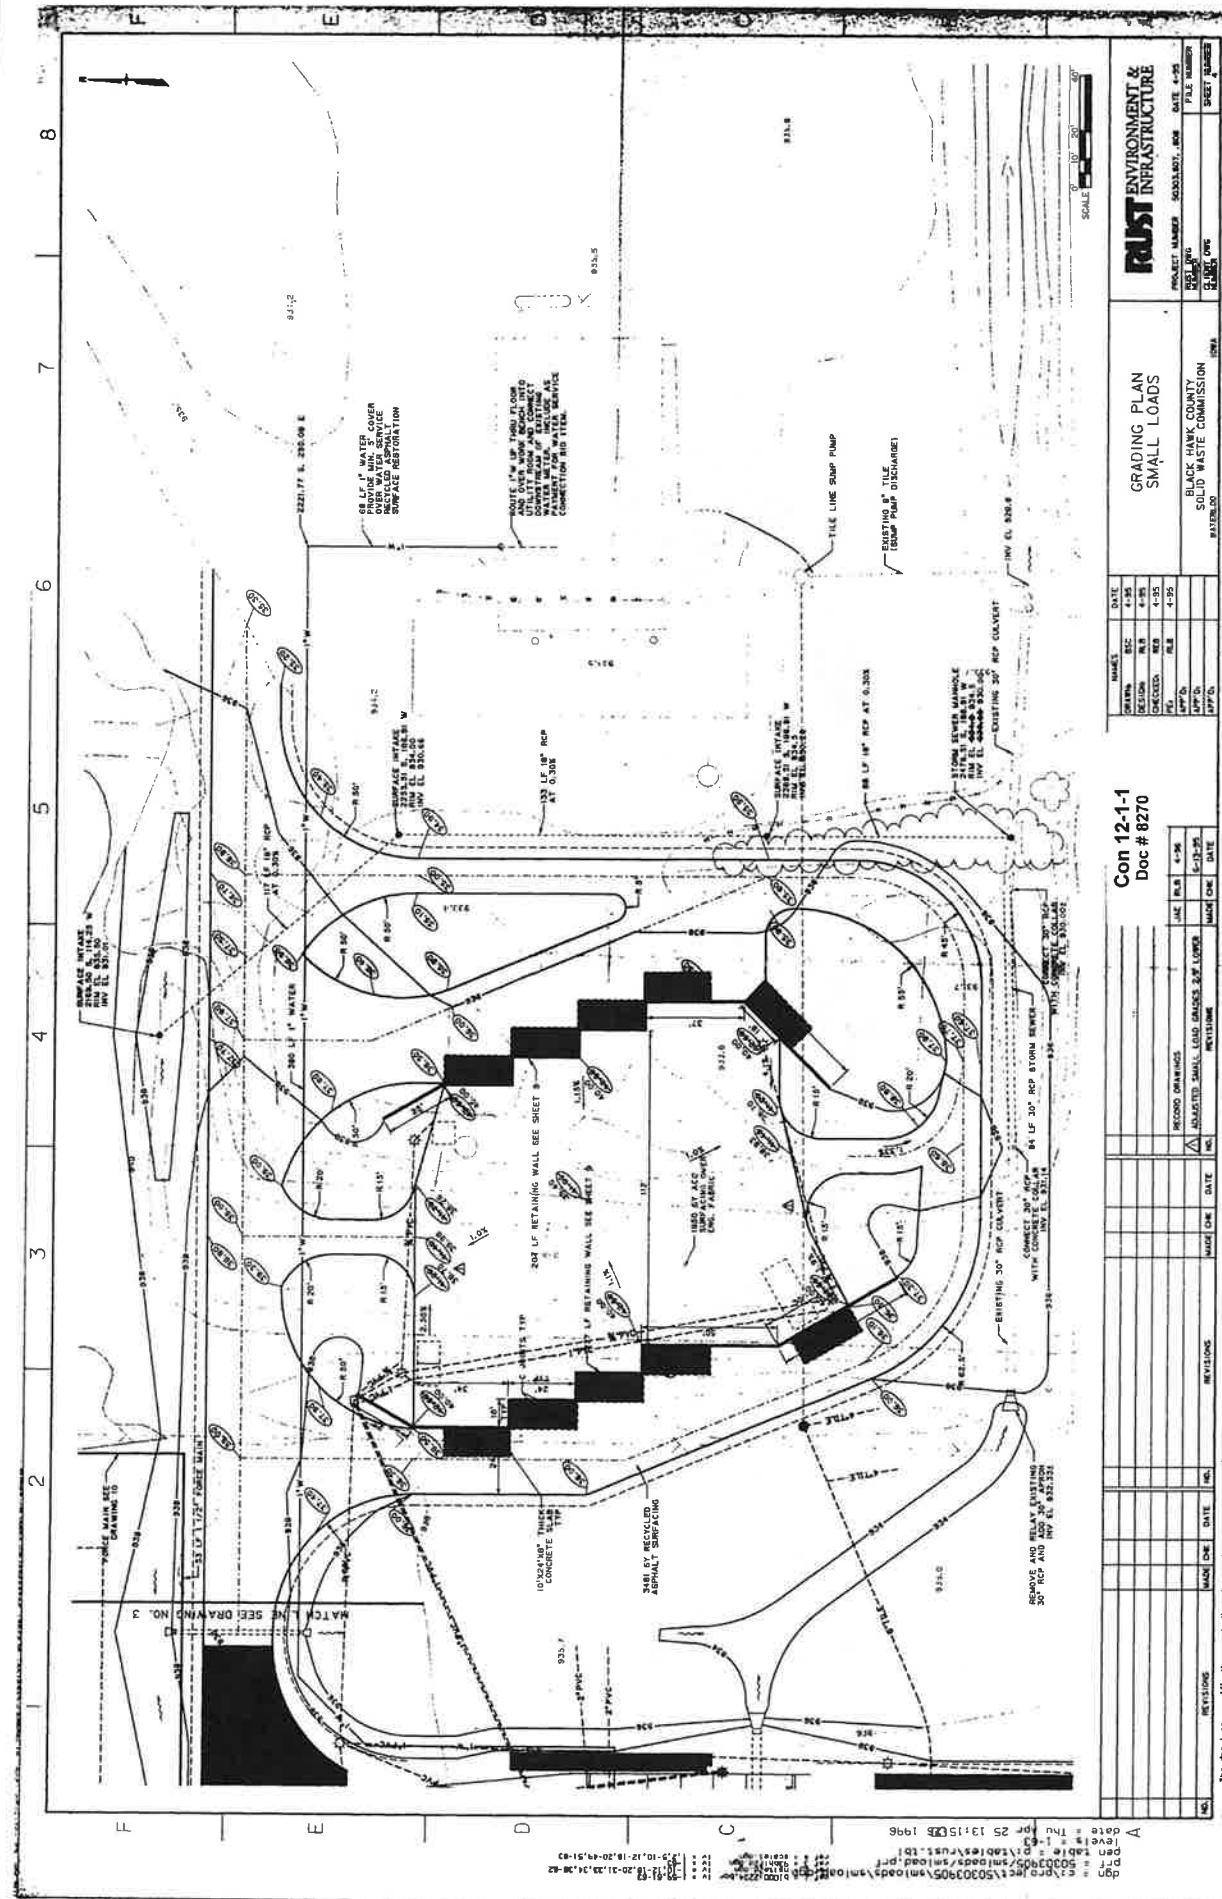

Con 12-1-1
Doc # 02270

PROJECT NUMBER		GRADE LINE		DATE		GRADING PLAN		SOLID LOADS	
GRADE	SC-1	BLK	BLK	4-95					
SECTION	BLK	BLK	BLK	4-95					
CHECKED	BLK	BLK	BLK	4-95					
PLATE	BLK	BLK	BLK	4-95					
APPROVED	BLK	BLK	BLK	4-95					
REVIEWED	BLK	BLK	BLK	4-95					
BLK HAWK COUNTY									
SOLID WASTE COMMISSION									
WATER CO.									

The drawing, sheet number and other documents prepared by the engineer for the project or this portion of the project and the drawings and other documents shall be retained by the engineer for a period of one year from the date of issuance of the final certificate of completion and the drawings and other documents shall be returned to the engineer upon request.

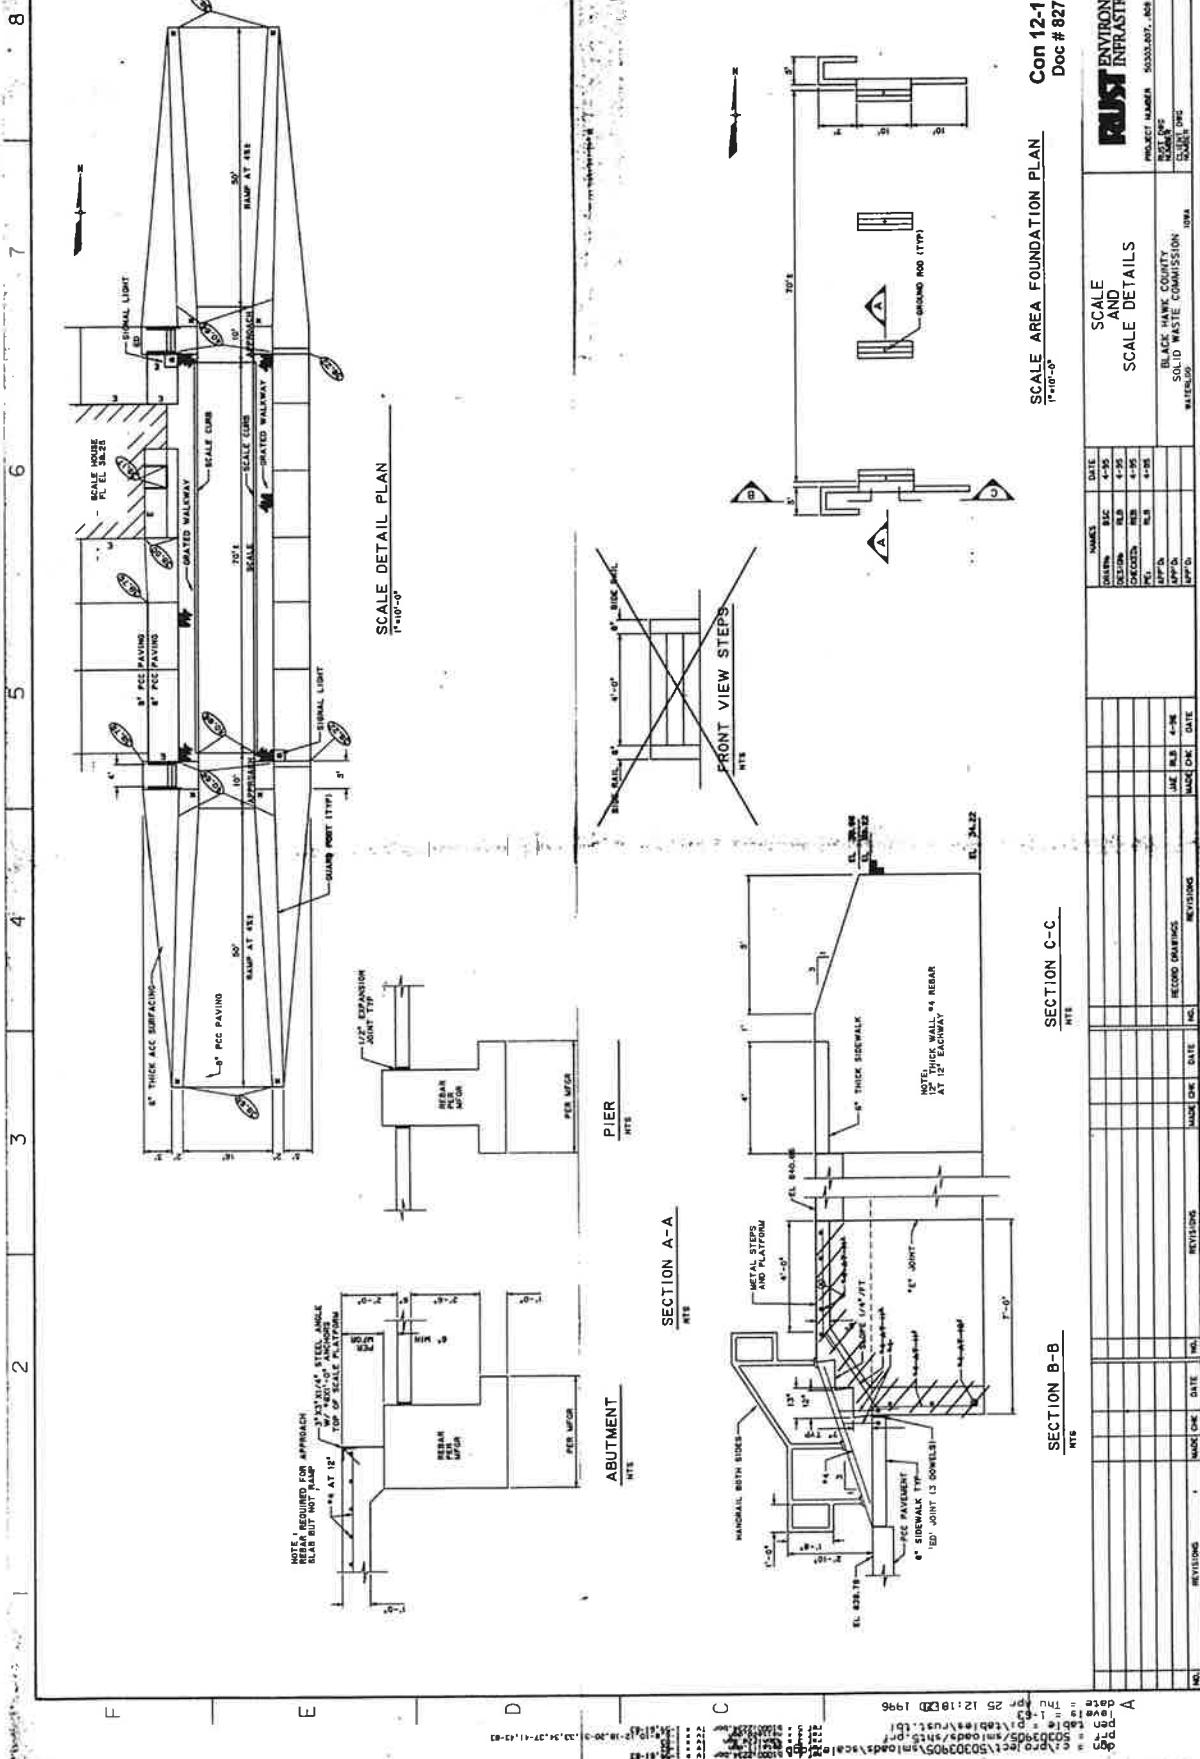

8

FLOOR PLAN

SECTION A-A' DOOR DETAIL SEE DETAIL CH-322

WATER SERVICE PLAN

NOTE: LINE 1/2" COPPER ONE END DIFFERENTIATE SHOTW

WATER PLUMBING PLAN

WATER PLUMBING PLAN

DOOR SCHEDULE

DOOR NUMBER	SIZE W X H	TYPE	MATERIAL	FRAME	SWING	OPENING	MATERIAL
101	3'-0" x 7'-0"	D-2	STL-1	-	F-1	STL	1
102	3'-0" x 7'-0"	D-2	STL-1	-	F-1	STL	2
103	2'-0" x 3'-0"	D-3	STL-1	-	F-1	STL	3
104	2'-0" x 3'-0"	D-4	STL-1	-	F-1	STL	2
105	3'-0" x 7'-0"	D-4	STL-1	-	F-1	STL	2
106	3'-0" x 7'-0"	D-4	STL-1	-	F-1	STL	3
107	3'-0" x 7'-0"	D-4	STL-1	-	F-1	STL	3

WASTE PLUMBING PLAN

LAVATORY DETAIL ELEVATION

PLAN NOTES

1. CONNECT LIGHTS FOR TWO LEVEL SWITCHING.
2. 25A, 3 FUSE, SIZE IN ACCORDANCE WITH APPROVED SHOP DRAWINGS.

ELECTRICAL FLOOR PLAN

GENERAL NOTES

HARDWARE GROUP #1: 1/2" PLAIN NICKEL PLATED CAP FOR EXTERIOR DOORS
HARDWARE GROUP #2: 1/2" PLAIN NICKEL PLATED CAP FOR EXTERIOR DOORS OR 1/2" PLAIN NICKEL PLATED CAP FOR INTERIOR DOORS

HARDWARE NOTES

HARDWARE GROUP #1: 1/2" PLAIN NICKEL PLATED CORROSION RESISTANT LOCKSET
HARDWARE GROUP #2: 1/2" PLAIN NICKEL PLATED SWING CHECK, TRENCHLESS
HARDWARE GROUP #3: 1/2" PLAIN NICKEL PLATED SWING CHECK, TRENCHLESS

SCALE HOUSE

WATER SERVICE PLAN

WASTE PLUMBING PLAN


SOLID WASTE COMMISSION

CONTRACTOR'S SIGNATURE


RUST ENVIRONMENT & INFRASTRUCTURE


Doc # 8272


Con 12-1-1

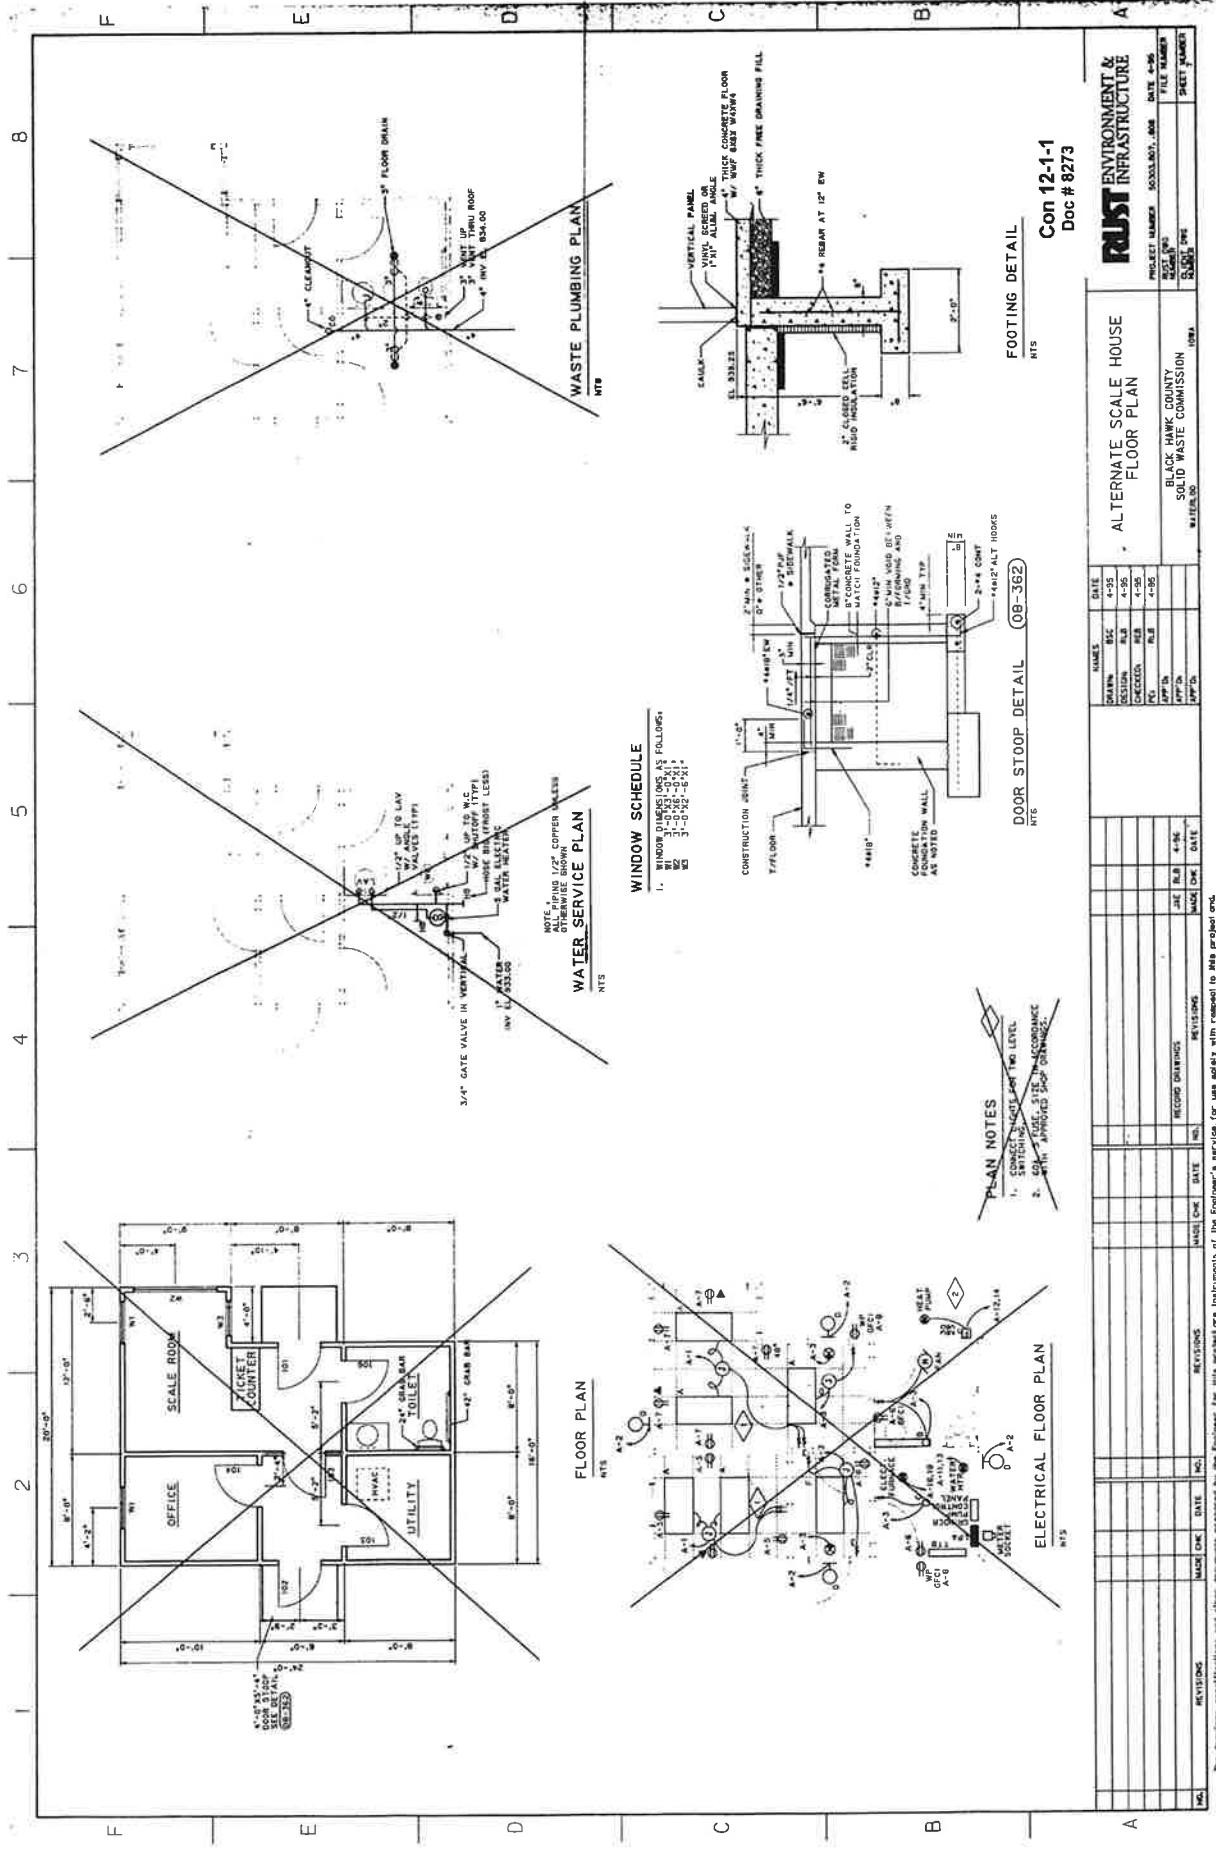

This drawing contains information and shall be the property of the Engineer for his office or firm or its assignee and shall be returned to the Engineer for his office or firm or its assignee, or used solely for the purpose for which it was furnished, and shall not be copied, reproduced, or otherwise transmitted without the written consent of the Engineer.

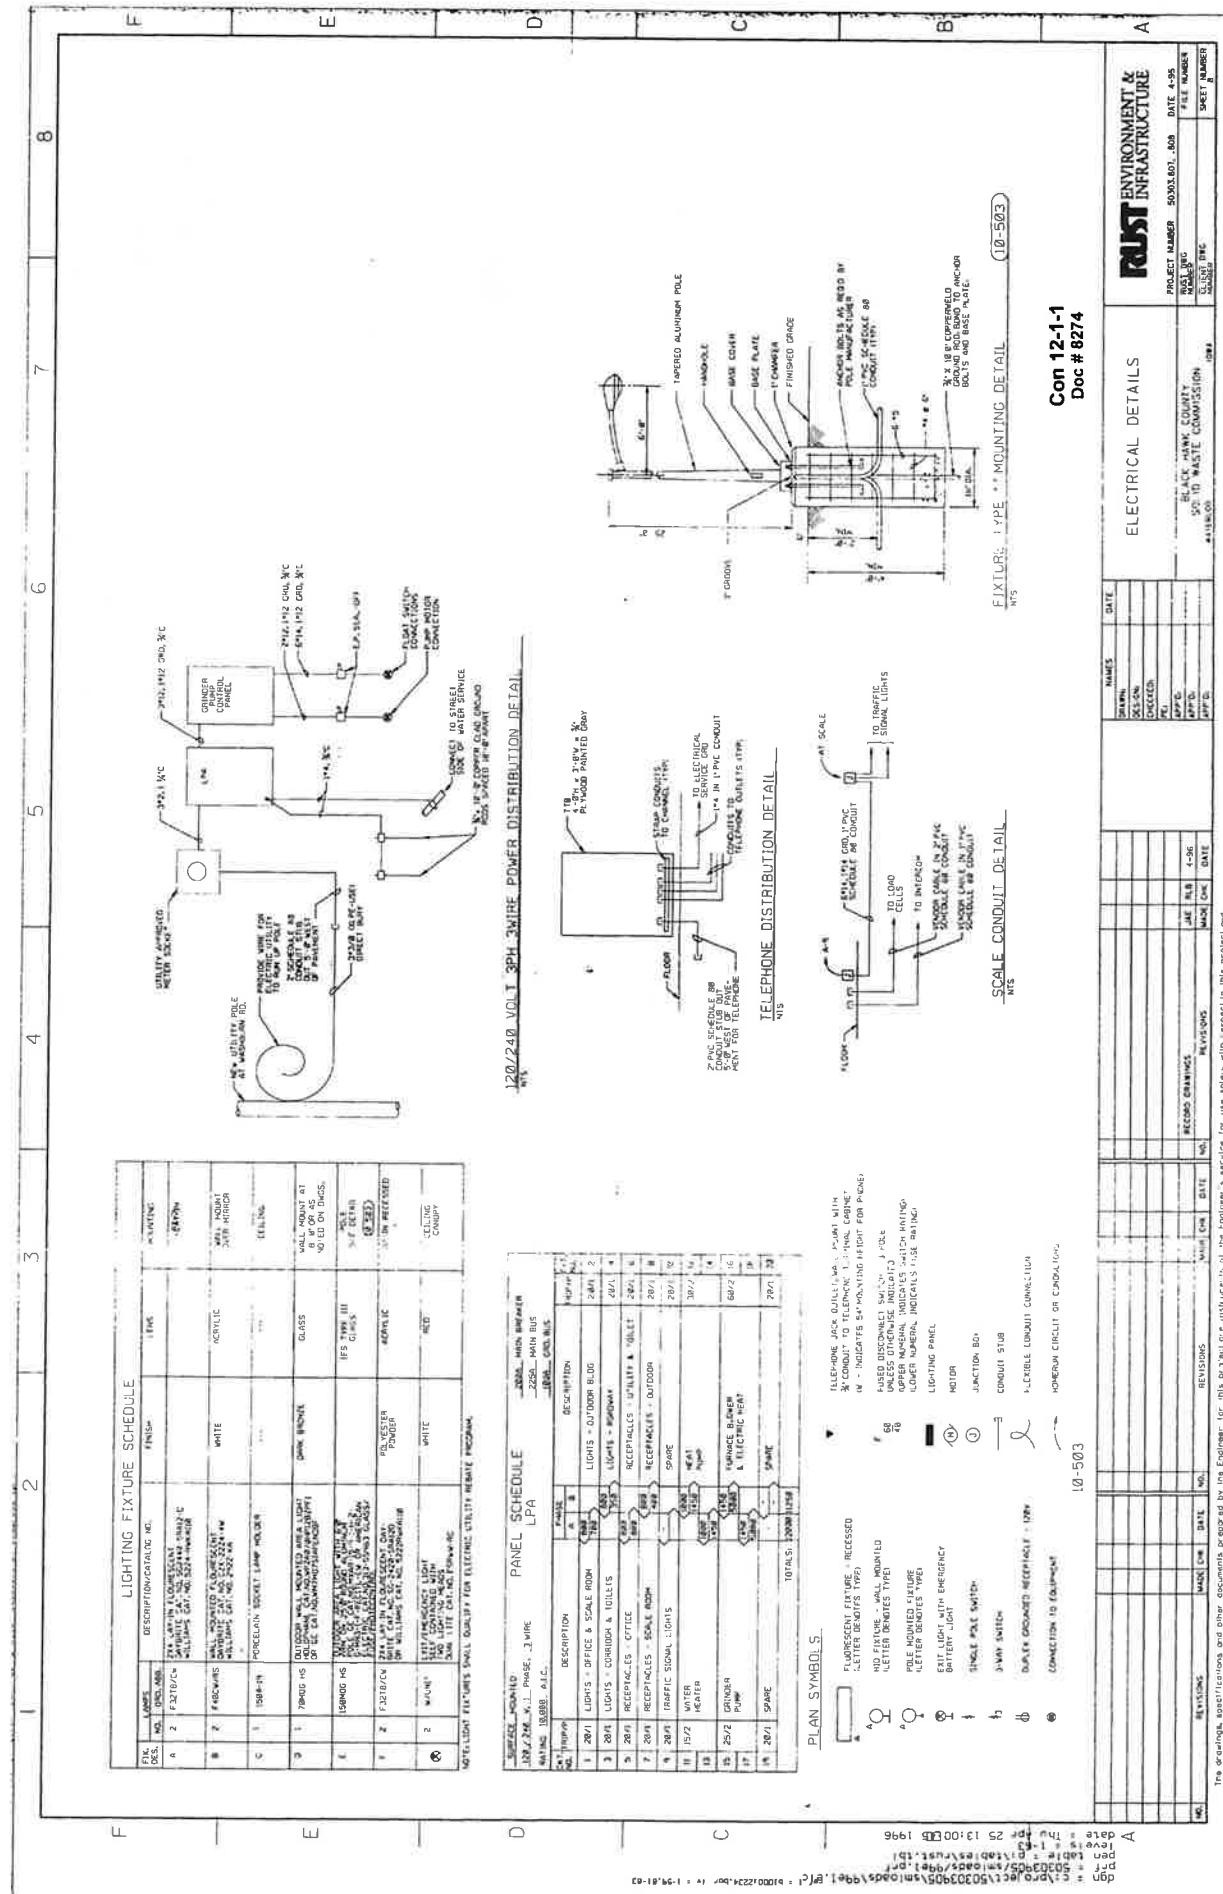

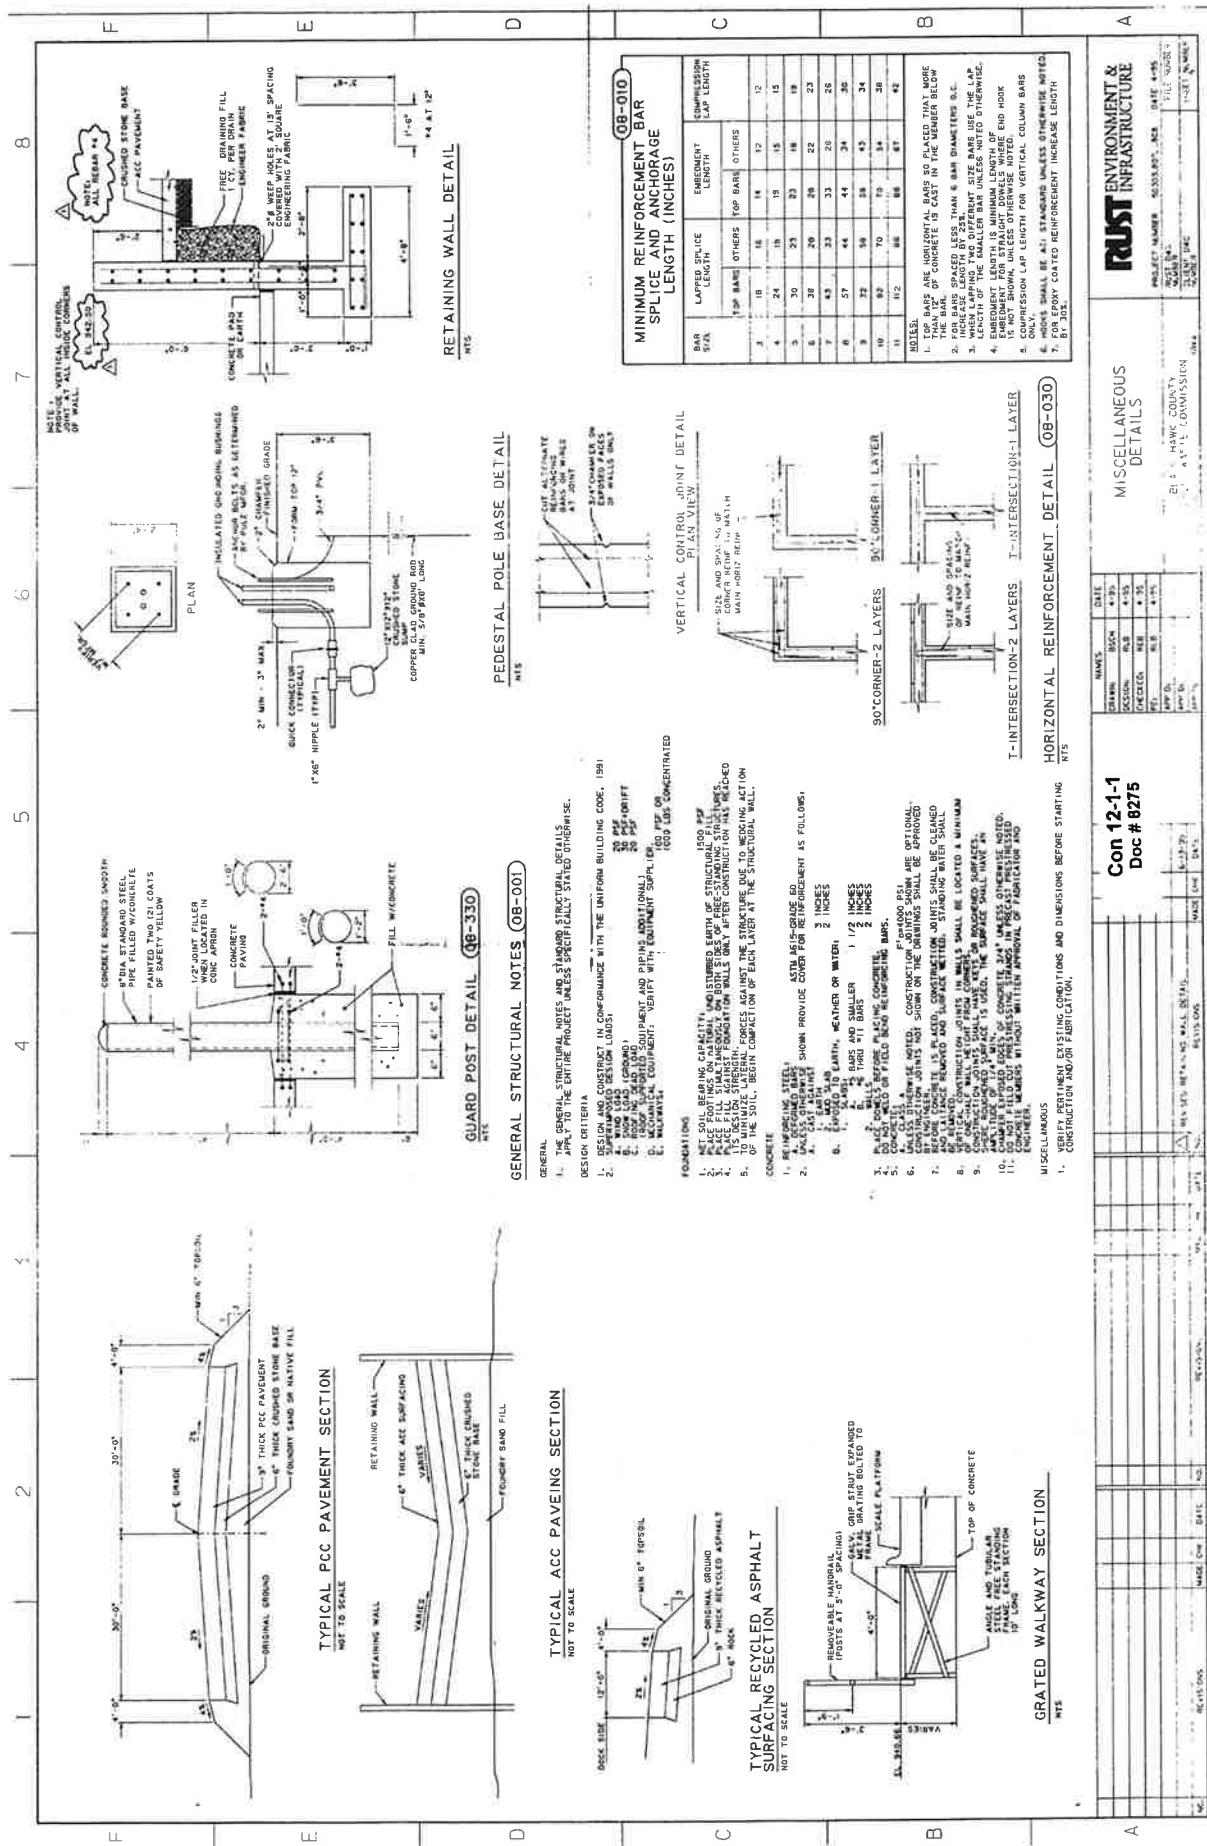

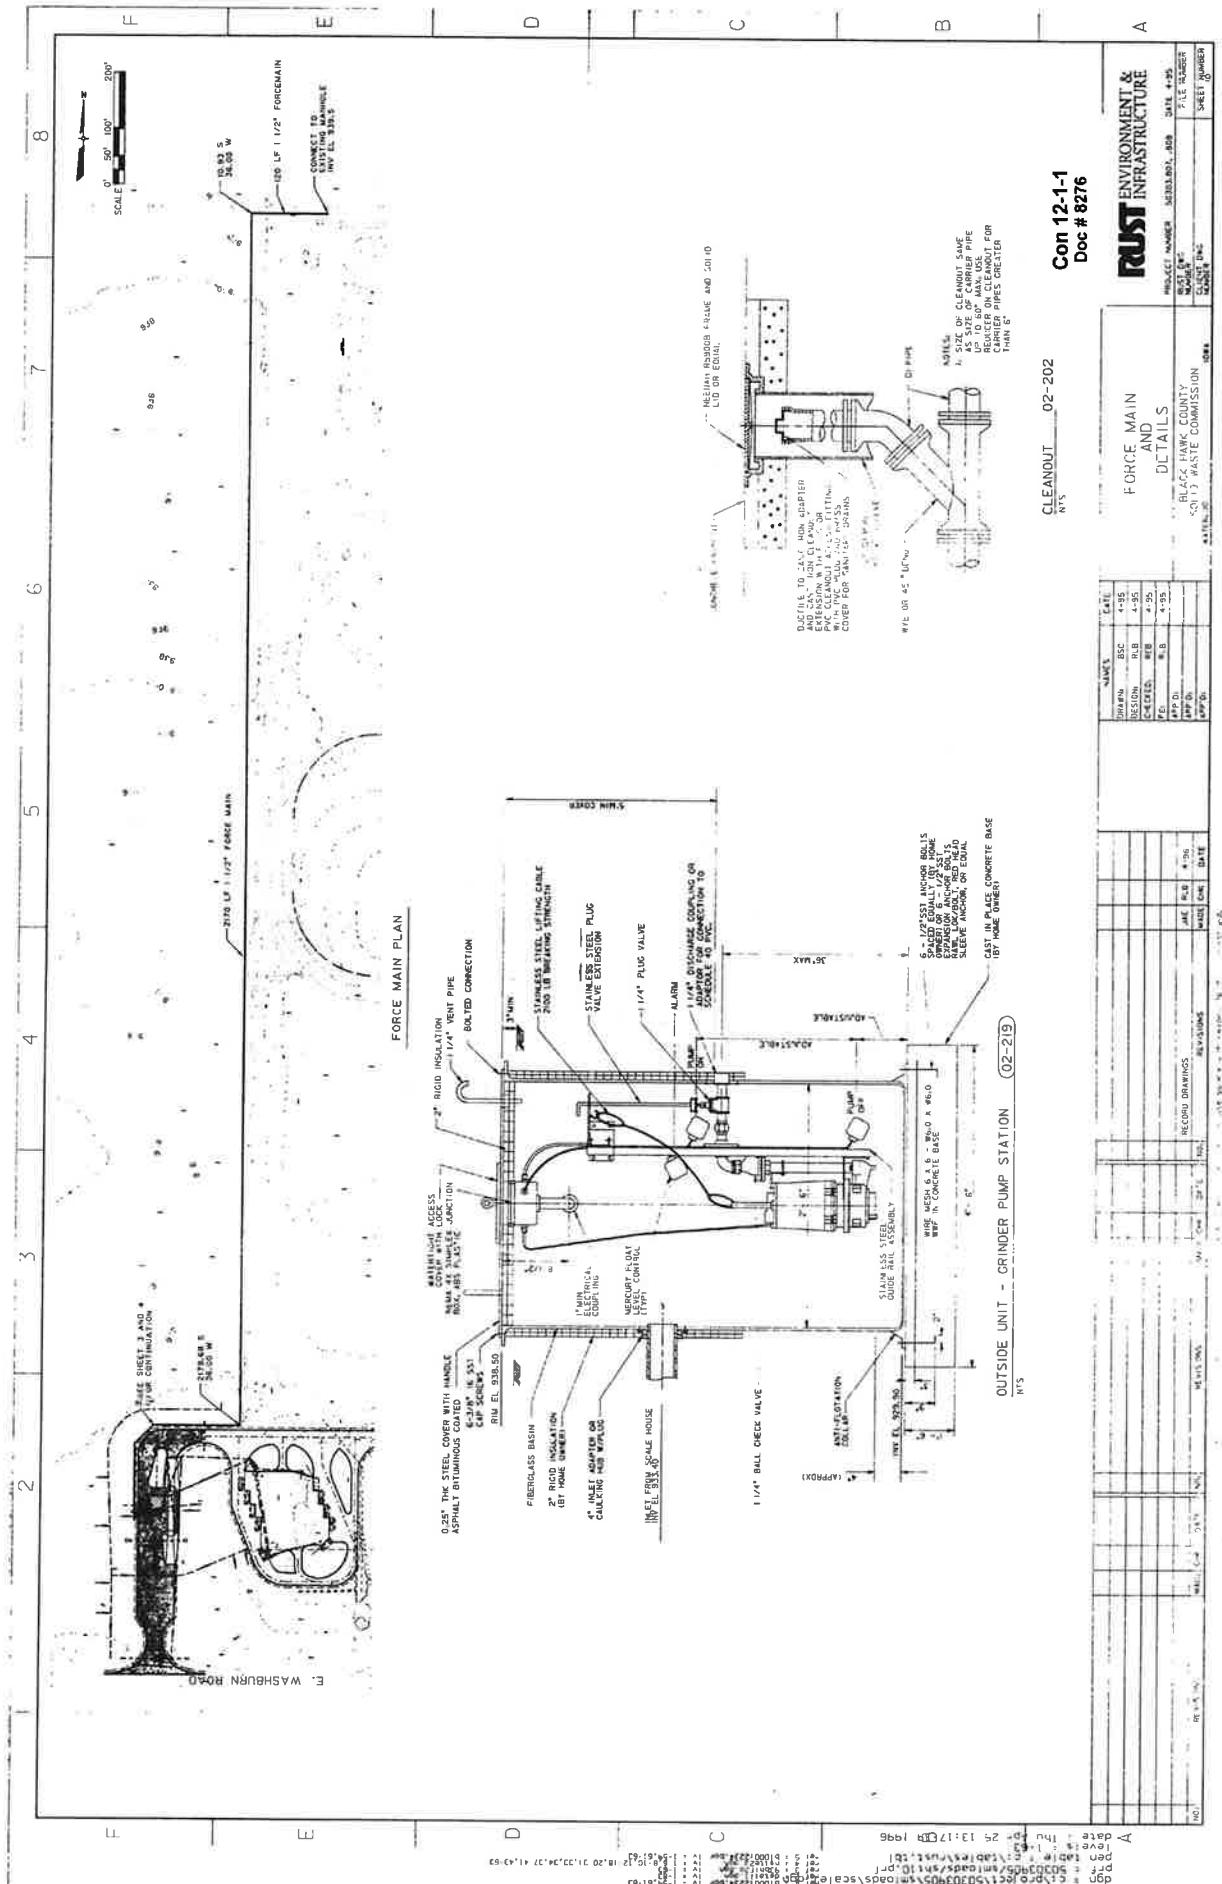

Attachment B
Vehicle Scale Specifications

PART 1 GENERAL

1.01 SUMMARY. This Section Includes Submittals, Quality Assurance, Manufacturer's Scale weighbridge, Scale instrumentation, electronic load cells, scale instrumentation function and accessories, Coating, Preparation, Scale Installation, Instrumentation Installation, Field Quality Control, Lightning Protection Specifications, and Warranty Requirements.

1.02 SUBMITTALS

- A. Shop drawings, specifications, catalog data, and literature.
 - 1. Manufacturer's detailed construction drawings of scale, including but not limited to:
 - a. Model number, capacity, and size of scale.
 - b. Material specifications are for materials used in the foundation and weighbridge.
 - 2. Scale foundation drawings to include:
 - a. Type and strength of concrete.
 - b. Reinforcing grade, size, and arrangement.
 - c. Dimensions of walls, floors, anchor bolt locations, and cast-in-steel requirements.
 - 3. Instrumentation:
 - a. Wiring diagrams and locations.
 - b. Catalog cut or specifications for instrumentation
- B. Operations and Maintenance Data (O&M). Provide operations & maintenance instructions and parts list.

1.03 QUALITY ASSURANCE. Scale installation and foundation construction shall comply with or exceed requirements of Iowa Code 215, Implemented by Iowa Administrative Code Chapter 85.

PART 2 PRODUCTS

2.01 MANUFACTURERS: Cardinal Scale Company, Mettler – Toledo, B-tek, Rice Lake, or equal.

2.02 SCALE WEIGHBRIDGE – State of Iowa Legal for Trade Scale for Commercial Vehicles current maximum weight of 80,000 lbs. With a 70-ft long, 14-ft wide concrete platform.

2.03 SCALE INSTRUMENTATION INTERFACE

- A. CONTRACTOR shall integrate OWNERS WasteWORKS system to the new scale.
 - 1. WasteWORKS requires continuous output from the scale indicators.
 - 2. WasteWORKS has an NTEP Certificate #94-055.
 - 3. WasteWORKS trap for the motion character that indicators send and will not allow weight to be accepted while the scale is in motion.
 - 4. CONTRACTOR shall provide a data cable from the scale indicator. RS232 cable with DB9 female connection. The port shall be in continuous output mode and shall include gross weight, carriage return, and line feed. The CONTRACTOR shall provide the ports baud, parity, data bits, and stop bits.
- B. Electronic Load Cell:
 - 1. Each load cell shall have a minimum capacity of 22.5 metric tons (50,000 pounds).
 - 2. The scale shall have a COC with NTEP Approval, and Load cells shall be certified by NTEP and meet the specifications as set forth by NIST H-44 for Class IIIIL devices. The manufacturer shall provide a Certificate of Conformance to these standards upon request.
- C. Scale Instrumentation Function and Accessories:
 - 1. Recording capacity equal to scale capacity and readout in 20 lb gradations.
 - 2. Indicating Numerals: LED display with minimum of 5/8 in. high.
 - 3. The front panel features Metric conversion, print command, motion, center of zero, overcapacity indicators, gross, tare, and net indicators, a gross or tare weight input keyboard, and automatic zero.
 - 4. Capable of calculating net weights automatically.

- 5. Completely shielded from radio interference.
 - 6. Table mounted.
 - 7. Interface with ticket printer.
- 2.04 COATING. The weighbridge shall be shot blasted to a minimum SSPC-SP6 specification before painting. All exterior surfaces of the scale shall have a two-part epoxy finish, providing a total Dry Film Thickness of 5-7 mils. The finish shall be force-cured to reduce the risk of contamination and ensure the durability of the surface Structural Steel Primer with the color as selected by OWNER.
- 2.05 GUIDE/BUMP/SIDE RAILS. Provide rails per scale manufacturer's recommendations for landfill scale operations.
- PART 3 EXECUTION**
- 3.01 PREPARATION
- A. Apply for and obtain state permit as required under Iowa Code 215, Implemented by Iowa Administrative Code Chapter 85.
 - B. All blueprints of scales to be installed in the State of Iowa must first be approved by the Weights & Measures Bureau. Blueprints must include footing and foundation drawings with approval at least thirty-(30) days prior to construction and will be submitted to the State of Iowa, Weights & Measures Bureau per 215.14, Code of Iowa.
- 3.02 SCALE INSTALLATION
- A. Place concrete and reinforcement in accordance with the manufacturer's specifications.
 - B. Scale foundation construction shall comply with approved submittals.
 - C. Place bumper plates and fulcrums as designated on the manufacturer's drawings. Field bending, welding, or splicing is not permitted.
 - D. Mount the bumper bolt bracket such that the maximum distance between the striker plate on the pit wall and the point where the bumper bolt secures to the bracket is 3 in—cast the striker plate into the pit wall.
- 3.03 INSTRUMENTATION INSTALLATION
- A. Install interconnecting wiring between the scale and instrumentation in the existing scale house and between the scale and the remote displays provided by the owner.
 - B. Install interconnecting wiring between the intercom device located in the existing scale house and the mounted speaker.
 - C. Provide mounting poles and install existing Remote Displays (provided by the OWNER).
- 3.04 FIELD QUALITY CONTROL. Test vehicle scale in accordance with Iowa Code 215, Implemented by Iowa Administrative Code Chapter 85.
- 1.05 LIGHTNING PROTECTION SPECIFICATIONS
- A. A comprehensive lightning protection system shall be provided with the scale.
 - B. The system shall not require complicated wiring or devices to provide this protection.
 - C. Major scale components, including load cells, scale instrument and printer, shall be included in the lightning protection system.
 - D. Grounding of all scale components, including load cells, scale instrument, printer and accessories, shall be to one common point. Systems with multiple ground points are not acceptable.
 - E. An AC line surge protector shall conveniently plug into a common electrical outlet and have receptacles for the scale instrument, ticket printer and other scale accessories.
 - F. Each AC line surge protector required shall have one isolated grounding, hospital-grade duplex receptacles, and an internal 15-amp circuit breaker. Verification of the lightning protection system performance shall be available in writing from a third-party verification laboratory upon request.
 - G. The lightning protection system shall be of the same manufacturer as the scale.

3.06 WARRANTY REQUIREMENTS

- A. The scale manufacturer shall warrant the scale assembly, including all load cells, weighbridge structure, scale instruments, junction boxes, and associated cables, from failures due to a defect in manufacturing, workmanship, lightning, or surge voltages.
- B. The guarantee will warrant the product for 5 years from the date of installation or 62 months from the date of shipment to the OWNER, whichever occurs first. The CONTRACTOR shall promptly correct any such defect appearing within the warranty period.
- C. The guarantee shall support 100% coverage of repair parts, labor, travel time, and mileage from the closest service location or product replacement under warranty.
- D. A regular maintenance service program with the manufacturer and/or its local authorized representative is required. The level of service, to be determined at the time of sale, will depend upon the site and usage conditions but should comply with the guidelines set forth by the manufacturer, local regulations, and NIST Handbook 44.

* * * END OF SECTION * * *

Attachment C

INSURANCE SCHEDULE B - CONTRACTORS **(General, Artisan or Trade Contractors, Subcontractors or Sub Subcontractors)**

1. Contractor shall furnish a signed certificate of insurance to the Black Hawk County Solid Waste Management Commission (Commission) representative responsible for the contract for the coverage required in Exhibit I prior to commencing work. Contractors presenting annual certificates shall present a certificate at the end of each project with the final billing. Each certificate shall be prepared on the most current ACORD form approved by the Iowa Department of Insurance or an equivalent approved by the Commission's Administrator. The certificate must clearly indicate the project name or project description for which it is being provided Eg: Project name: Scale House Modification and Scale Replacement Project.
2. All policies of insurance required hereunder shall be with an insurer authorized to do business in Iowa and all insurers shall have a rating of A or better in the current A.M. Best's Rating Guide.
3. Each Certificate required shall be furnished to the Administrator of the Commission.
4. Failure to provide the coverages described in this Insurance Schedule shall not be deemed a waiver of these requirements by the Commission. Failure to obtain or maintain the required insurance shall be considered a material breach of this contract.
5. Contractor shall require all subcontractors and sub-subcontractors to obtain and maintain during the performance of work insurance for the coverages described in this Insurance Schedule and shall obtain certificates of insurance from all such subcontractors and sub-subcontractors. Contractor agrees that it shall be liable for the failure of a subcontractor and sub-subcontractor to obtain and maintain such coverage. The Commission may request a copy of such certificates from the Contractor.
6. All required endorsements to various policies shall be attached to the certificate of insurance.
7. Whenever an ISO form is referenced the current edition must be provided.
8. Contractor shall be required to carry the minimum coverage/limit, or greater if required by law or other legal agreement, in Exhibit I - Insurance Schedule B. If the contractor's limits of liability are higher than the required minimum limit then the contractor's limits shall be this agreement's required limits.

INSURANCE SCHEDULE B (continued)

EXHIBIT I

A) COMMERCIAL GENERAL LIABILITY

General Aggregate Limit	\$2,000,000
Products-Completed Operations Aggregate Limit	\$2,000,000
Personal and Advertising Injury Limit	\$1,000,000
Each Occurrence	\$1,000,000
Fire Damage Limit (any one occurrence)	\$50,000
Medical Payments	\$5,000

- 1) Coverage shall be written on an occurrence, not claims made, form. The general liability coverage shall be written in accord with ISO form CG0001 or business owners form BP0002. All deviations from the standard ISO commercial general liability form CG 0001 or business owners form BP 0002 shall be clearly identified.
- 2) Include ISO endorsement form CG 25 04 "Designated Location(s) General Aggregate Limit" or CG 25 03 "Designated Construction Project(s) General Aggregate Limit" as appropriate.
- 3) Include endorsement indicating that coverage is primary and non-contributory.
- 4) Include Preservation of Governmental Immunities Endorsement. (Sample attached).
- 5) Include additional insured endorsement for:
Black Hawk County Solid Waste Management Commission, including all its elected and appointed officials, all its employees and Waste Tech, Inc as Additional Insured when required in a written contract or agreement with respects to the General Liability policy. Use ISO form CG 20 10 (Ongoing operations) or its equivalent. Waiver of subrogation applies to the General Liability Policy per form CG2404.
- 6) The additional insured endorsement shall include completed operations under ISO form CG 2037 during the project term and for a period of two years after the completion of the project.
- 7) Policy shall include Waiver of Right to Recover from Others endorsement.
- 8) Provide to Commission a 30-day notice of coverage cancelation to Administrator of the Commission.

B) WORKERS' COMPENSATION & EMPLOYERS LIABILITY

Statutory Benefits covering all employees injured on the job by accident or disease as prescribed by Iowa Code Chapter 85.

Coverage A	Statutory—State of Iowa
Coverage B	Employers Liability
	Each Accident \$100,000
	Each Employee-Disease \$100,000
	Policy Limit-Disease \$500,000

Policy shall include Waiver of Right to Recover from Others endorsement.

Coverage B limits shall be greater if required by the umbrella/excess insurer.

Nonelection of Workers' Compensation or Employers' Liability Coverage under Iowa Code sec. 87.22

 yes form attached

C) AUTOMOBILE LIABILITY

Combined Single Limit \$1,000,000

D) UMBRELLA/EXCESS LIABILITY

 \$1,000,000

PRESERVATION OF GOVERNMENTAL IMMUNITIES ENDORSEMENT

1. Nonwaiver of Governmental Immunity. The insurer expressly agrees and states that the purchase of this policy and the including of the Black Hawk County Solid Waste Management Commission as an Additional Insured does not waive any of the defenses of governmental immunity available to the Black Hawk County Solid Waste Management Commission, Iowa under Code of Iowa Section 670.4 as it now exists and as it may be amended from time to time.
2. Claims Coverage. The insurer further agrees that this policy of insurance shall cover only those claims not subject to the defense of governmental immunity under the Code of Iowa Section 670.4 as it now exists and as it may be amended from time to time. Those claims not subject to Code of Iowa Section 670.4 shall be covered by the terms and conditions of this insurance policy.
3. Assertion of Government Immunity. The Black Hawk County Solid Waste Management Commission shall be responsible for asserting any defense of governmental immunity, and may do so at any time and shall do so upon the timely written request of the insurer.
4. Non-Denial of Coverage. The insurer shall not deny coverage under this policy and the insurer shall not deny any of the rights and benefits accruing to the Black Hawk County Solid Waste Management Commission under this policy for reasons of governmental immunity unless and until a court of competent jurisdiction has ruled in favor of the defense(s) of governmental immunity asserted by the Black Hawk County Solid Waste Management Commission.

No Other Change in Policy. The above preservation of governmental immunities shall not otherwise change or alter the coverage available under the policy.

SPECIMEN

Attachment D

Proposal Form

The bidder hereby certifies that they are the only person or persons interested in this proposal as principals; that an examination has been made of the plans, specifications, and contract form, including the special provision contained herein, and of the site of the work, and the bidder understands that the quantities of work shown herein are approximate only and are subject to increase or decrease; and further understand that all quantities of work, whether increased or decreased, are to be performed at the unit price as stipulated herein; the bidder proposes to furnish all necessary machinery, equipment, tools, labor and other means of Construction, and to furnish all materials specified in the manner and time prescribed and to do the work at the prices herein set out.

Accompanying this proposal in a separate envelope is a cashier's or certified check payable to the Black Hawk County Solid Waste Management Commission, drawn on a bank in Iowa or a bank chartered under the laws of the United States, in the amount of ten percent (10%) of the bid submitted; or a bid bond in the penal sum of ten percent (10%) of the bid submitted executed by the bidder and an acceptable Corporate Surety. It is understood that this proposal guarantee will be retained in the event the formal contract or bond is not executed if the award is made to the undersigned.

The bidder further agrees to execute a formal contract and bond, if required by the contract documents, within seven (7) days of the award of the contract by the Commission and that they will commence work on or about ten (10) days after the date of the contract, and will complete the work within the specified contract period or pay the liquidated damages stipulated in the contract documents.

Bidder acknowledges receipt of the following addendums:

Date	Addendum No.

The bidder shall provide a price for all items with an alternative bid. Otherwise, the Bid will be REJECTED.
The following are fees proposed by the Contractor for the individual work areas; these items may be adjusted during the Project as the design is completed with the overall Project price remaining under the Proposed Bid total. The bidder will complete the work for the following prices:

Base Bid

Item No.	Design Services and Scale Replacement Scope Fees	Total Amount
1.1	Design Services and Bid Services	\$
1.2	Construction Management Services	\$
1.3	Scale Removal, including Foundation Demolition and Catwalk Removal	\$
1.4	Purchase, Permitting and Installation of New Scale	\$
1.5	Concrete Foundation and Approach Modification	\$
1.6	Installation of Bollards or Fall Protection Guards	\$
1.7	Electrical Relocation (Lights, Gate Opener, Etc.)	\$
1.8	Electronics, Wiring, and System Demonstration	\$
1.9	Other (Identify):	\$
BASE BID SUB-TOTAL		\$

Bid Package No. 1 – Scale Remodel (Utilizing Existing Structure)

Item No.	Scale House Remodel Scope Fees	Total Amount
2.1	Demolition	\$
2.2	Structural Steel or Framing	\$
2.3	Roofing System Modification	\$
2.4	Electrical and Communications Work	\$
2.5	Interior Finishing	\$
2.6	Exterior Finish (Windows, Siding, Etc.)	\$
2.7	Other (Identify):	\$
REMODEL BID SUB-TOTAL		\$

Bid Package No. 2 – Scale Addition (Demolition of the existing vestibule and construction an addition)

Item No.	Design Services and Scale Replacement Scope Fees	Total Amount
3.1	Demolition	\$
3.2	Foundation and Concrete Work	\$
3.3	Structural Steel or Framing	\$
3.4	Roofing System Modification	\$
3.5	Electrical and Communications Work	\$
3.6	Interior Finishing	\$
3.7	Exterior Finishing	\$
3.8	Other (Identify):	\$
SCALE ADDITION BID SUB-TOTAL		\$

Project Total Proposed Cost:

Scale House Remodel and Scale Replacement \$ _____
 (Base plus bid package #1)

Scale House Addition and Scale Replacement \$ _____
 (Base plus bid package #2)

Business Name of Bidder: _____

Bidder's Official Address: _____

City: _____, State: _____ Zip: _____

Signed by _____

Print Name _____

Title: _____

Date: _____, 2025

BID BOND

KNOWN ALL MEN BY THESE PRESENTS, that we _____ as Principal (Contractor), and _____, as Surety, are held and firmly bound unto the Black Hawk County Solid Waste Management Commission, in the penal sum of _____ in lawful money of the United States, for the payment of which sum well and truly to be made, we bind ourselves, our heirs, executors, administrators, and successors, jointly and severally, firmly by these presents. The condition of this obligation is such that whereas the Principal has submitted the accompanying bid, dated _____ day of _____, 2025, for the Landfill Scale House Remodel and Scale Replacement Project.

NOW, THEREFORE, if the Principal shall not withdraw said bid within the period specified therein during the opening of same, or if no period specified, within thirty (30) days after said opening, and shall within the period specified therefore, if no period be specified, within seven (7) days after the prescribed forms are presented to him for signature, enter into a written contract with the municipality, in accordance with the bid as accepted, and give bond with good and sufficient surety or sureties, as may be required for the faithful performance and proper fulfillment of such contract, then the above obligation shall be void and of no effect, otherwise to remain in full force and virtue.

By virtue of statutory authority, the full amount of this bid bond shall be forfeited to the municipality in liquidations of damages sustained in the event that the aforementioned described bidder, Principal, fails to execute the contract and provide the bond as provided in the specifications or by law.

IN WITNESS WHEREOF, the above bounden parties have executed this instrument under their several seals this _____ day of _____, 2025, the name and corporate seal of each corporate party being hereto affixed and these presents duly signed by its undersigned representative pursuant to authority of its governing body.

PRINCIPAL

Contractor

By: _____
Signature

Title

Date

SURETY

Surety Company

By: _____
Signature

Title

Date

**BLACK HAWK COUNTY SOLID WASTE MANAGEMENT COMMISSION
IMPROVEMENT CONTRACT**

THIS IMPROVEMENT CONTRACT (the Contract), made in triplicate, dated for reference purposes on the _____ day of January 2025, between the Black Hawk County Solid Waste Commission (Owner) and _____ (Contractor)

For and in consideration of the mutual covenants herein contained, the parties hereto agree as follows:

CONTRACTOR AGREES:

1. To furnish all material and equipment and to perform all labor necessary for the Landfill Scale House Remodel and Scale Replacement Project (the Project). The Project shall be made in strict accordance with the requirements of the laws of the State of Iowa and in accordance with the Contract Document shall of which provisions and documents are each and all hereby referred to and made a part of this Contract just as much as if the detail statements thereof were repeated herein.
2. Contract Documents shall mean and include the following: All ordinances and resolutions heretofore adopted by Owner having to do with the Project; the Notice to Bidders; the Contractor's Proposal; and the Plans, Specifications, and General Requirements as adopted by for the Project.
3. All materials used by the Contractor in the Project shall be the best of their several kinds and shall be put in place to the satisfaction of the Owner.
4. The Contractor shall remove any materials rejected by the Owner as defective or improper, or any of said work condemned as unsuitable or defective, and the same shall be replaced or done anew to the satisfaction of the Owner at the cost and expense of the Contractor.
5. Five percent (5%) of the Contract price shall be retained by the Owner for a period of thirty (30) days after final completion and acceptance of the Project by Owner to pay any claim that may be filed within said time for labor and materials done and furnished in connection with the performance of this Contract and for a longer period if such claims are not adjusted within that time, as provided in Iowa Code Chapter 573. The Owner shall also retain additional sums to protect itself against any claim that has been filed against it for damages to persons or property arising through the prosecution of the work and such sums shall be held by the Owner until such claims have been settled, adjudicated or otherwise disposed of.
6. The Contractor has read and understands the specifications including General Requirements and has examined and understands the plans herein referred to and agrees not to plead misunderstanding or deception because of estimates of quantity, character, location or other conditions surrounding the same.
7. In addition to the guarantee provided for in the specifications, the Contractor shall also make good any other defect in any part of the Project due to improper construction notwithstanding the fact that said Project may have been accepted and fully paid for by the Owner, and the Contractor's bond shall be security therefore.
8. To the fullest extent permitted by law, the Contractor shall indemnify and hold harmless the Owner from and against all claims, damages, losses and expenses, including but not limited to attorney fees, arising out of or resulting from performance of the Contract, provided that such claim, damages, loss or expense is attributable to bodily injury, sickness, disease or death, or injury to or destruction of property (other than the Project itself) including loss of use resulting there from, but only to the extent caused in whole or in part by negligent acts or omissions of the Contractor, the Contractor's subcontractor, or anyone directly or indirectly employed by the Contractor or the Contractor's subcontractor or anyone for whose acts the Contractor or the Contractor's subcontractor may be liable, regardless of whether or not such claim, damage, loss or expense is caused in part by a party indemnified hereunder.

THE BLACK HAWK COUNTY SOLID WASTE MANAGEMENT COMMISSION AGREES:

Upon the completion of the Contract, and the acceptance of the Project by Owner agrees to pay the Contractor as full compensation for the complete performance of this Contract, the amount determined for the total number of units completed at the unit prices stated in the Contractor's Proposal and less any liquidated damages

provided for in the Contract Documents. The number of units stated in the plans and specifications is approximate only, and the work covered by the Contract shall be the final payment.

CONTRACT AMOUNT \$ _____ (Insert Contract Amount)

FURTHER CONDITIONS

The Contractor hereby represents and guarantees that it has not, nor has any other person for or in its behalf, directly or indirectly, entered into any arrangement or agreement with any other bidder or with any public officer whereby it has paid or is to pay any other bidder or public officer any sum of money or anything of value whatever in order to obtain this Contract. It has not, nor has another person for or in its behalf directly or indirectly, entered into any agreement or arrangement with any other person, firm, corporation or association which tends to or does lessen or destroy free competition in the letting of this Contract and agrees that in case it hereafter be established that such representations or guarantees, or any of them are false, it will forfeit and pay not less than ten percent (10%) of the Contract price but in no event be less than \$ _____ (_____ Dollars) as liquidated damages to Owner.

The surety on the bond furnished for this Contract shall, in addition to all other provisions, be obligated to the extent provided for by Iowa Code § 573.6, relating to this Contract, which provisions apply to said bond.

The Contractor agrees, and its bond shall be surety, that it will keep and maintain the Project in good repair for two years after the Commission accepts it.

The Contractor agrees, and its bond shall be surety, that it will keep and maintain the Project in good repair for two years after the Commission accepts it.

**BLACK HAWK COUNTY SOLID WASTE
MANAGEMENT COMMISSION**

By: _____
Brian Heath, Chairperson

Attest: _____
John A. Foster, Administrator

CONTRACTOR

By: _____

Name: _____

Attest: _____

Name: _____

PERFORMANCE, PAYMENT AND MAINTENANCE BOND

KNOWN ALL MEN BY THESE PRESENTS: That (Insert Contractor's Name) as Principal (Contractor) and _____ as Surety are held firmly bound unto the Black Hawk County Solid Waste Management Commission (Owner), in the penal sum of \$ _____ (Insert Contract Amount) the same being 100% of the total price of the Contract for the Project herein referred to, lawful money of the United States of America, well and truly to be paid to said Owner, and to all other parties who, under the provisions of the laws of Iowa, are intended to be protected and secured hereby for which payment we bind ourselves, our heirs, executors, successors and assigns, jointly and severally by these presents.

Dated at Waterloo, Iowa, this _____ day of _____, 2025, and duly attested and sealed.

WHEREAS, the said Contractor by a Contract dated (_____, 2025), incorporated herein by reference, has agreed with said Owner to perform all labor and furnish all materials required to be performed and furnished for the Landfill Scale House Remodel and Scale Replacement Project (the Project) according to the Contract and Construction Documents prepared therefore.

It is expressly understood and agreed by the Contractor and Surety bond that the following provisions are a part of this Bond and are binding upon said Contractor and Surety, to-wit:

1. **PERFORMANCE BOND:** The Contractor shall well and faithfully observe, perform, fulfill and abide by each and every covenant, condition and part of said Contract and Contract Documents, by reference made a part hereof, for the Project, and shall indemnify and save harmless the Owner from all outlay and expense incurred by the Owner by reason of the Contractor's default of failure to perform as required. The Contractor shall also be responsible for the default or failure to perform as required under the Contract and Contract Documents by all its subcontractors, suppliers, agents, or employees furnishing materials or providing labor in the performance of the Contract.
2. **PAYMENT BOND:** The Contractor and the Surety shall pay all just claims submitted by persons, firms, subcontractors, and corporations furnishing materials for or performing labor in the performance of the Contract on account of which this Bond is given, including but not limited to claims for all amounts due for labor, materials, lubricants, oil, gasoline, repairs on machinery, equipment and tools, consumed or used by the Contractor or any subcontractor, wherein the same are not satisfied out of the portion of the contract price which the Owner is required to retain until completion of the improvement, but the Contractor and Surety shall not be liable to said persons, firms, or corporations unless the claims of said claimants against said portion of the Contract price shall have been established as provided by law. The Contractor and Surety hereby bind themselves to the obligations and conditions set forth in Chapter 573, Code of Iowa, which by this reference is made a part hereof as though fully set out herein.
3. **MAINTENANCE BOND:** The Contractor and the Surety hereby agree, at their own expense:
 - A. To remedy any and all defects that may develop in or result from work to be performed under the Contract within the period of two (2) year(s) from the date of acceptance of the work under the Contract by Owner, by reason of defects in workmanship or materials used in construction of said work;
 - B. To keep all work in continuous good repair; and
 - C. To pay the Owner the reasonable costs of monitoring and inspection to assure that any defects are remedied, and to repay Owner all outlay and expense incurred as a result of Contractor's and Surety's failure to remedy any defect as required by this section.

Contractor's and Surety's agreement herein made extends to defects in workmanship or materials not discovered or known to the Owner at the time such work was accepted.

NOW, THEREFORE, the condition of this obligation is such that if the said Contractor shall perform all of the work contemplated by the Contract in a workmanlike manner and in strict compliance with the plans and specifications, and will pay all claims for labor and materials used in connection with said Project, to indemnify the said Owner for all damages, costs and expense incurred by reason of damages to persons or property arising through the performance of said Contract, and will reimburse the Owner for any outlay of money which it may be required to make in order to complete said Contract according to the Construction Documents and will maintain in good repair said Project for the period specified in the Contract where this bond is obligated for maintenance, and will faithfully comply with all of the provisions of Section 573 of the Code of Iowa, then this obligation shall be null and void, otherwise it shall remain in full force and effect.

All the conditions of this bond must be fully complied with before the Contractor or the Surety will be released.

The Contract, Contractor's Proposal, and Construction Documents shall be considered as a part of this Bond just as if their terms were repeated herein.

Dated at Waterloo, Iowa this _____ day of January, 2025.

Owner

By: _____
Chairman

PRINCIPAL

Contractor

By: _____
Signature

Title

SURETY

Surety Company

By: _____
Signature

Title

City, State, Zip Code

Telephone

Attorney In Fact

